



SCHROEFAS MACH.  $700 \times 1080 \times 1850$   
1300

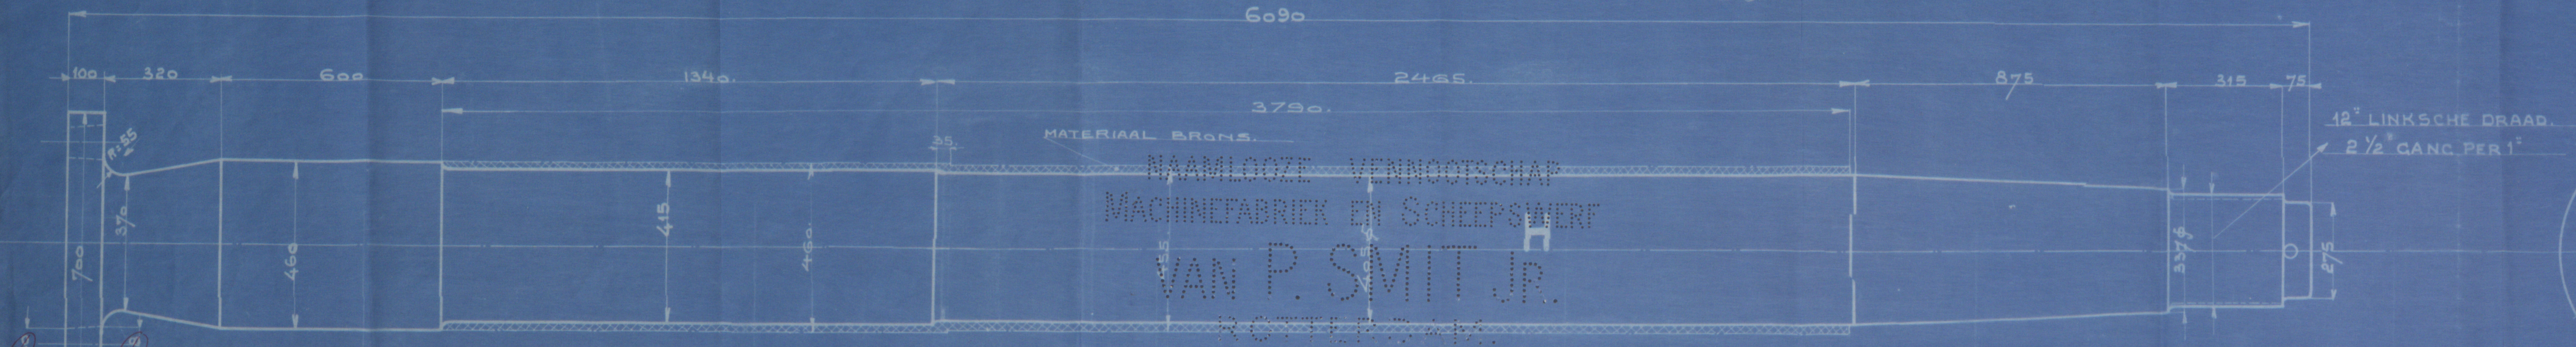

*Diameter of coupling bolts at the joining faces to be not less than 86 mm.*

BLAD 67 MAP N° 71.

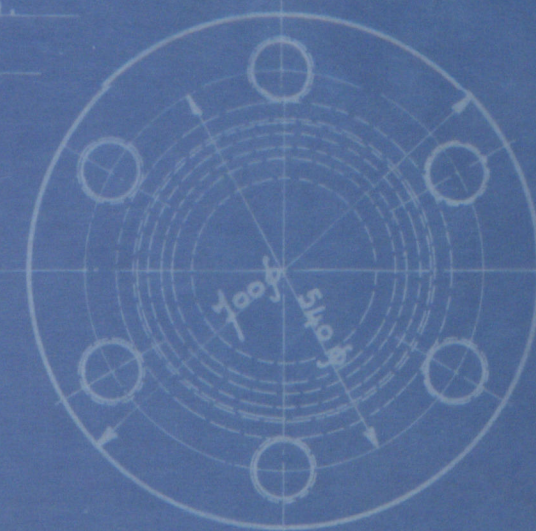

*G.R.B.  
27/5/20*

W 387 - 0374



© 2019

Lloyd's Register  
Foundation

MACH. N° 558.



Plan of Shafting

Messrs. P. Smit Jrs

Eng. N<sup>o</sup> 350

S/s no. 375

"Camaplein"  
Rot. 16019

~~GEN. BOX NO 498~~

W387-0374



© 2019

Lloyd's Register  
Foundation