

Nº 530 "JOHNSON" BOILER.

S.O. 55/27.

W. T. BOILER.


SUPERHEATER TUBES.

SCALE $1\frac{1}{2}'' = 1\text{ FOOT.}$

From Lloyd's
17/2/28
Nº 530 - 21/1/29

Board of Trade
24/4/28
16/12/29

Nº 333

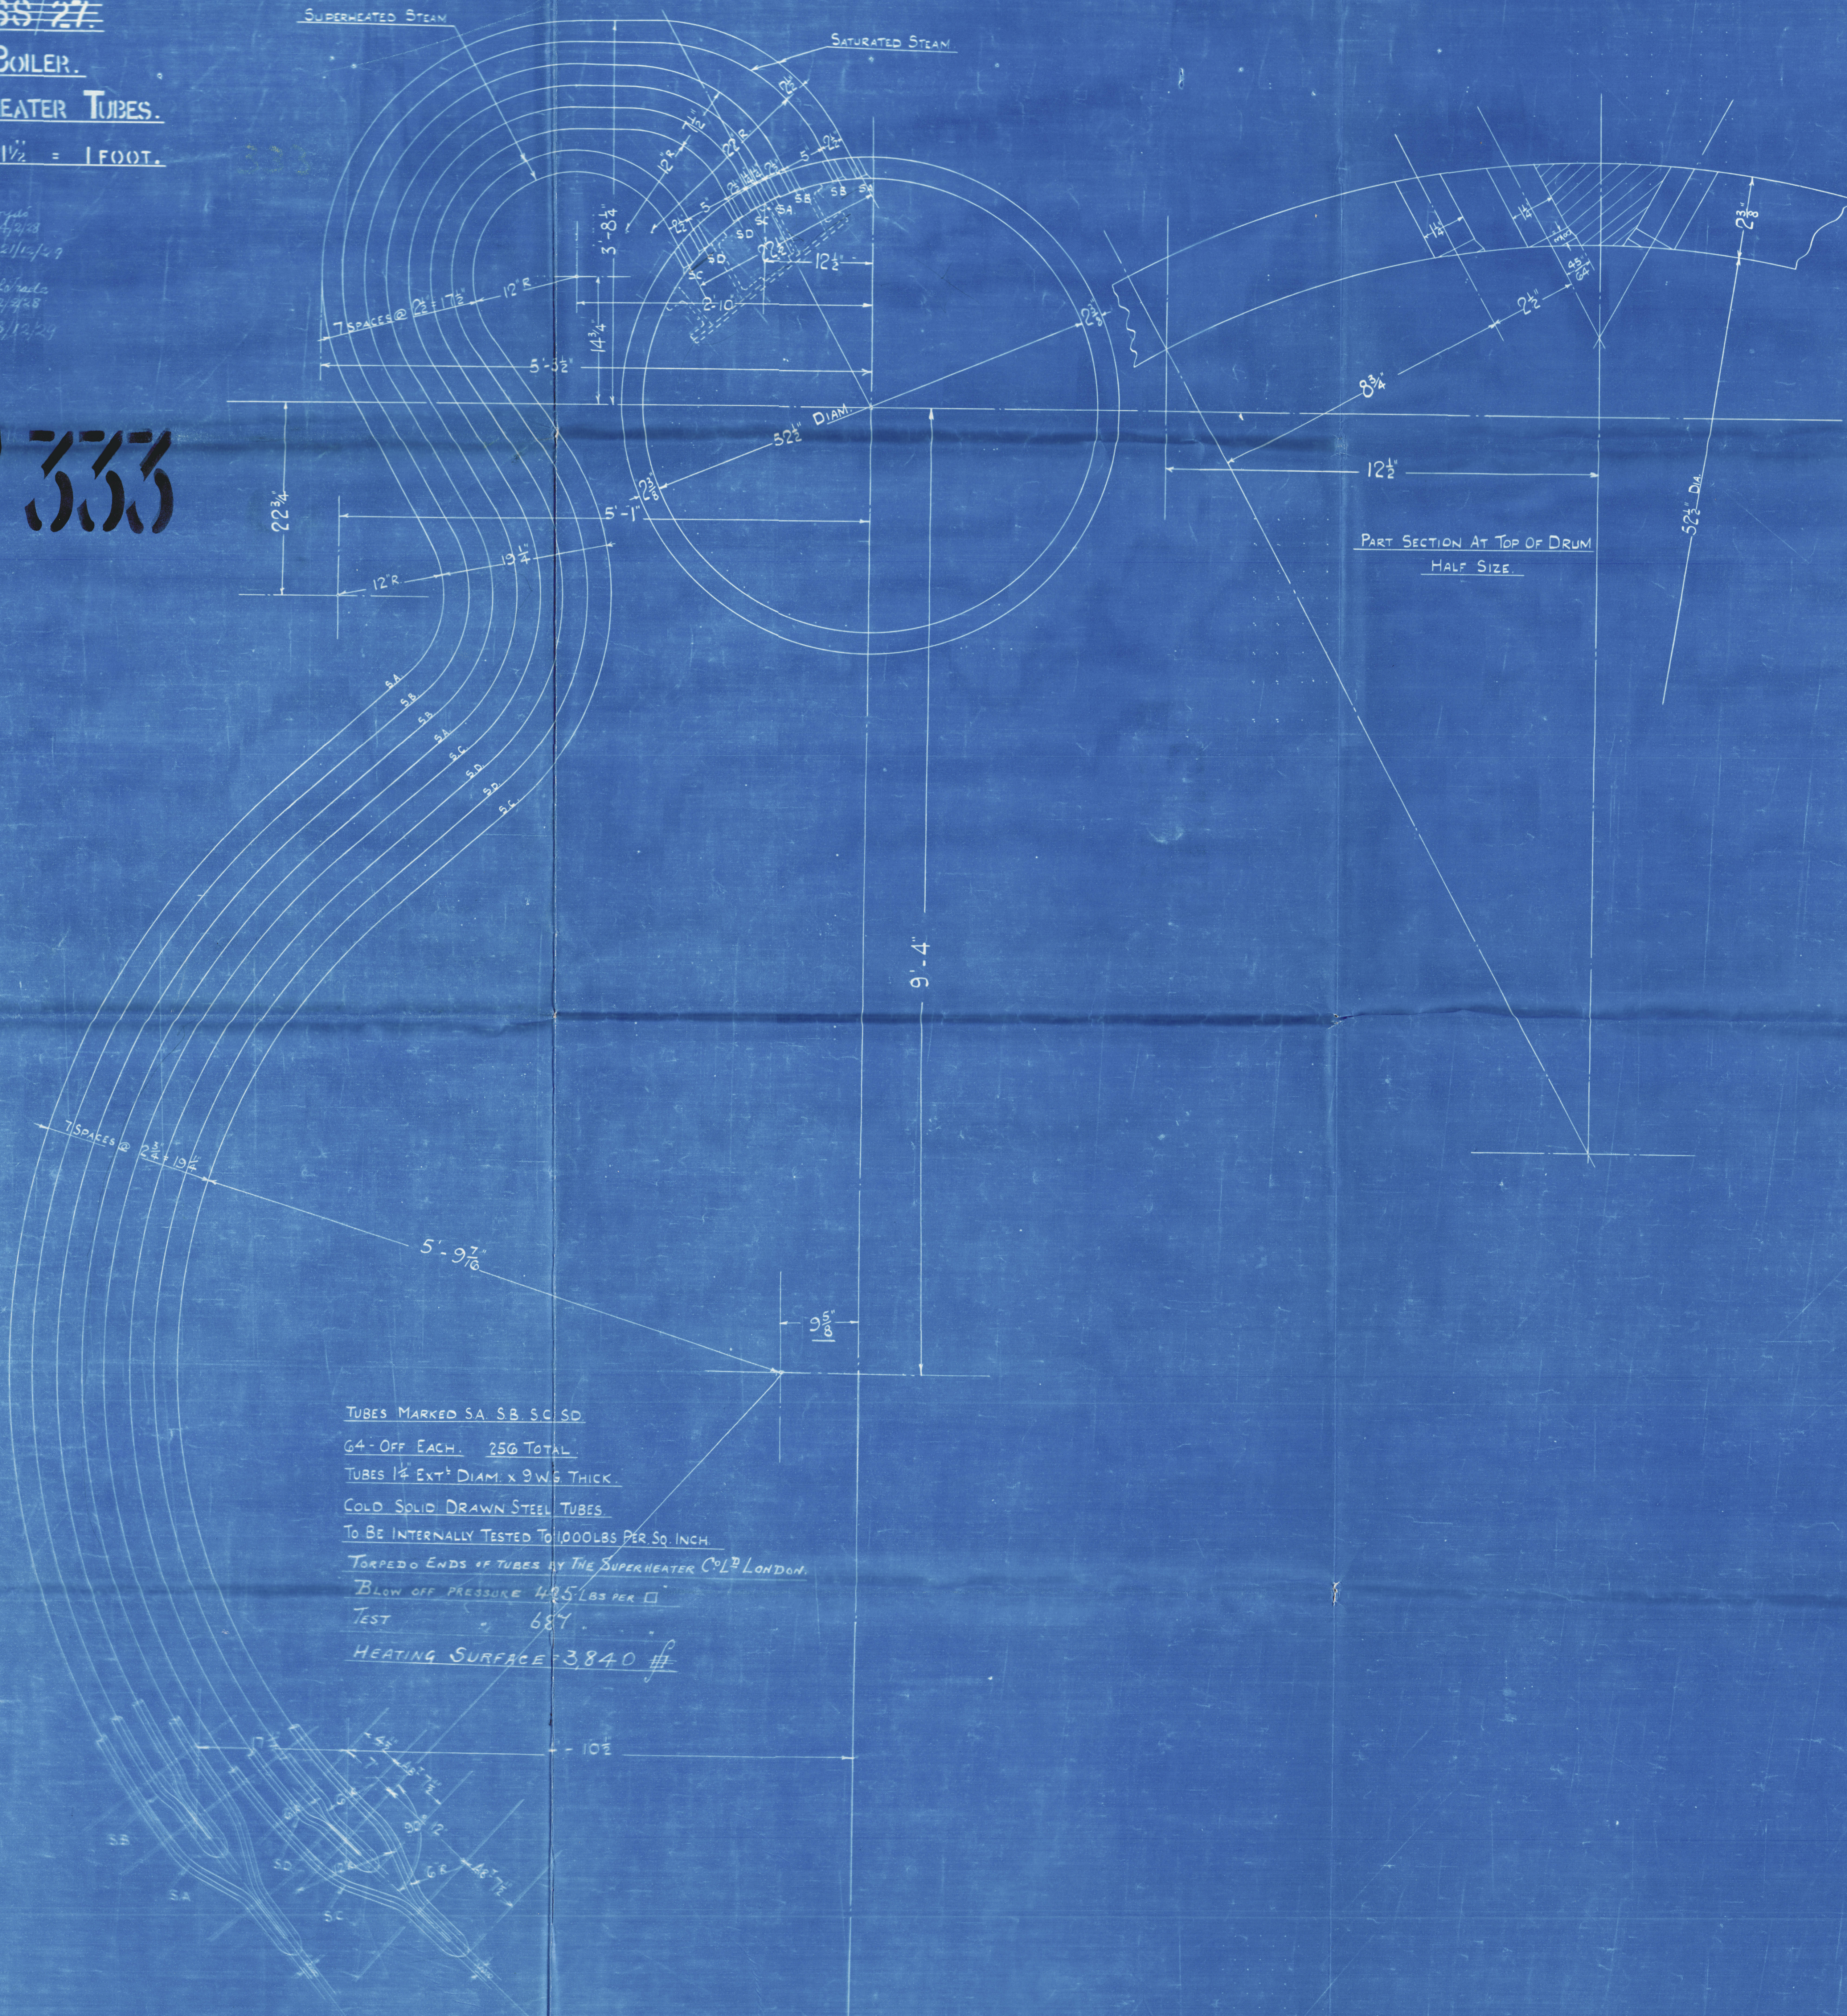

TUBES MARKED SA, SB, SC, SD.
64" OFF EACH. 256 TOTAL.
COLD SPOOL DRAWN STEEL TUBES.
TO BE INTERNALLY TESTED TO 10,000 LBS PER SQ. INCH.
TORPEDO ENDS OF TUBES BY THE SUPERHEATER CO. L^{td} LONDON.
TEST 684.
HEATING SURFACE 3,840 sq. ft.

530/D 162 3/2020

Lloyd's Register
Foundation
W392-0104

John Brown & Co. Ltd.,

No. 530.

"Johnson" Boiler — Ex Blr. No. S.C. 88/27.
W. J. Boiler — Superheater Tubes.

"Empress of Britain".

GLASGOW REPORT No. 51410

BOX NO.

6

PLAN NO.

64

RETAIN



© 2020

Lloyd's Register
Foundation

W392-0104