

S. S. RIOL

MIDSHIP SECTION


SCALE 1/4" = 1 FOOT

SCANTLINGS OF SHELL & ARE APPROXIMATE AS
NO DRILLINGS WERE TAKEN

REG. DIMⁿ 420.5 x 54.5 x 27.9

D.M. 30-9 (MEASURED AFLOAT)

Forecastle 8" beam 9 1/2" x 11" x 5/8" dia.
But 8" wood planked

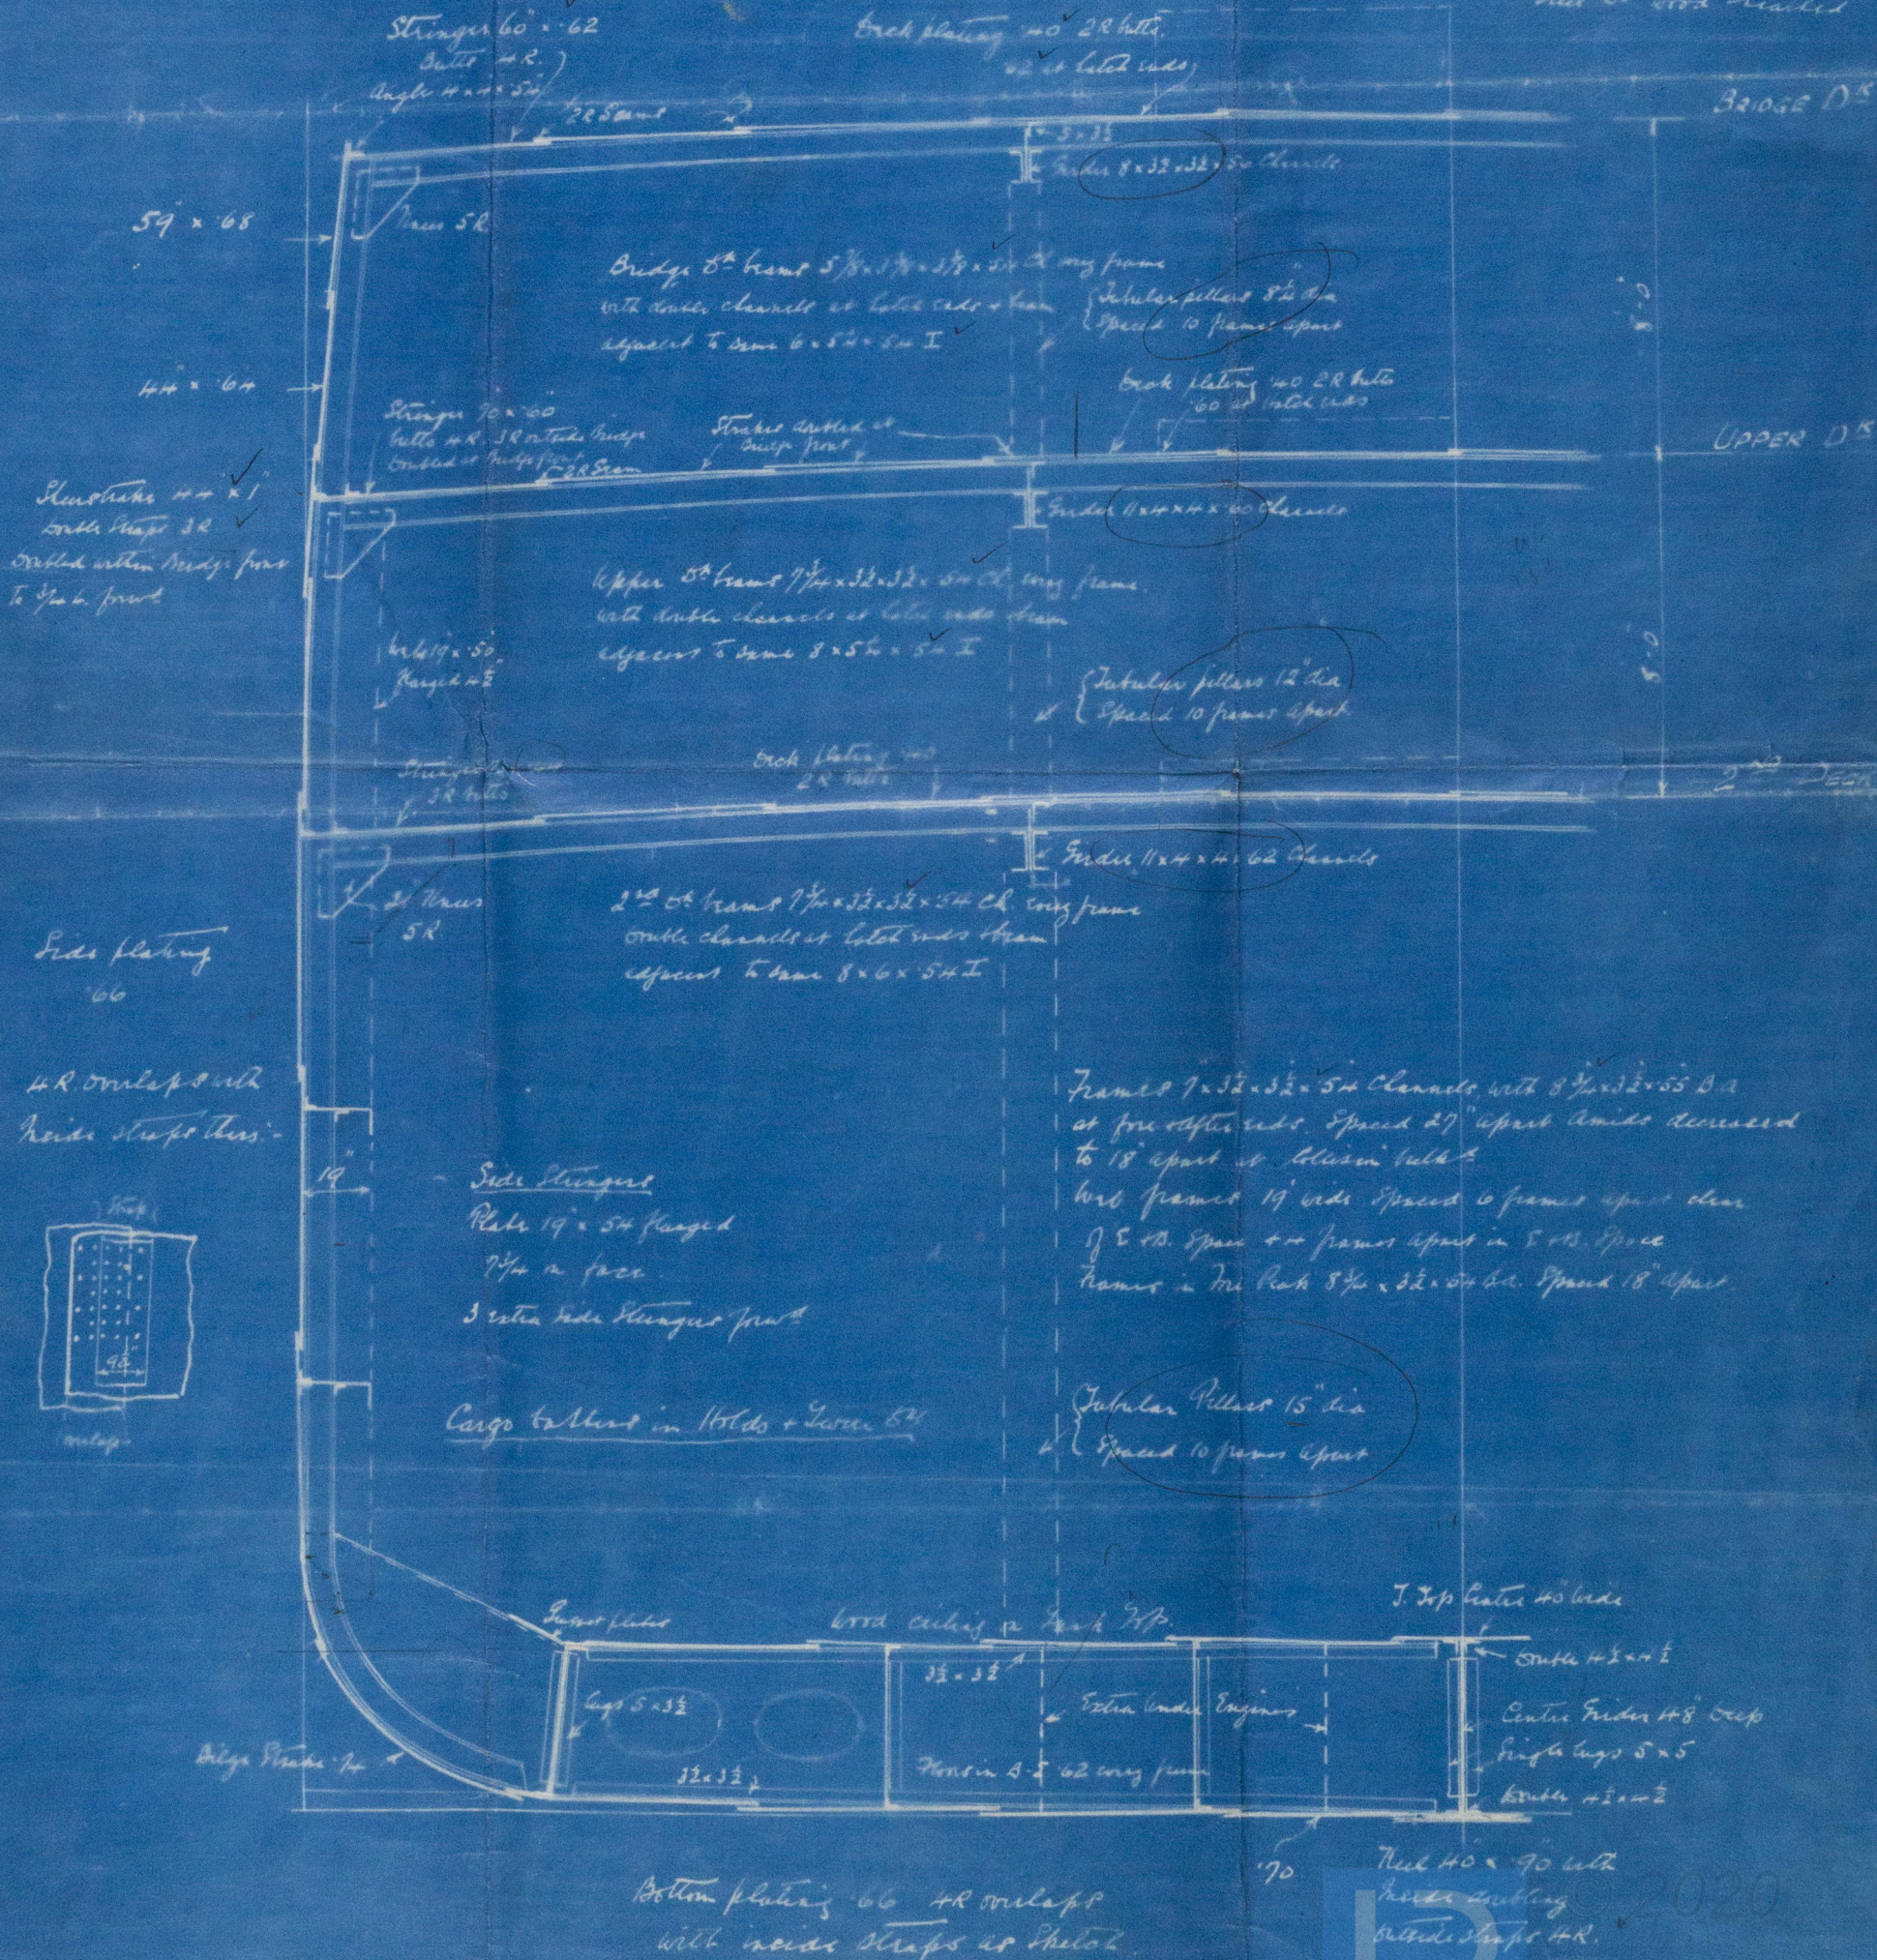

now named "Furcrest"


Bot. 16 7/14

ex
Midship Section

8/5 Peraclovic

RETAIN

W394-0095 2020

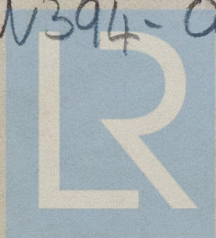

Lloyd's Register
Foundation