

19.8.14


5 1/2
3 1/2
70
40
20
5
6
4 1/2

PROFILE & DECK PLAN. S.S. N° 175.


180' x 30' x 13'-9" M^{LD}.

TO BE CLASSED 100 A1 AT LLOYDS' AND BE BUILT UNDER SPECIAL SURVEY

SCALE 1/8" = ONE FOOT

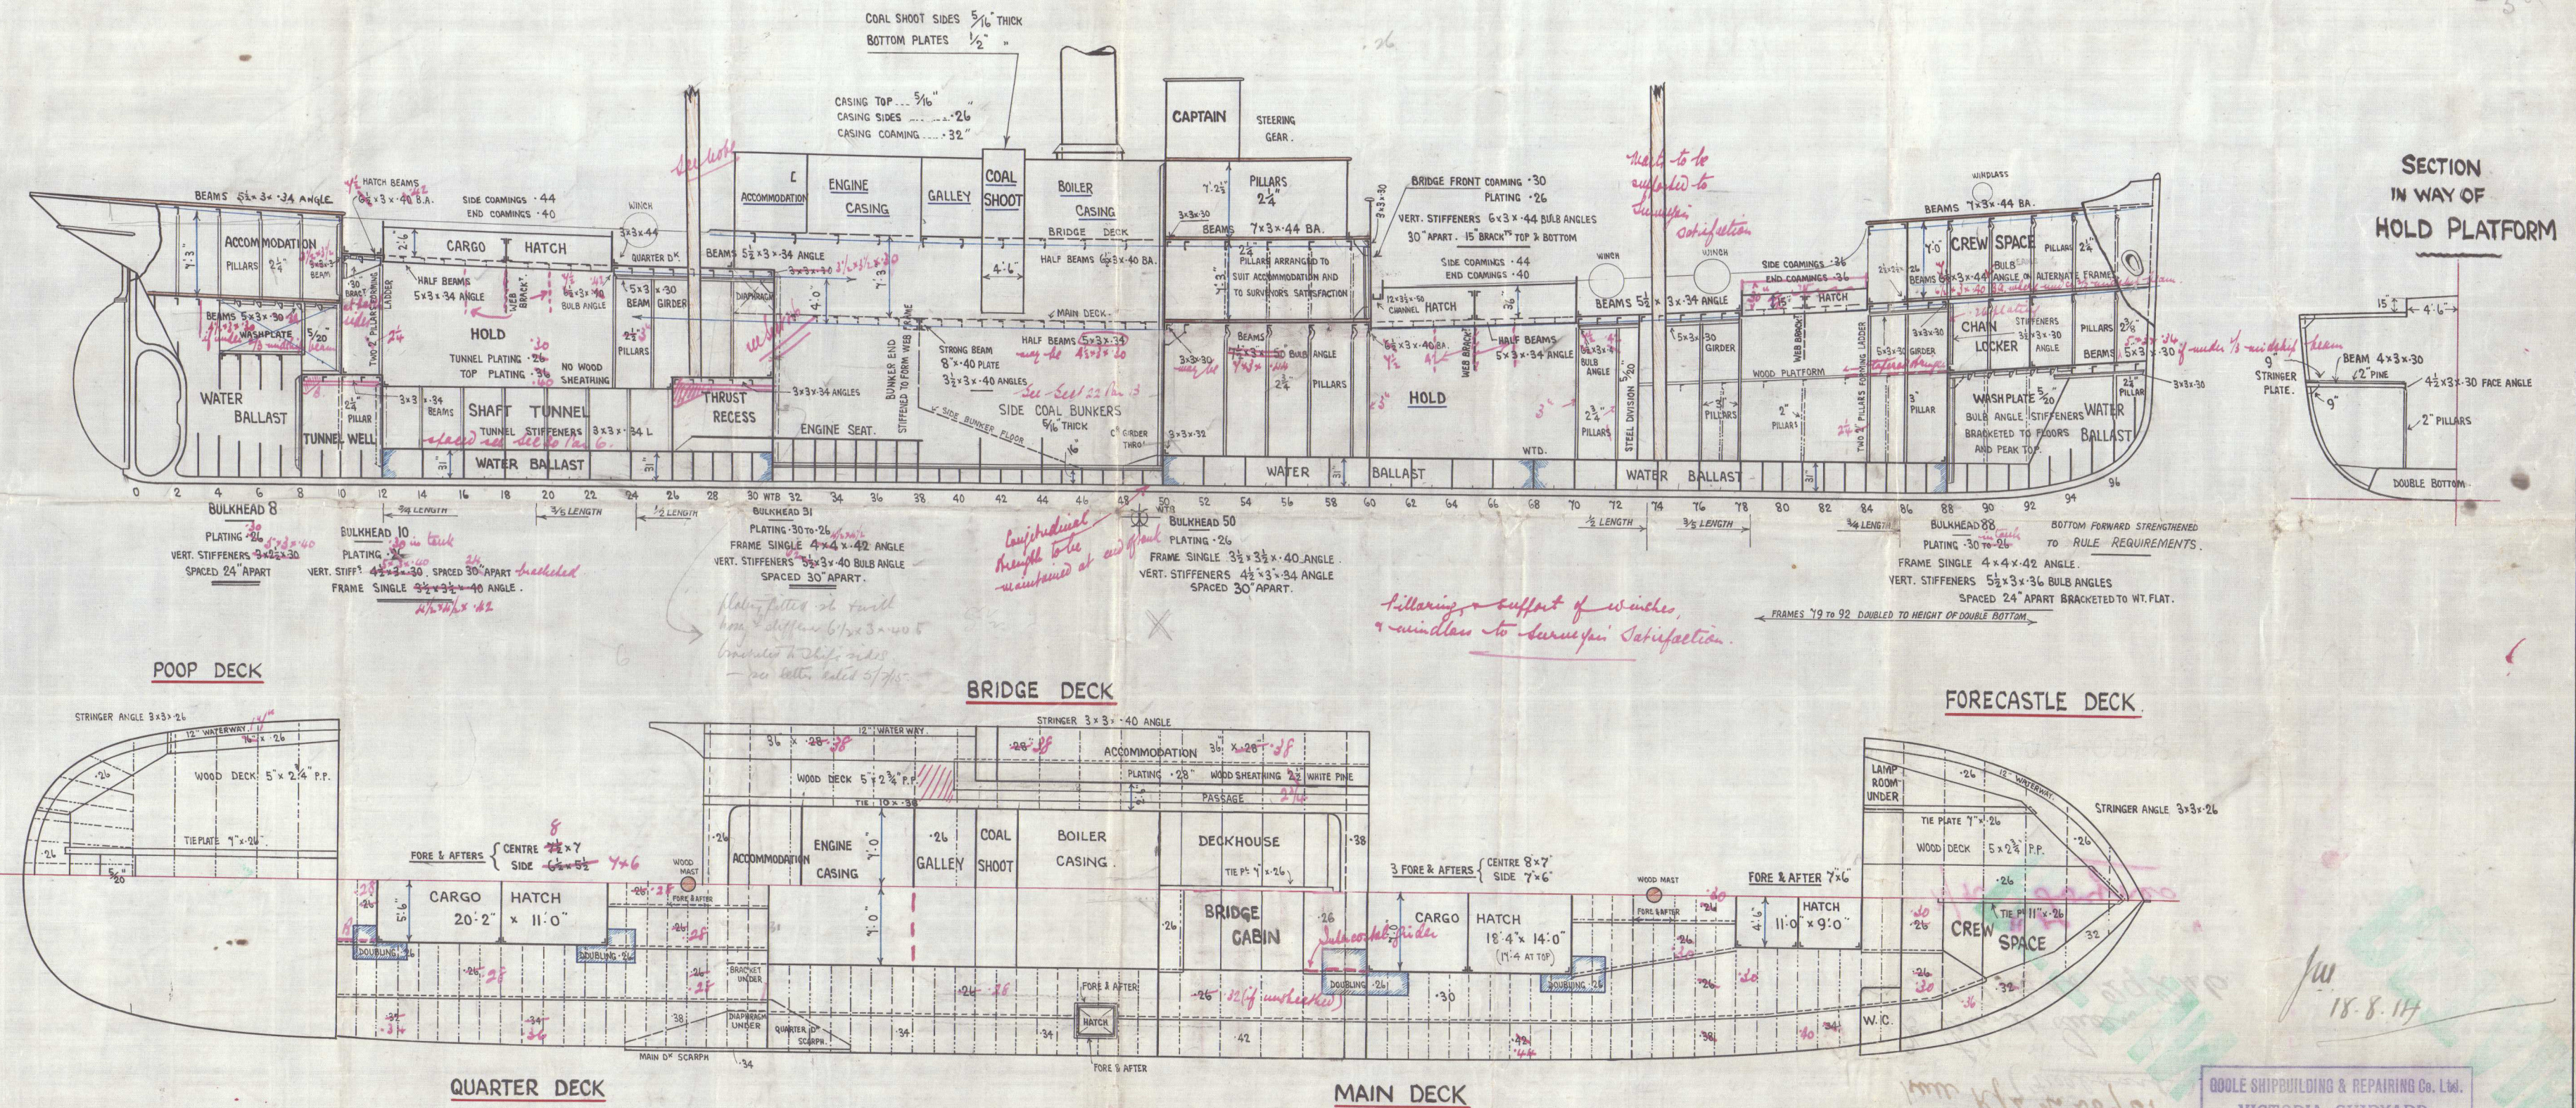

GOOLE SHIPBUILDING & REPAIRING Co. Ltd.
VICTORIA SHIPYARD,
GOOLE.
Drawing No. 454
Made by @. Checked by H.C.
Date 13/8/14 2020

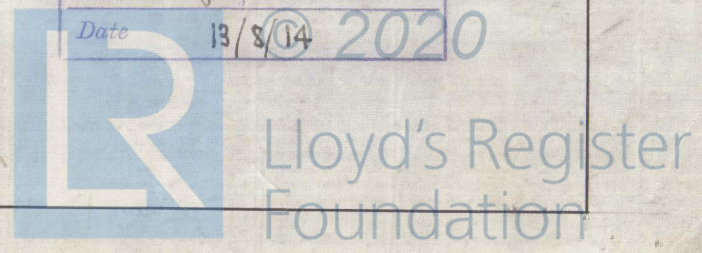

W394 - 0248

Goats & Rels
No 175

Profile & Dr.

Island Queen
s/s Southern Island
Hull Rft 28981
(Freeboard)

Island Queen
Hull Rft no 29246.

n/n "Loynes"

W394-0248





© 2020

Lloyd's Register
Foundation