

Copy
Lloyds Register
8/12/26

PROFILE N^o 277.


SCALE $\frac{1}{8}$ " = ONE FOOT

DIMENSIONS
LENGTH B.P. ----- 365'-0"
BREADTH EXT. ----- 51'-6"
DEPTH MLD (SECOND DK) --- 27'-6"
" " (SUPERST DK) --- 35'-0"

WINDLASS, WINCHES STEERING GEAR ETC.
SUPPORTED TO SURVEYORS SATISFACTION.

SIR JOHN PRIESTMAN & CO
Shipbuilders,
SUNDERLAND. 6/12/26

FORECASTLE SCANTLINGS.
BEAMS (SEE DECK PLAN) ALT^R FRAMES, 2 ROWS PILLARS
STRINGER PLATE 34" x 34", DECK PLATING 30TK, SHEATHING 22" P.P.
STRINGER ANGLE 35" x 35" x 34", SIDE PLATING 40" TK.
BUTTS OF DECK, & SIDE PLATING SINGLE RIVETED.

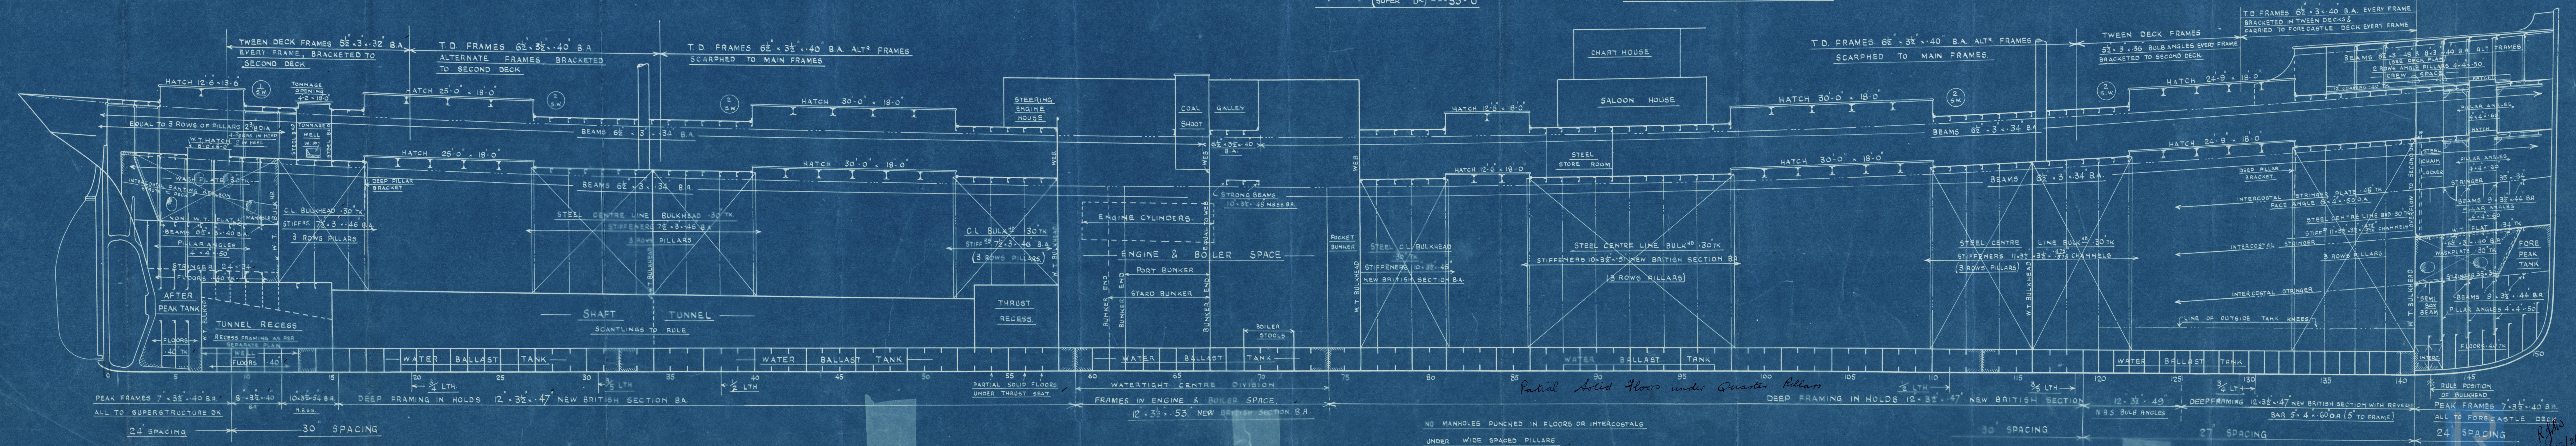

SUNDERLAND

PROFILE PLAN

S.S. NO 277.

(AS BUILT)

SIR J PRIESTMAN S.

"Francis Massey"

SUNDERLAND DPT. NO. 29514.

RETAIN



© 2019

Lloyd's Register
Foundation

W315-0062