

572 + 573

Midship Section

Civ. Semmell

Fleming - Rpt. No.

Capel - " " -

572.

S.S.

Fleming

HULL REPORT No.

39590.

RETAIN



© 2019

Lloyd's Register
Foundation

W395

—≡ N^{OS} 512 & 13. ≡—
MIDSHIP SECTION.

— SCALE $\frac{1}{2}'' = 1 \text{ FOOT}$ —

EQUIPMENT


1	STOCKLESS ANCHOR	8 1/4 CWTs
1	" "	7 1/2 "
1	RODGERS	3 1/4 " E STOCK.
120	FATHOMS 1 1/8" STUD LINK CABLE.	
60	" 6" HAWSER.	
60	" 5" WARP.	

DIMENSIONS: ~ 140'-0" B.P. x 24'-0" Ex. x 14'-0" MLD.

CLASS 100. A. 1. STEEL STEAM TRAWLER.

LLOYDS NUMERALS

$L \times D$	1960
$L \times (B + D)$	5301.8
D	14 0
$B + D$	37.87
PROPORTIONS { $\frac{D}{B}$	10
{ $\frac{B}{D}$	5.86
{ "3"	12.58

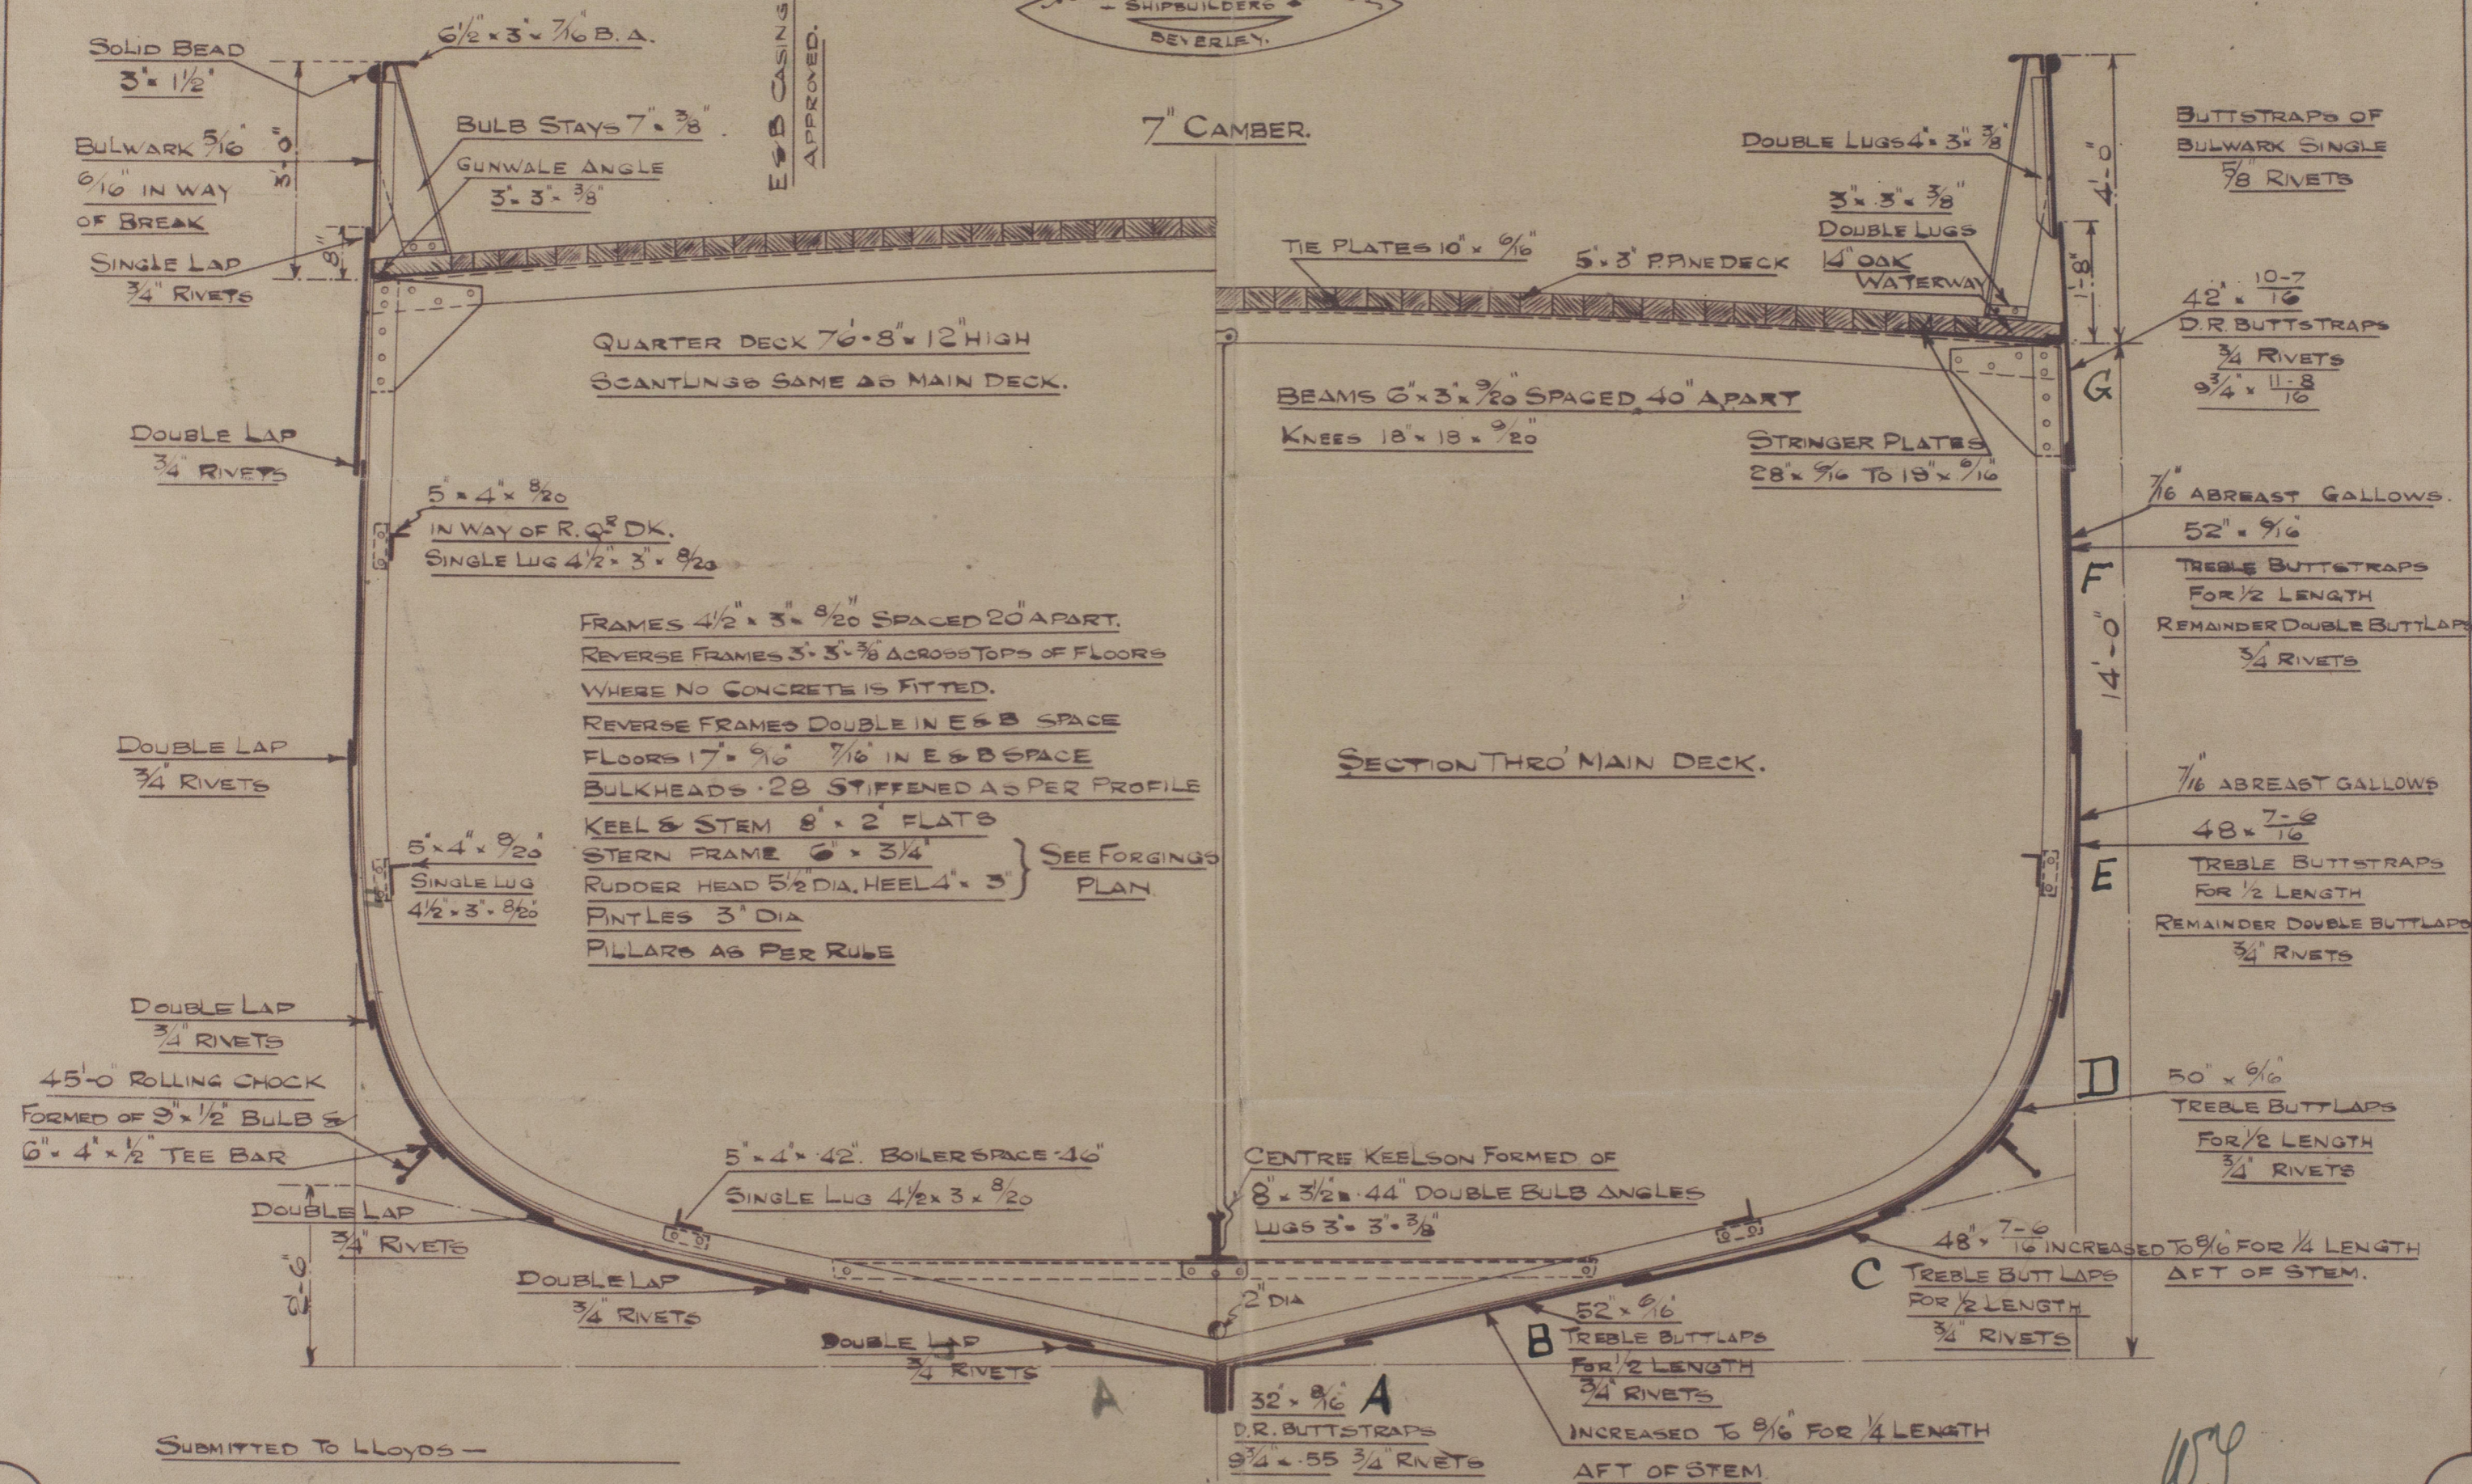

SUBMITTED TO LLOYDS -

APPROVED BY LLOYDS-