

Cook, Welton & Gammell  
nos. 512-13  
Fleming - Rpt. no.  
Capel - " " -  
Profile & Deck.

512.  
SS. Fleming.

HULL REPORT NO. 39590.

RETAIN

W395-0142




© 2019

Lloyd's Register  
Foundation



STEEL MIZZEN MAST  
SUPPORTED TO SURVEYORS  
SATISFACTION.

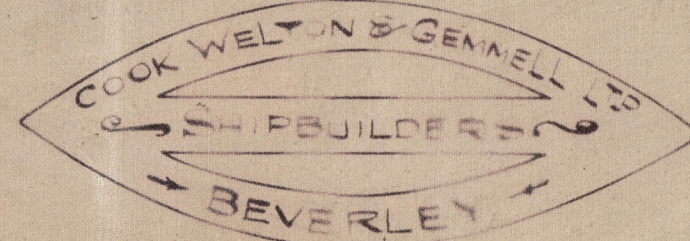

P. PINE FORECAST  
SUPPORTED TO SURVEYORS  
SATISFACTION.

WHALEBACK } PLATING .31"  
STIFFERS 4" x 3" x .38" SPACED 30" APART  
x BRACKETED TO DECK


# PROFILE *AND* DECKS.

## PILLARING THROUGHOUT TO SURVEYORS SATISFACTION

DIMENSIONS:- 14'-0" B.R. x 24'-0" EXT x 14'-0" MLD DEPTH

SCALE  $\frac{1}{4}" = 1 \text{ FOOT}$

N<sup>OS</sup> 512 E 13.

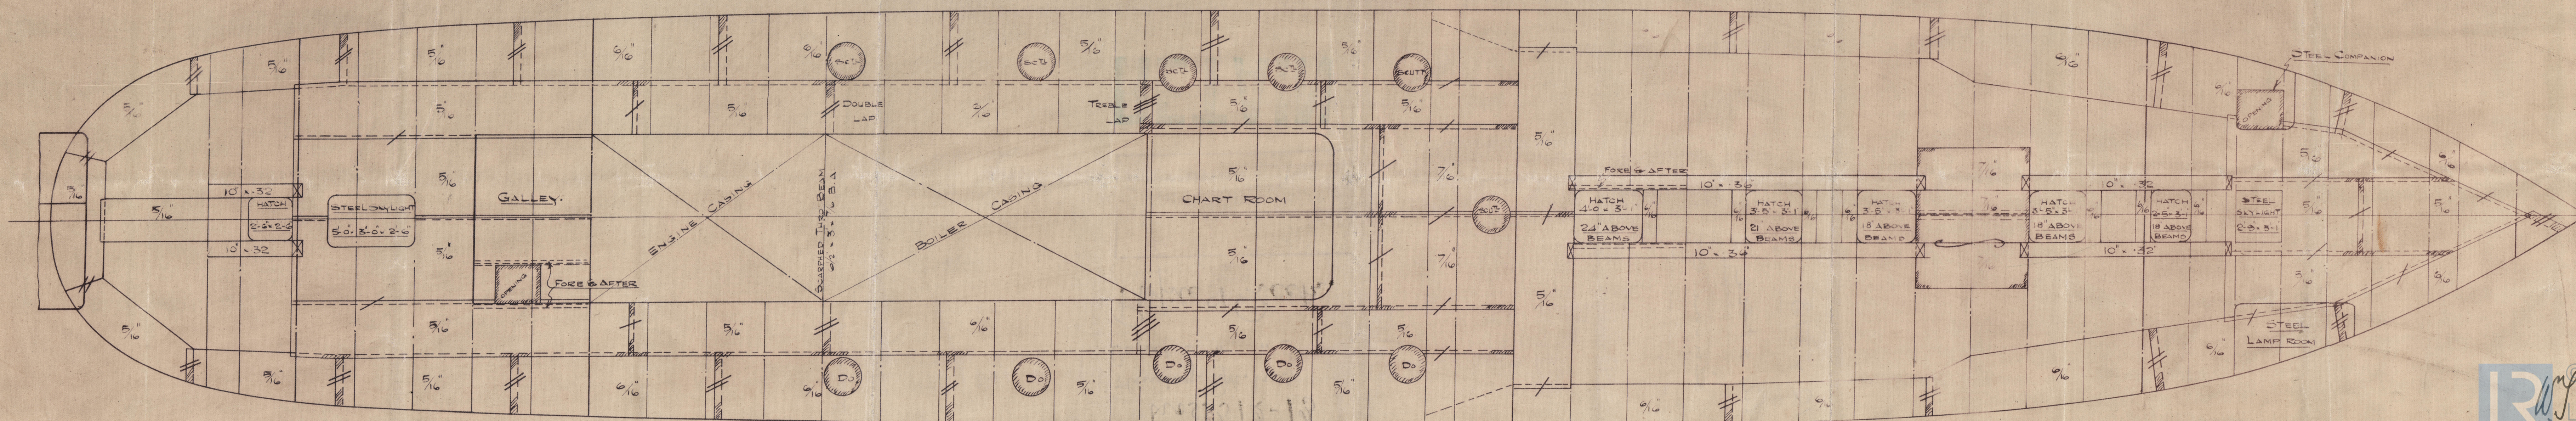

© 2019  
Lloyd's Register  
Foundation

W395-0142



572 + 573

Profile + Deck

C.W. Lemmell

W395-0142



© 2019

Lloyd's Register  
Foundation