



23.4.17 FREEBOARD PARTICULARS —
 9.5.17
 LENGTH BETWEEN PERPENDICULARS 217'0"
 BREADTH AT LOAD WATER PLANE 216'8"
 BREADTH EXTREME 52'0"
 DEPTH MOULDED 15'6"
 DEPTH OF HOLD 13'5"
 SHEER FORWARD 5'7"
 1/2" FROM FORWARD 2'0"
 1/2" FROM AFT 1'0"
 LENGTH OF RAISED QUARTER DECK 105'6" 3'0" ABOVE MAIN DECK
 17'3" 7'0"
 SINK FORECASTLE 25'0" 2'0" LINE OF MAIN DECK
 COEFFICIENT OF DISPLACEMENT 753
 UNDER DECK TONNAGE APPROX. 720 TONS
 RAISED QUARTER DECK TYPE DEEP BULWARK FRAMES
 NOCKLING ON TANK TOP CARGO PATTERNS TO BE FITTED

No. 291
 PROFILE & DECK PLAN.
 SCALE 1" = ONE FOOT.

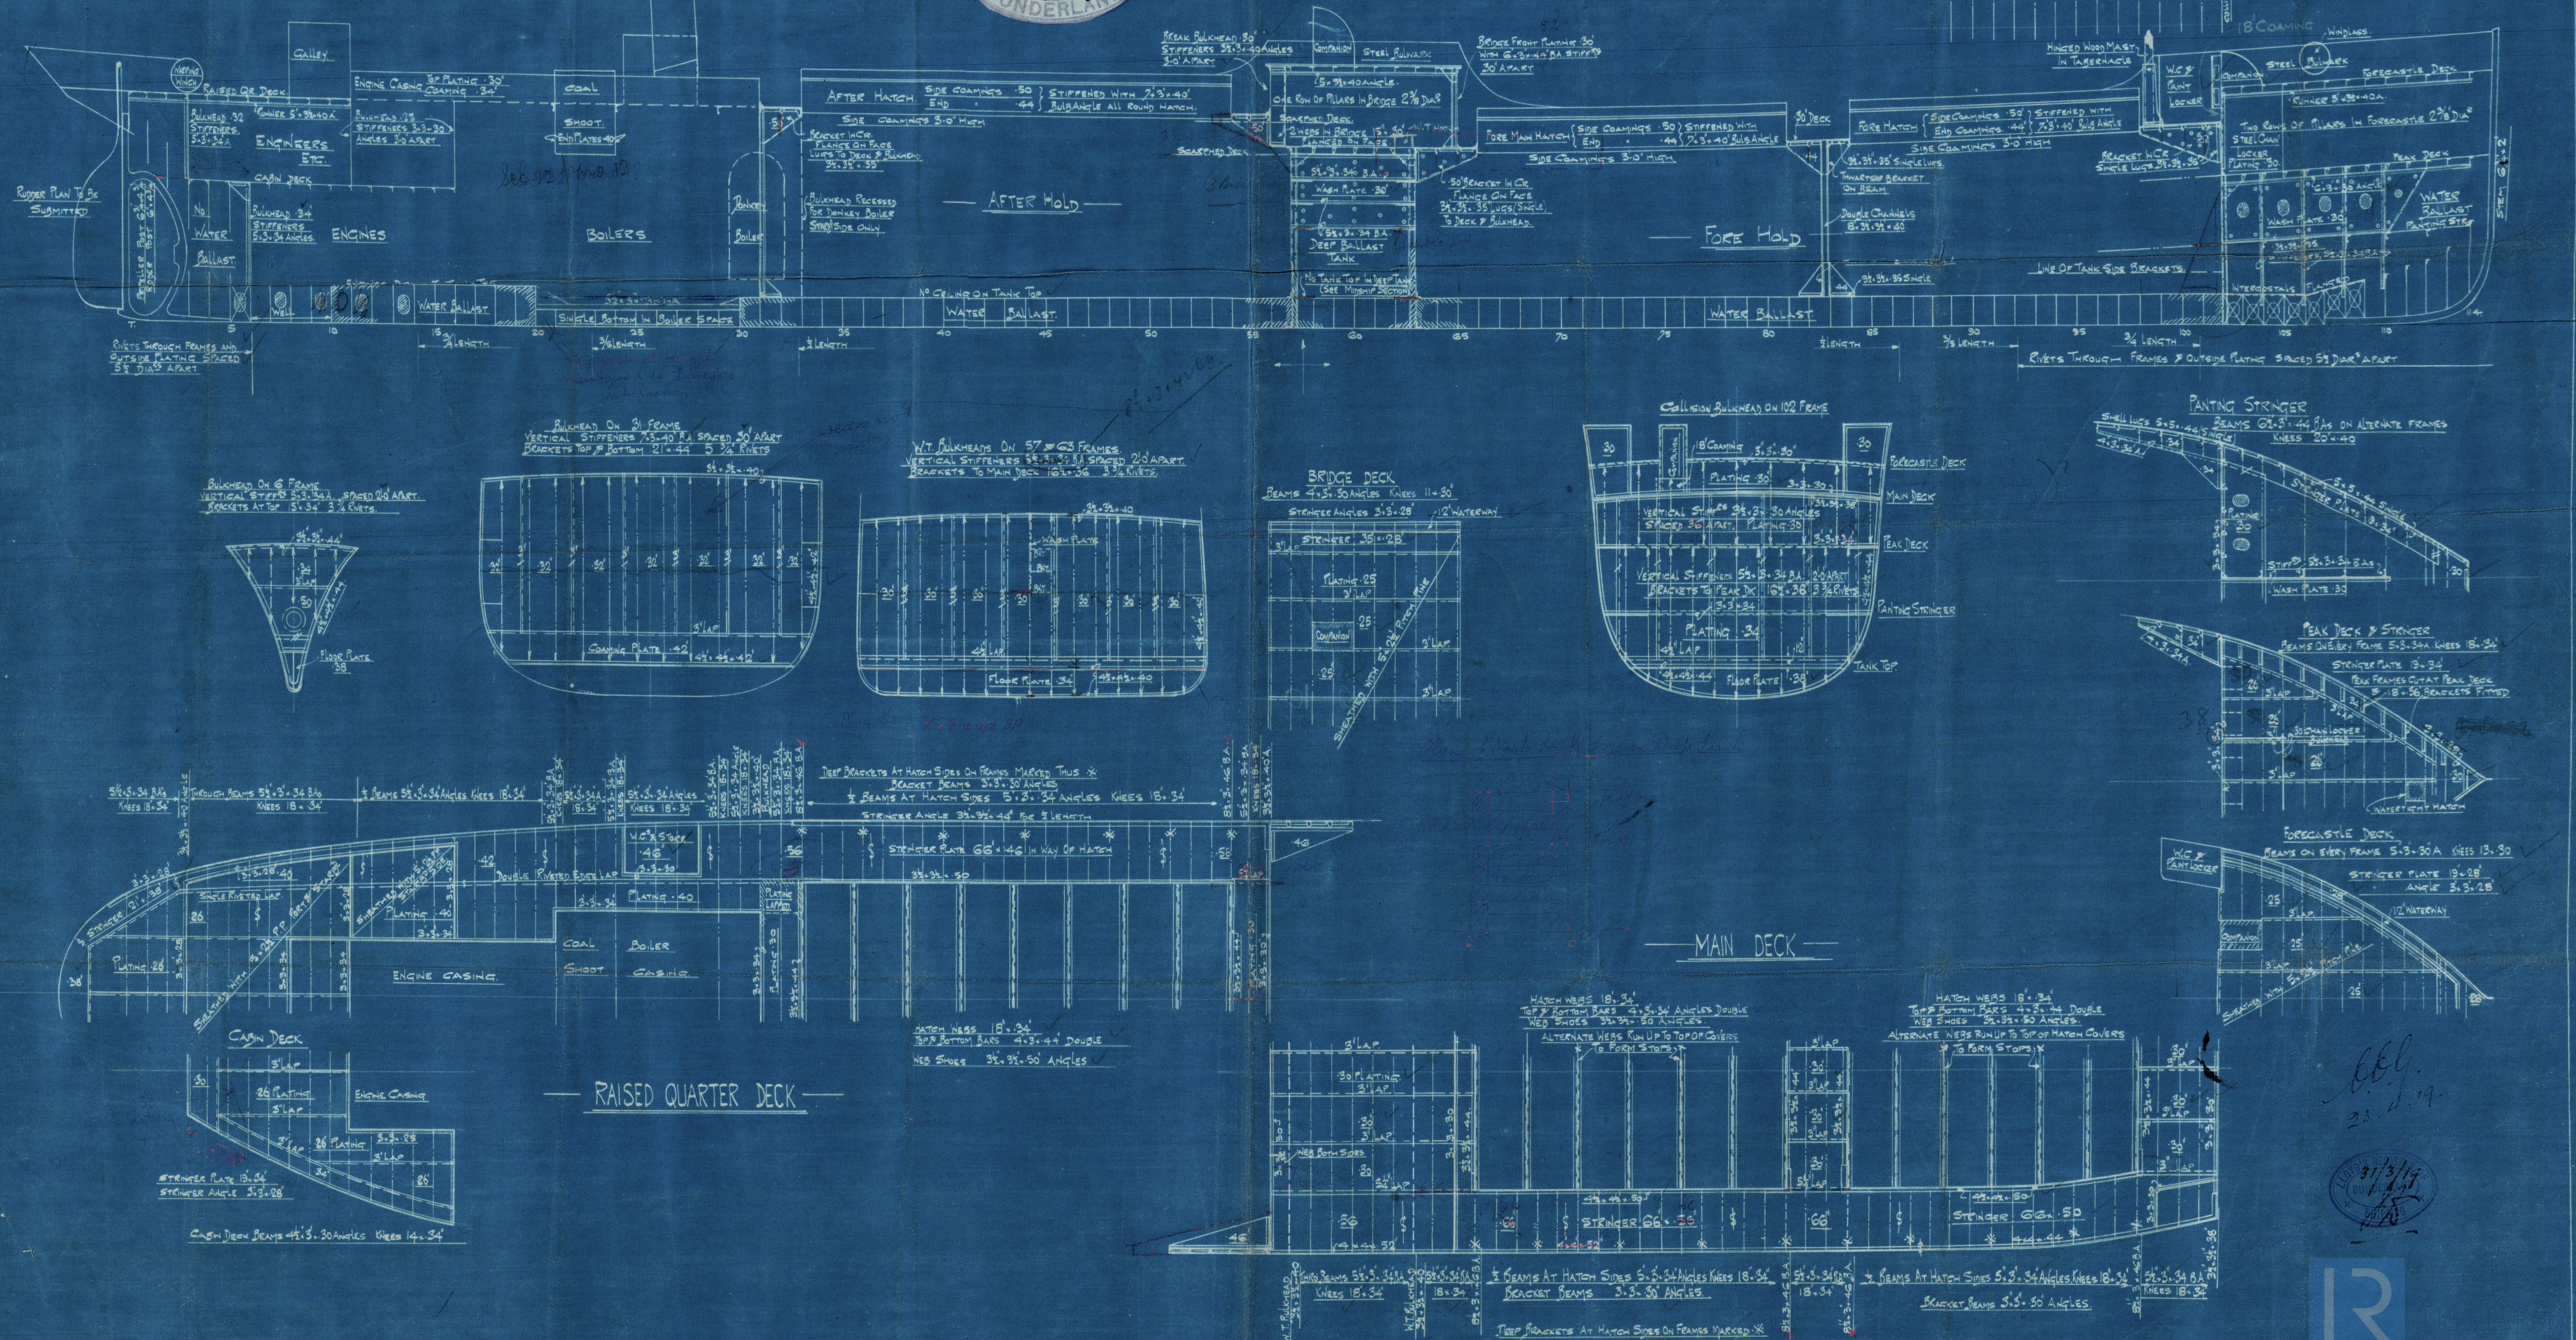

669.
 23.4.17.

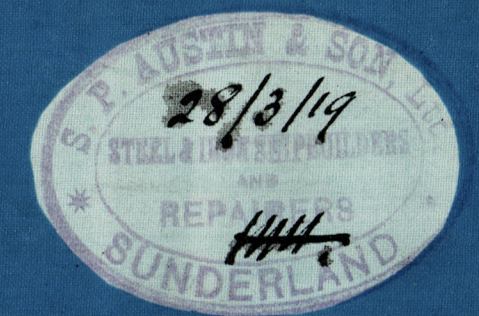

S. P. Austin & Son.

— N^o. 291 —

Profile & Decks.

S.S. "FLASHLIGHT"

Sld App. 87855 1

RETAIN



© 2019

Lloyd's Register
Foundation
W315 0220