

21 JUN 1937


No 1184

# WASHPORT ARRANGEMENT

1/4" = 1 FOOT

all washports 24" x 13"  
BARS ACROSS. NO DOORS

Approved for  
freem's  
21.6.37

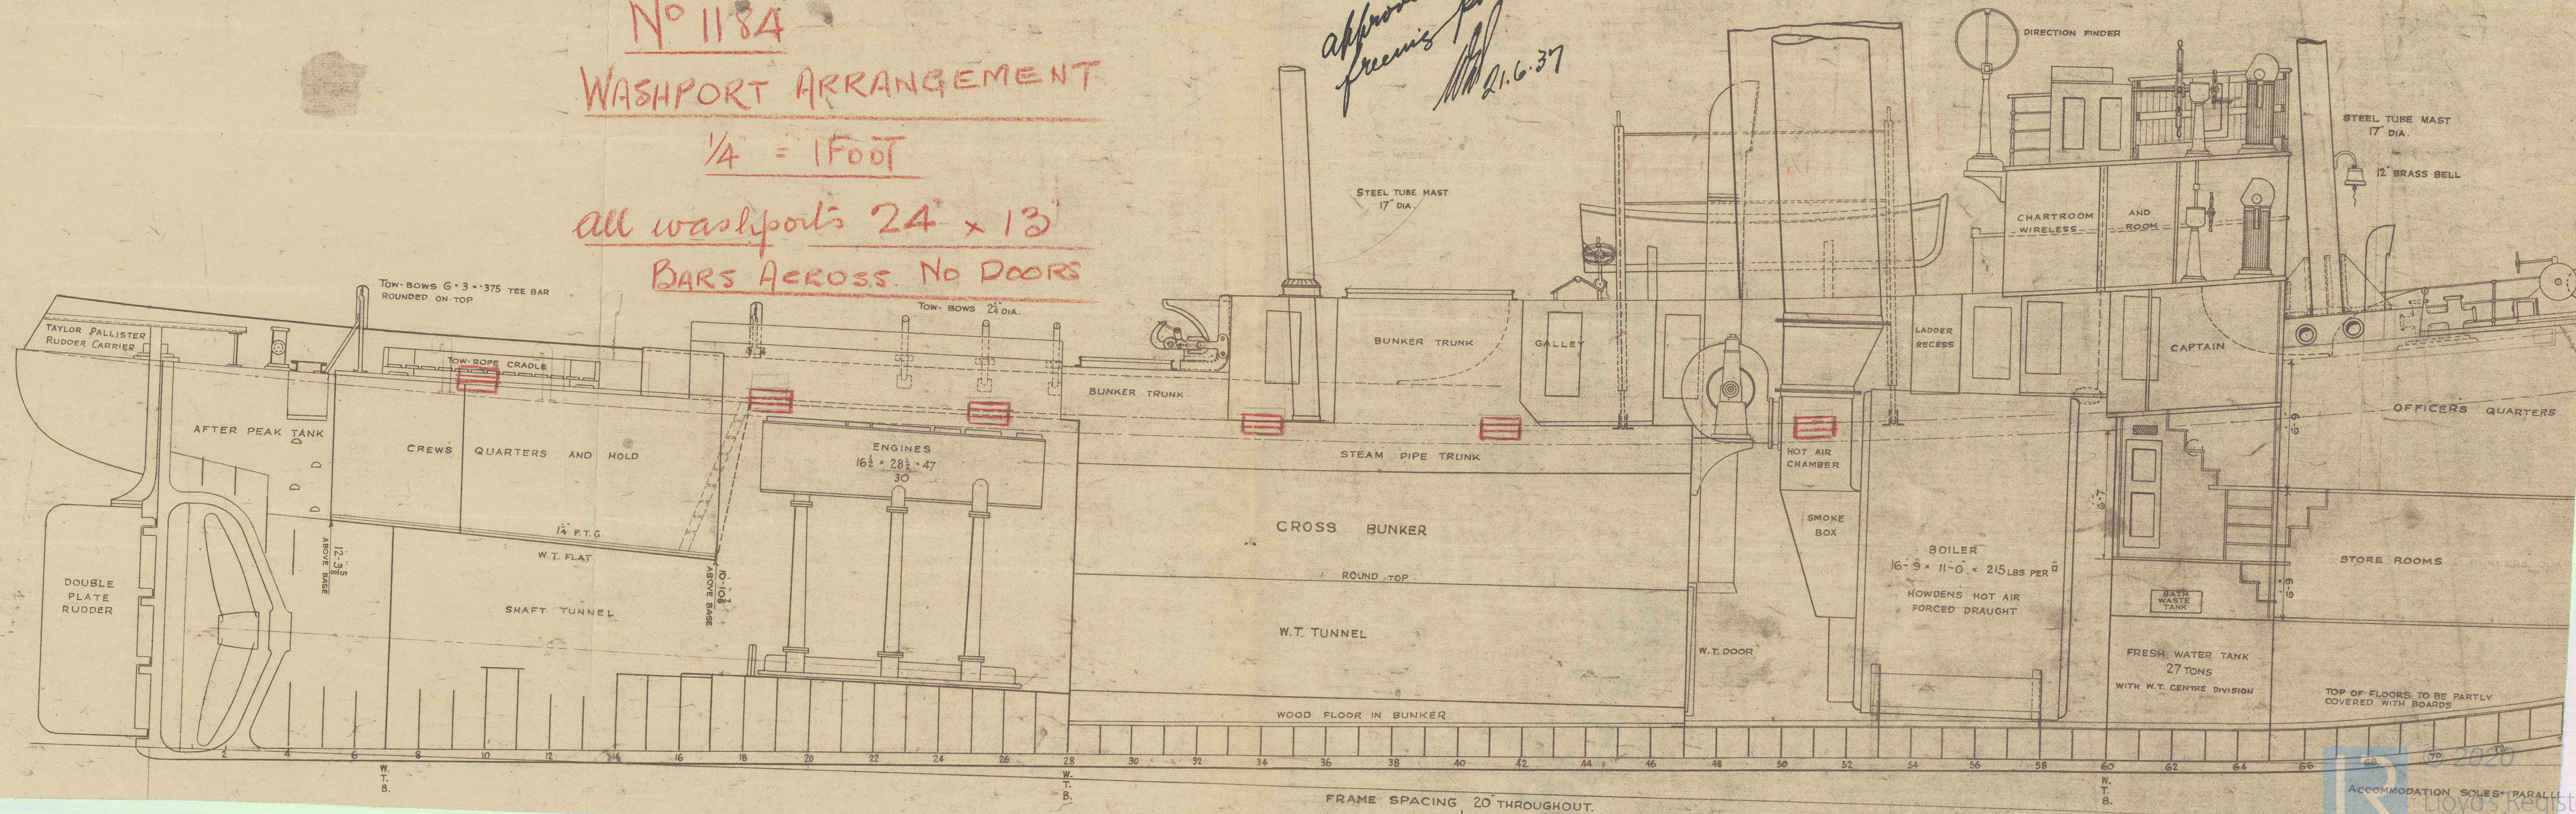



PLAN No. 585  
FOR ENCLOSURE TO  
*Lloyds Ref S*  
*Hull* FROM  
COCHRANE & SONS, LTD.  
SHIPBUILDERS, SELBY.  
DATE *17/6/37*

ENCLOSURE  
No 49  
"JUNIOR"



© 2020

Lloyd's Register  
Foundation




HULL

Cochrane 9 S mo Ltd

Yard no. 1184

Dashpoint Arrangement

RETAIN

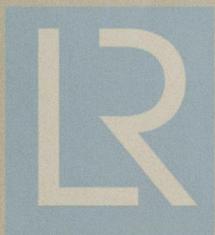

© 2020

Lloyd's Register  
Foundation