

Certificate of Freeboard:

Name of Classification Society: *Lloyd's Register of Shipping*
Name of ship: *S. ERIC BOYE.* Gross Tonnage: _____
Port of registry: *Copenhagen* Year when built: *1924*
Owner: *Dampskibsselskabet Vindila.* Class: *+100. A.1. Class contemplated*
Type: *Single deck Prop Bridge Newcastle*
V. Summer freeboard in fresh water 1 ft. 10 in = 560 mm below the
upper edge of the statutory deck line
Summer freeboard in tropical seas 1 ft. 11 in = 585[✓] mm below the
upper edge of the statutory deck line
Summer freeboard (centre of disc) 2 ft. 2³/₄ in = 674[✓] mm below the
upper edge of the statutory deck line
Winter freeboard 2 ft. 5³/₄ in = 750[✓] mm below the
upper edge of the statutory deck line
A. Winter freeboard in north Atlantic 2 ft. 7³/₄ in = 801[✓] mm below the
upper edge of the statutory deck line.

The statutory deck line is marked in accordance with *The Board of Trade*

*Freeboard tables No. 14 = 44³/₄ in above the upper deck at sides
(top of steel deck)*

*This is to certify that the freeboard of the above vessel
has been marked on the vessel's sides in accordance
with the above.*

Copenhagen March 14th 1924

Cyril B. Seaver.

SURVEYOR TO LLOYD'S
REGISTER OF SHIPPING




© 2019

Lloyd's Register
Foundation

W397-0107

W397-0115

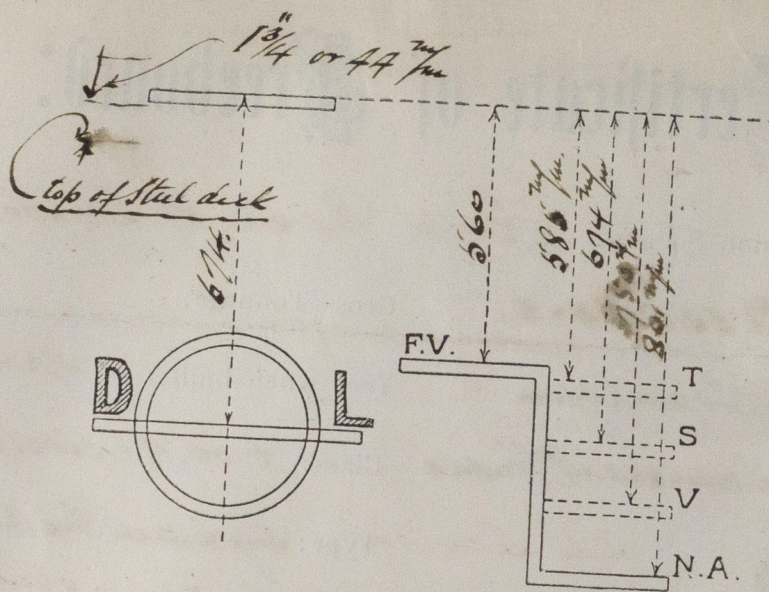

© 2019

Lloyd's Register
Foundation