



5/4/23.



W397-0119

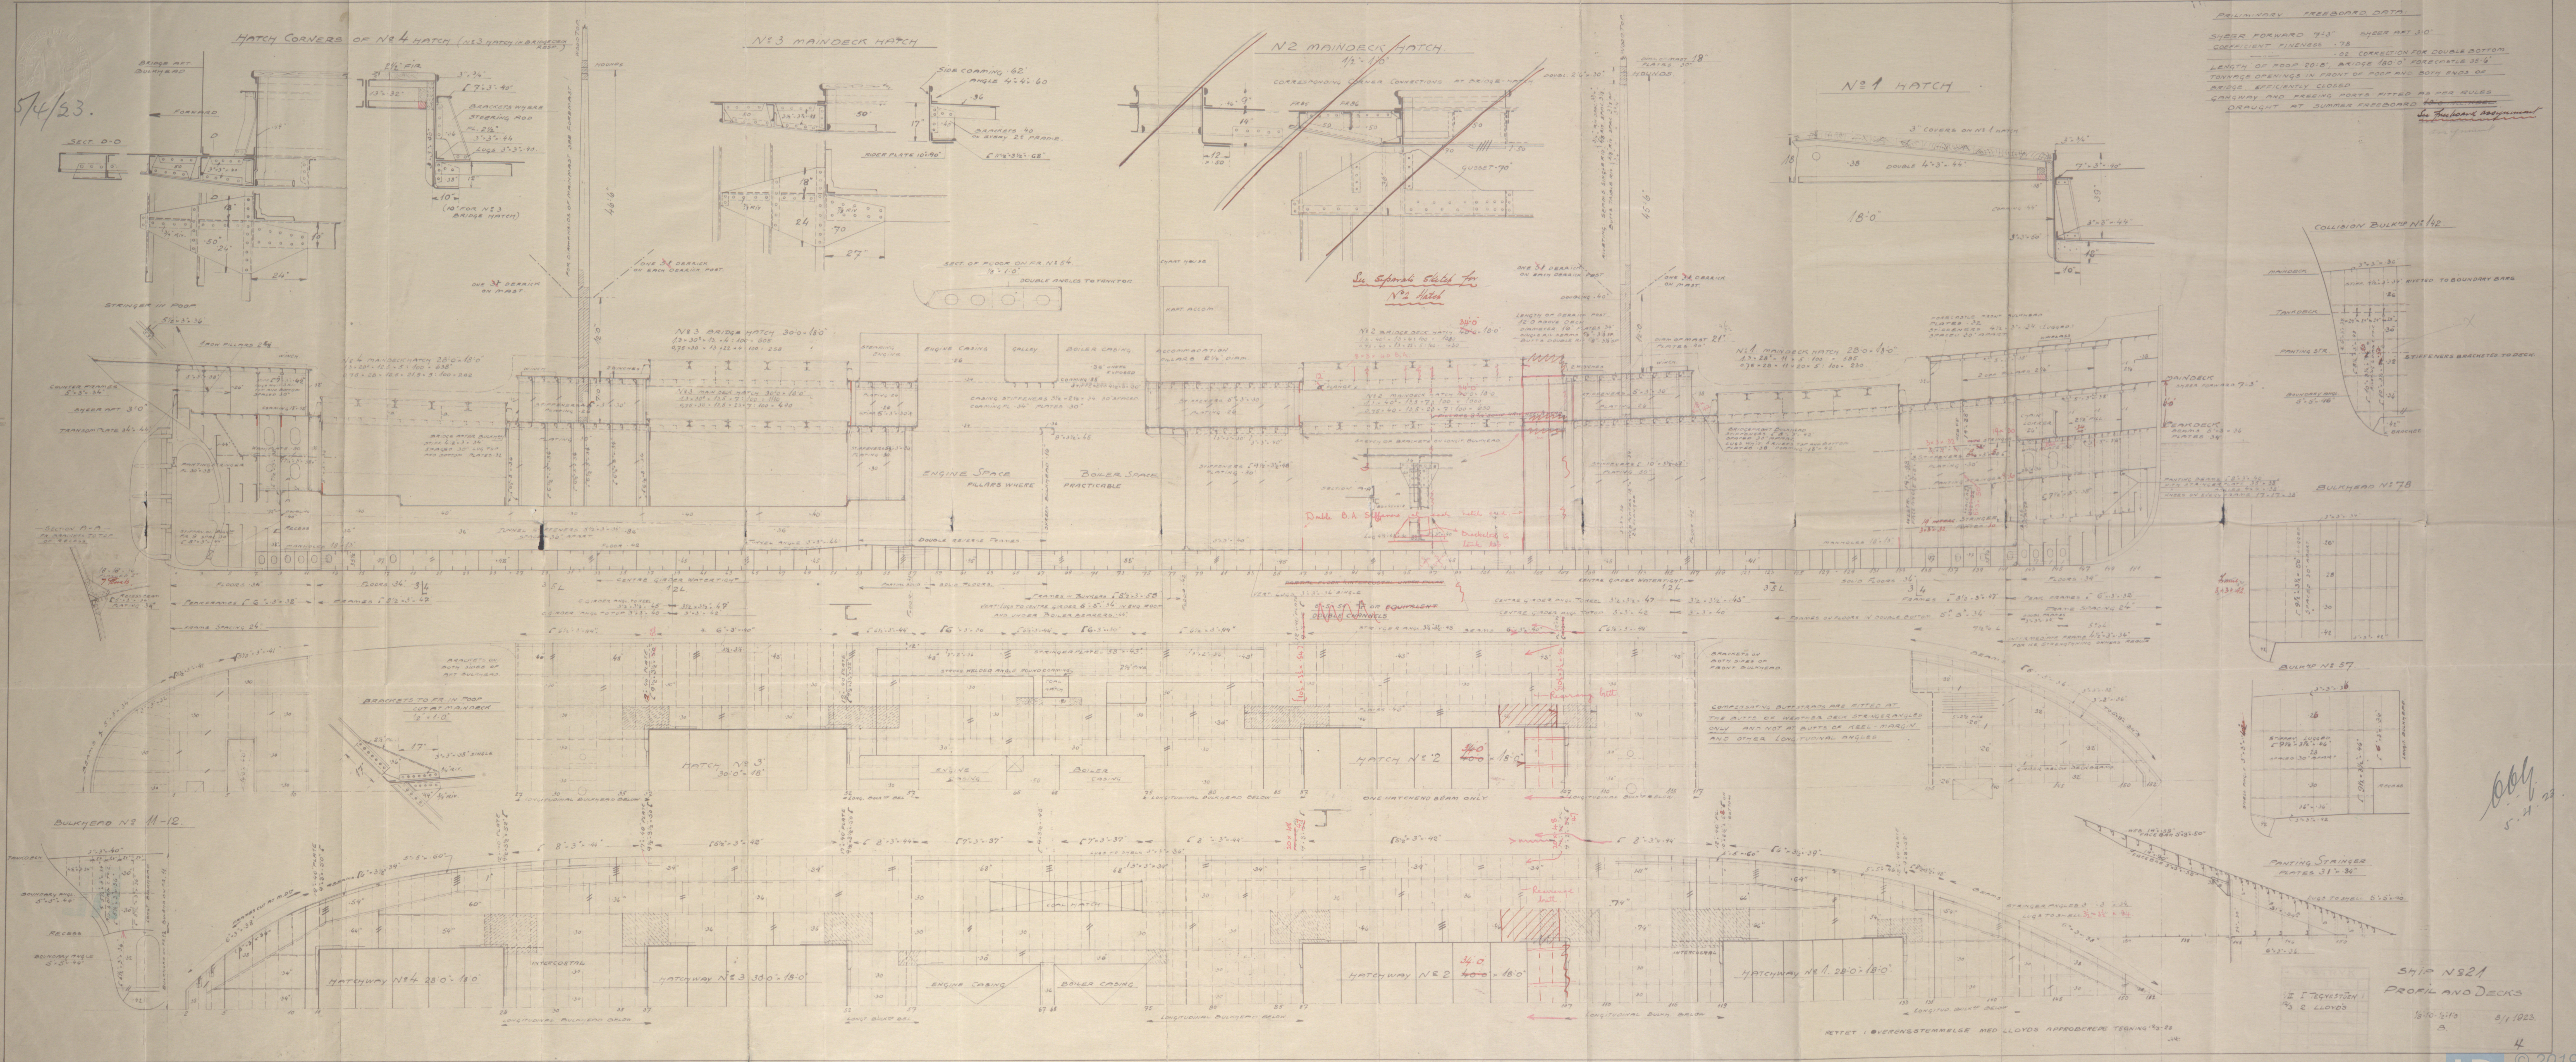

AMENDED PROFILE &  
DECK PLANS  
NARSKOV N<sup>o</sup> 21.

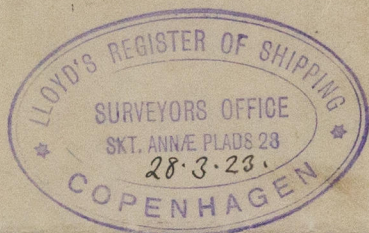


(2)

S/S<sup>1</sup> Erik Bay  
Gps. Rpt. No. 6779.

RETAIN

W397-0119  
© 2019

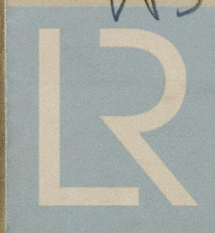

Lloyd's Register  
Foundation