


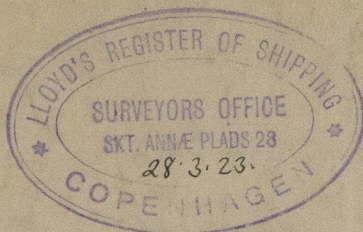



AMENDED MIDSHIP SECTION

NAKSKOV N° 21



①

s/s "Erik Doye"  
Gym. Rpt. No. 6779.

RETAIN

W397 - 0120



© 2019

Lloyd's Register  
Foundation