
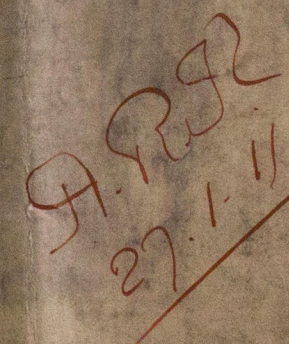


TENSILE STRENGTH OF STEEL 28 TO 32 TONS □"


GRATE SURFACE 30 sq'

" " RIVET 70.8%

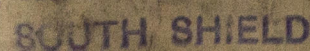

J READHEAD & SONS
DONKEY BOILER N° 421
WORKING PRESSURE = 90 lbs "D"

S/s "Grevalgan"

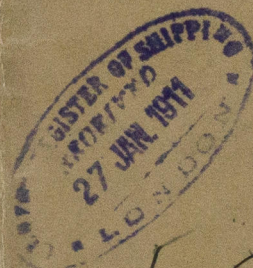

NEWCASTLE - ON - TYNE.
REPORT No 61042

n/n Georgios Kyriakides

RETAIN

RETAIN

W398-0180



© 2020

Lloyd's Register
Foundation