


12.6.16  
27.6.16

8' NORWAY PINE MIZZEL  
SUPPORTED TO SURVEYORS  
SATISFACTION.

E.R. SKYLIGHT.

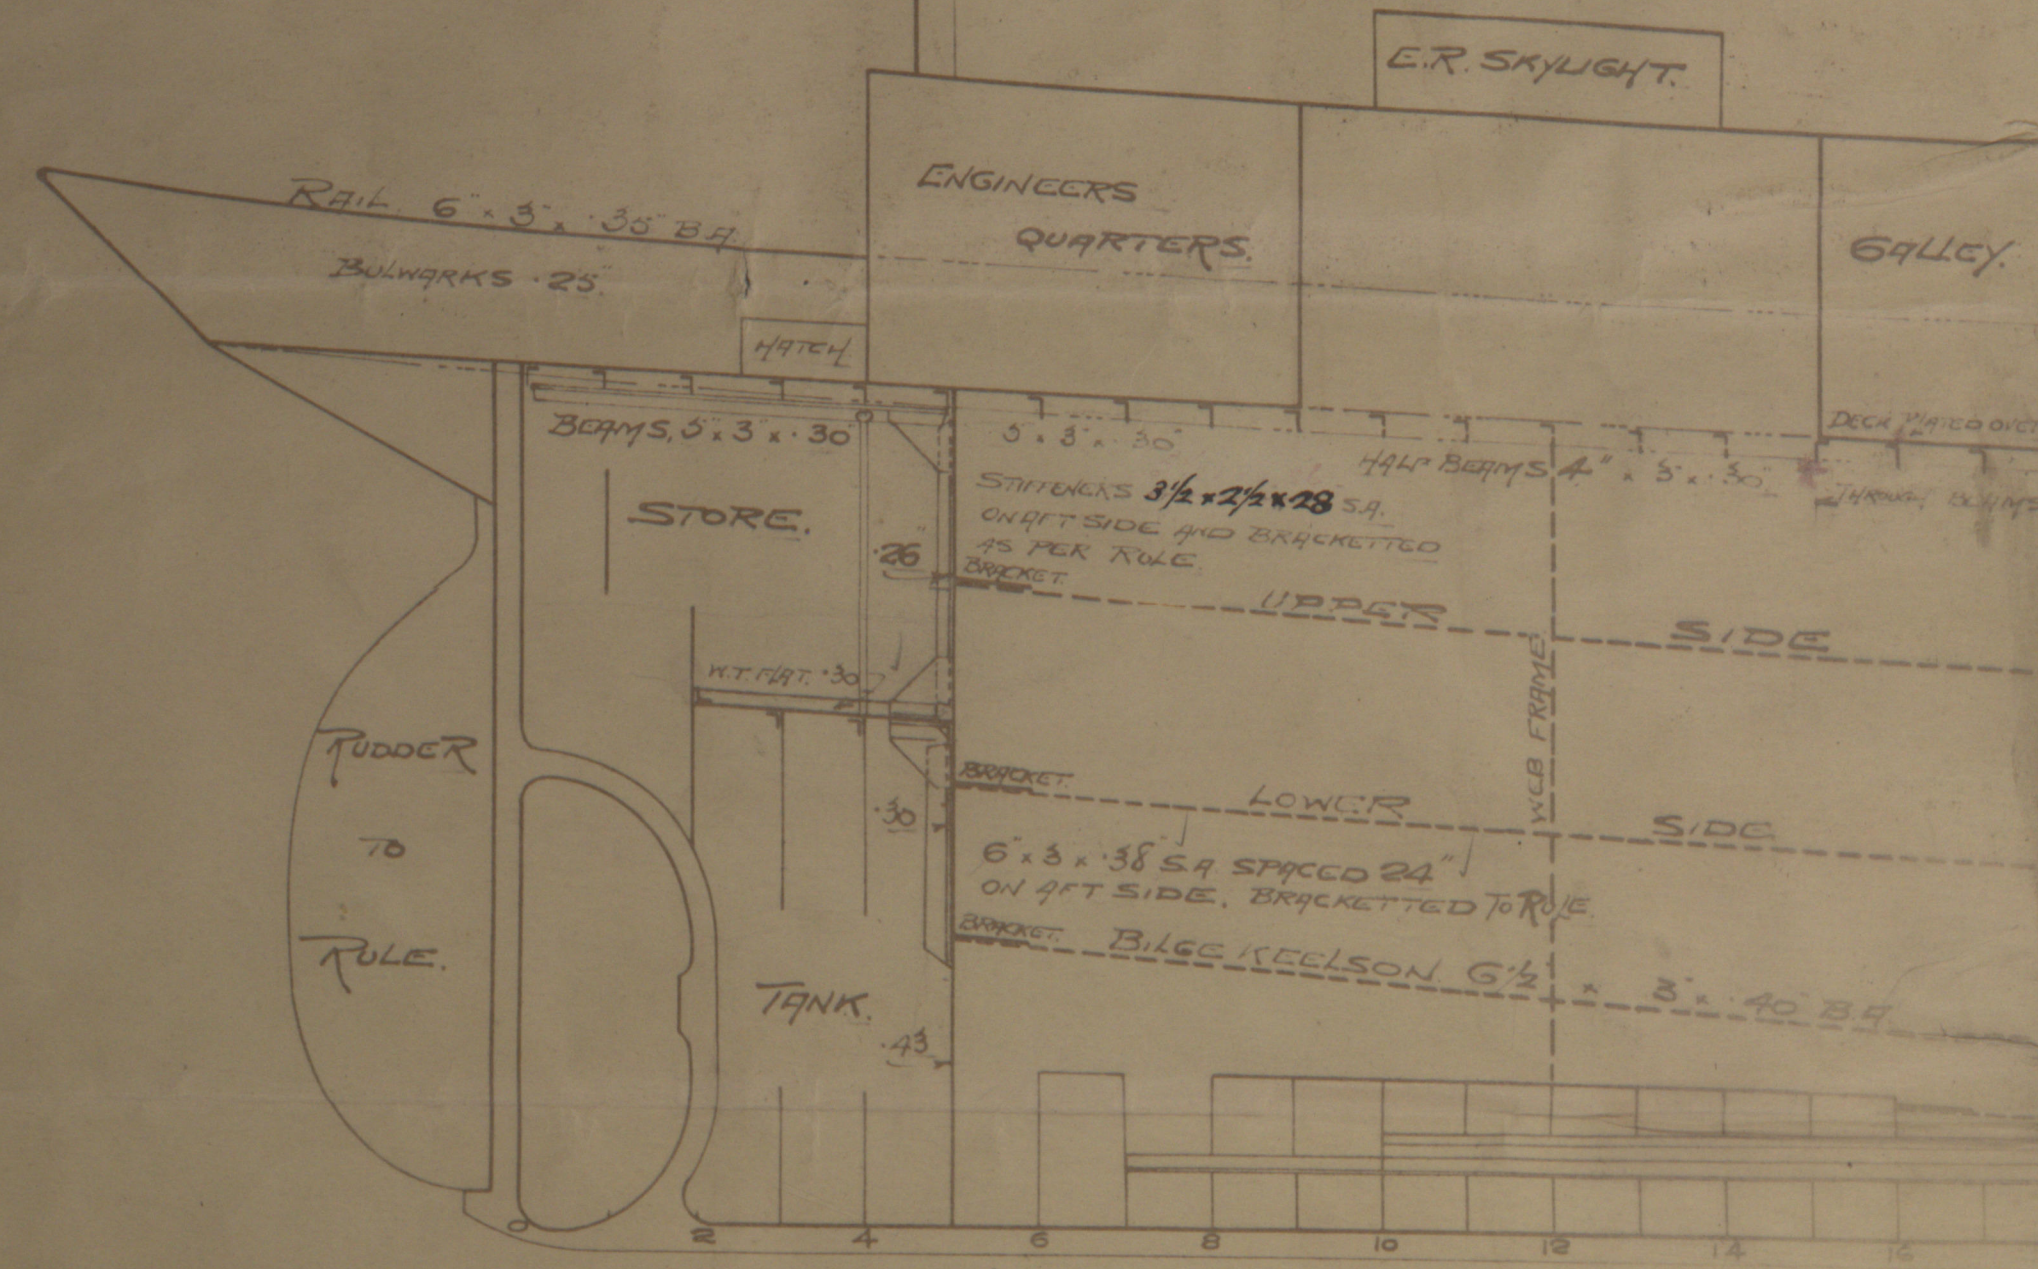

12' PITCH PINE MAST SUPPORTED  
TO SURVEYORS SATISFACTION.

PLAN NO. R52  
FOR THE USE OF  
Messrs Lloyd's Surveyors  
Hull  
COCHRANE & CO. LTD.  
SHIPBUILDERS, 101, 103, 105,4263




Cochrane's nos 726 & 727

Profile & Deck.


5 "Garrick" ~~that forwarded upst~~  
#29713



St Ebriex Hull Fbd Rpt No 29730

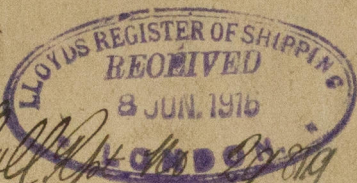

5 "Garrick" Hull Rpt No 29861  
5 "Ebriex"

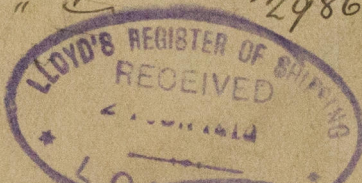

Jamies

1/2 "Gorsetham"

RETAIN

W399-0035

© 2020

Lloyd's Register  
Foundation