

142	✓	1916	✓	SS "WAR SWORD"	CUNARD SS CO.				
HULL NO.	ORDER No.	DATE	No. WANTED	N. H.			CONSTRUCTED FOR		
<p align="center"><b>UNION IRON WORKS CO.</b> SHIPBUILDERS AND ENGINEERS SAN FRANCISCO, CALIF. <b>HULL DEPT.</b></p> <hr/> <p align="center">— LLOYD'S MIDSHIP SECTION — — SS "WAR SWORD" — HULL No 142 —</p> <hr/> <p>SCALE: 1/2" = ONE FOOT. DATE: Sept 4/17.</p> <p>DRAWN BY: _____ TRACED BY: _____ CHECKED BY: _____</p> <p>SHEET No. _____ NAVAL ARCHITECT CASE No. _____</p> <p>43 147. GUSTAF BRANTZMAN <i>G.M. Brantzen</i> 1042</p>									




"Arabutan"  
<sup>ex</sup>  
S.S. WAR SWORD

Midship Section  
of vessel as built

Union Iron Works Co's  
— No 142. —

San Jo: Report No 2571.

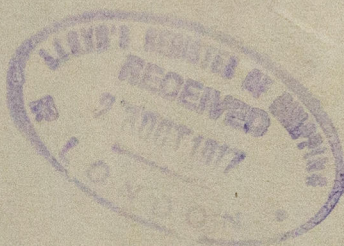

© 2021

Lloyd's Register  
Foundation

W4-0103