

16 MAART 1915.

LONGITUDINAL PLAN. SS. ~~№ 274. FR. 275~~

230'-0" x 34'-0" x 16'-0".


CLASSED AT LLOYD'S +.100. A.1.


SCALE $\frac{1}{8}" = 1 \text{ FOOT.}$

TRANSVERSE NUMBER $B+D=34+16=50$.

LONGITUDINAL „ $L(B+D) = 230 \times 50 = 11500$.

by
31.3.15

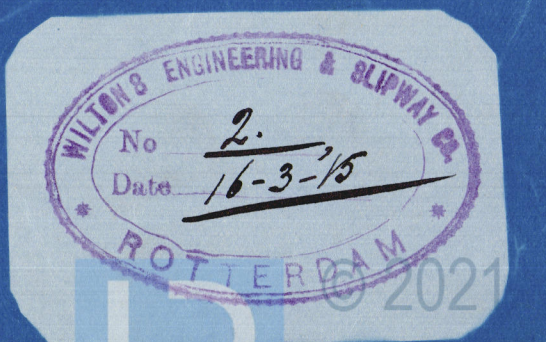

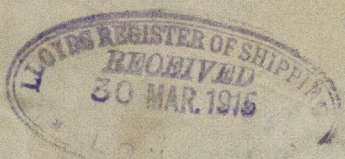

5/5 ^{Aruba.}
ex "Laura"



Profile and

Deckplan

Rotterdam Report N^o 10004



© 2021

Lloyd's Register
Foundation

W4 - 0201