


8/3/29.

No. 170
PROFILE & DECK.
OIL TANK STEAMER.


DIMNS: 185'-0" x 28'-0" x 12'-9 1/2" MR.
 SCALE: 1/4" = 1 FOOT

CLASS: 100 A1 AT LLOYD'S CARRYING PETROLEUM IN BULK

Supports under mullions, mullions, etc. to Surveyor's satisfaction

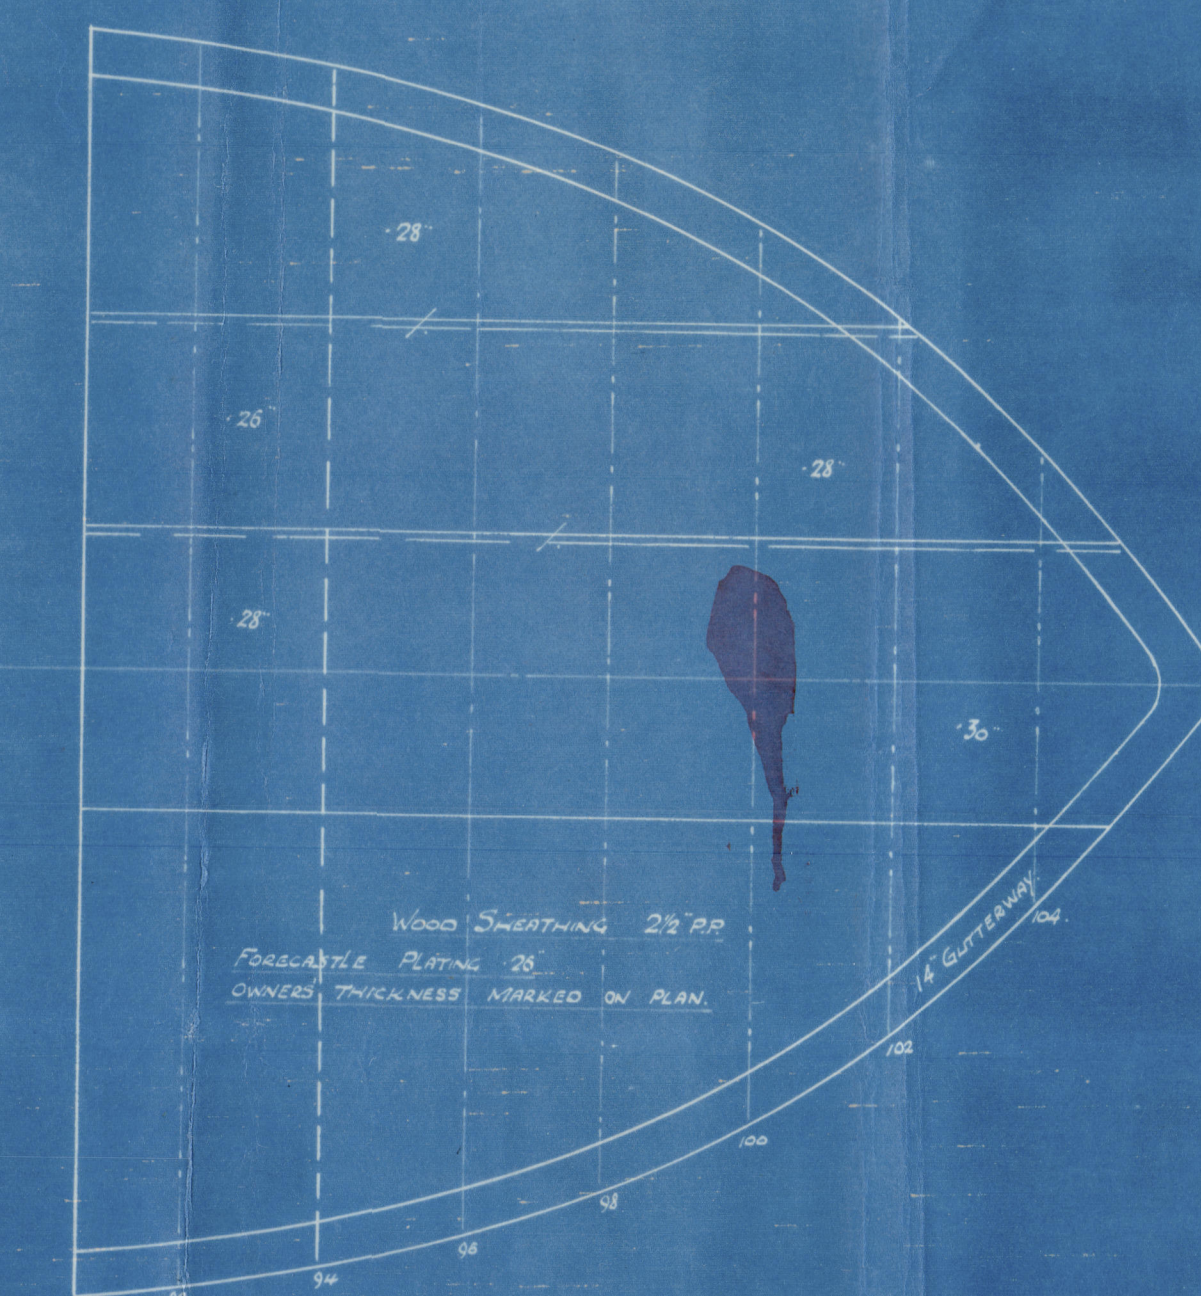

Detail plan of forward
 to be submitted

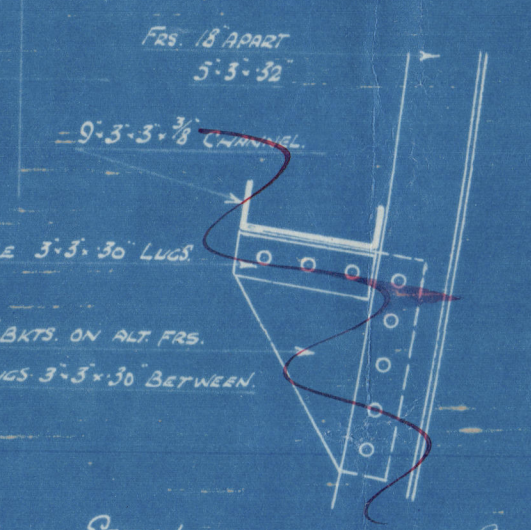

170
Geo. Brown & Co.

Oil Tanker.

"ASPERITY"

N. 170.

Profile & D. Plan.

G. N. No. 19097.



© 2021

Lloyd's Register
Foundation

W4 - 0222