




# - No. 96 - PROFILE & DECK PLANS.

DIMENSIONS:- LENGTH B.P. 245'-0" x 39'-3" BREADTH MLD x 21'-1 1/2" DEPTH MLD

SCALE 1/8" = 1 FOOT.

TO CLASS 100 A.1 AT LLOYDS.

MINIMUM SCANTLINGS REQUIRED FOR A MOULDED DRAFT OF 16'-0"

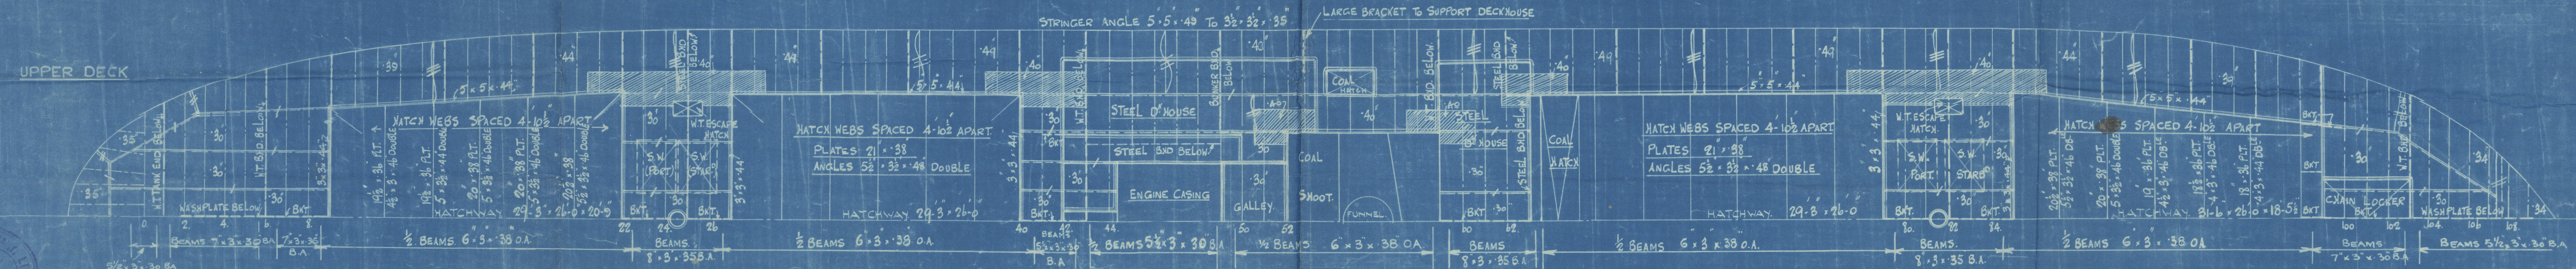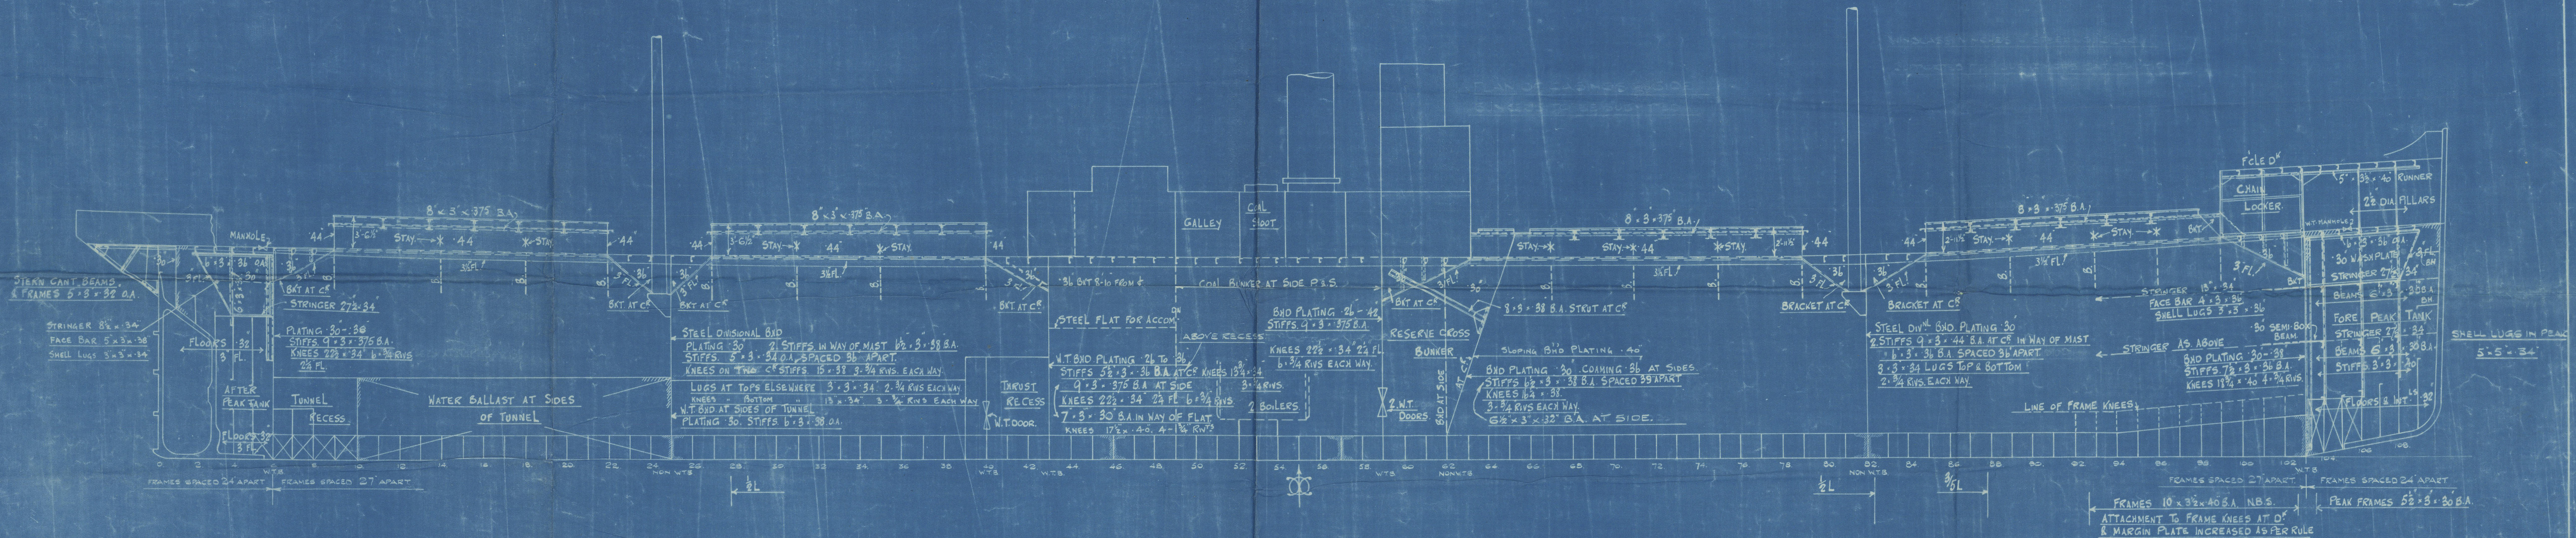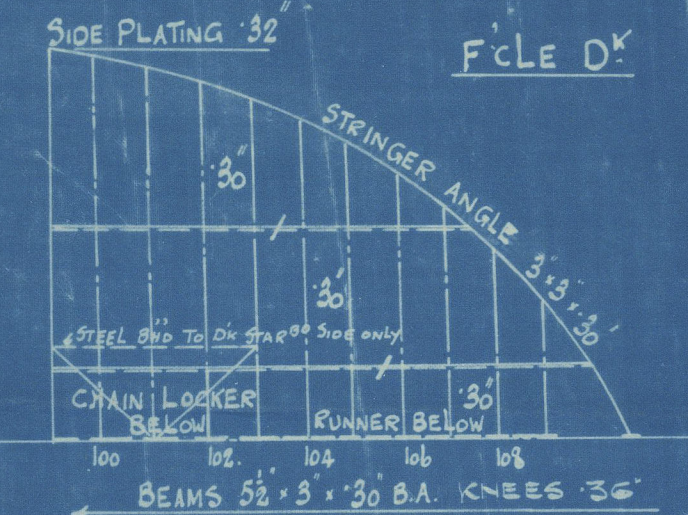

S.D.O.  
X7821  
19-11-25  
5.4350

LLOYD'S REGISTER  
SHIPPING



Messrs Furness Shipy. Co. Ld.

no 96

Profile & decks as built

S.S. Hanselen

MDB. RPT. No. 12532

RETAIN

W400-0032



© 2019

Lloyd's Register  
Foundation