

CRANK SHAFT FOR YARD N° 548

6 CYLINDER FOUR CYCLE DIESEL ENGINE

CYL. DIAM. 630 M/M STROKE 1100 M/M

THIS DRAWING AND THE DESIGN SHOWN
THEREIN, IS THE PROPERTY
OF BURMEISTER & WAIN LIMITED, AND
IS ONLY ALLOWED TO BE USED BY
EXPRESS PERMISSION AND LICENSE FROM
BURMEISTER & WAIN LIMITED
COPENHAGEN


AKTIESELSKABET
BURMEISTER & WAIN MASKIN- OG SKIBSBYGGERI

d. 11-10-1929
L. Jørgensen

18/10/27
W400-0042

Plan of
CRANK SHAFTS
 for Main Diesel Oil Engines
 of the Twin Screw Motor Vessel
Yard N^o 548
 being built by

AKTIESELSKABET
 BURMEISTER & WAIN MASKIN- OG SKIBSBYGGERI
 Copenhagen

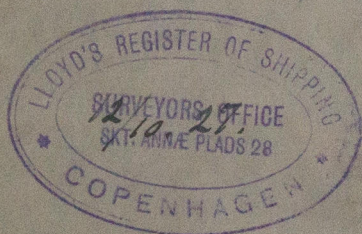

M/S "HIDLEFJORD."

Eng. Rpt. N^o 7796.



© 2019

Lloyd's Register
 Foundation

W400-0048