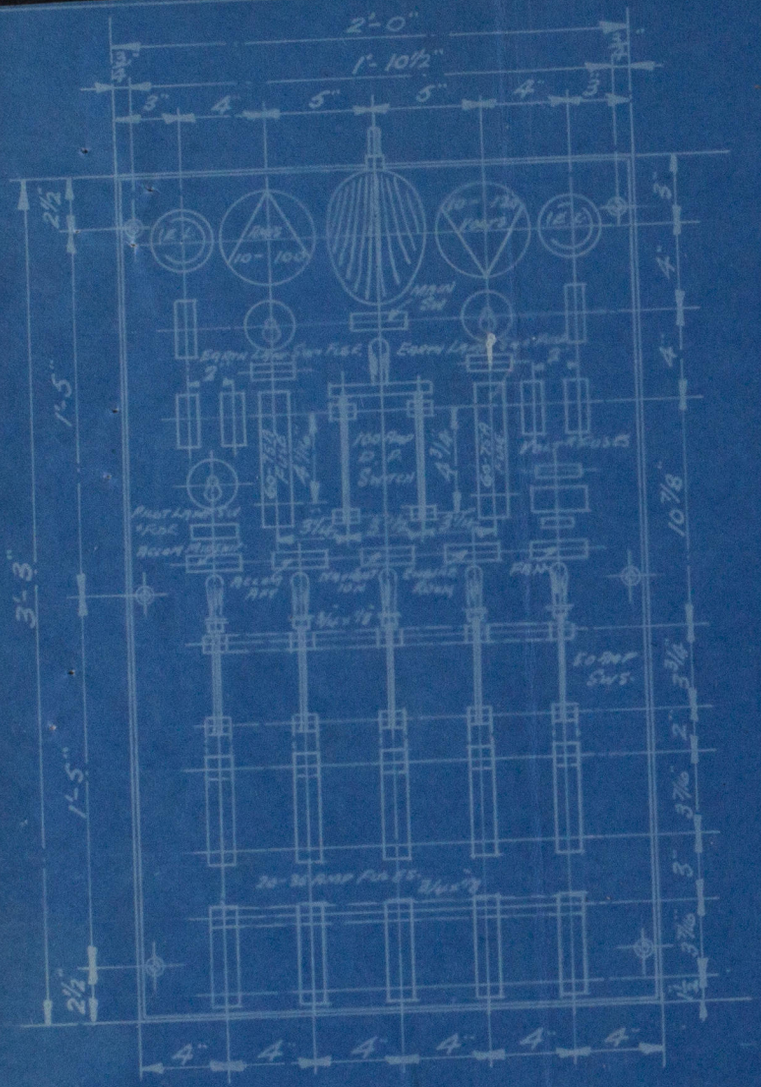

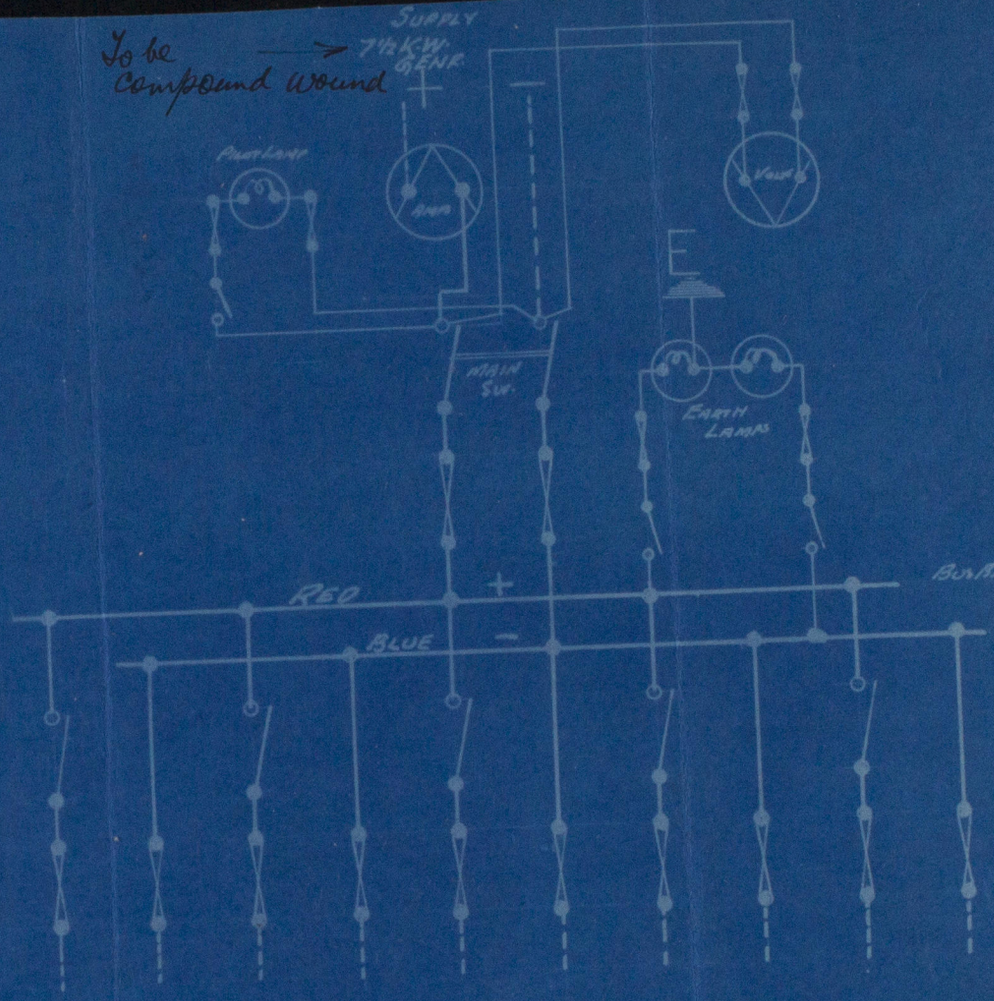


DIAGRAM OF CONNECTIONS.

S.474

ARRANGEMENT OF MAIN SWITCHBOARD 110 VOLTS D.C. FOR S/S ISLAND QUEEN SCALE 1½" = 1 FOOT.

FOR MESSRS THE TYNE DOCK ENGINEERING Co LTD

Good 22/7/38

ADAMSON GREEN & Co LTD
FELLING-ON-TYNE.

REFERENCE No.....

DRAWING No. S.474

DATE 15th JULY 1938 N.P.G.

W401-0048