

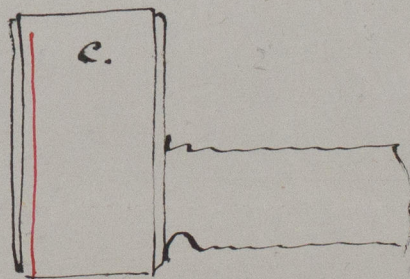
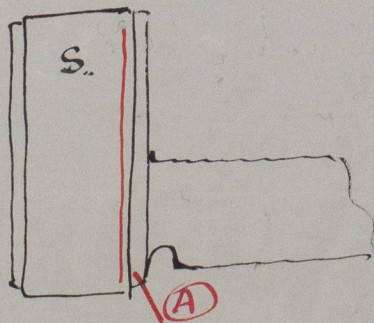


Sketch showing position of tracks in Combustion Chamber
 two upper plates in the Starboard Boiler of the IRENE MARIA
 of Esbjerg No. 26.978. in the Register Book

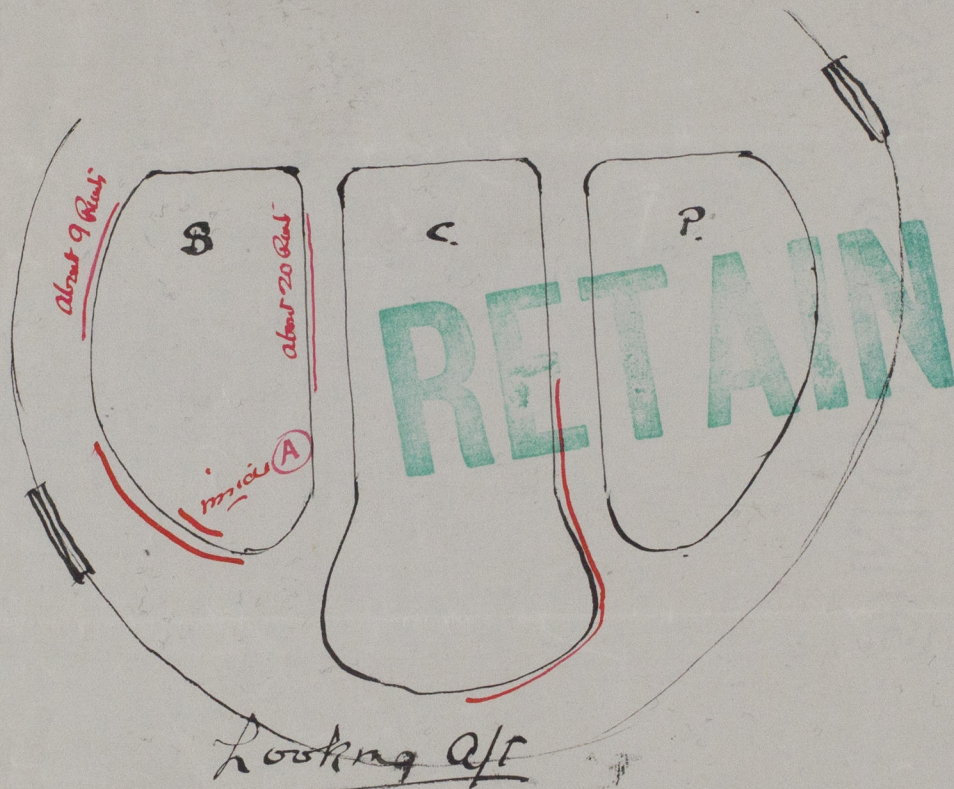

Tracks extending from rivet hole to rivet hole. and except
 tracks (A) are only visible from water side gal.

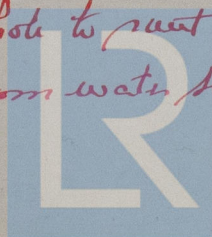

Lloyd's Register
 Foundation

W401-0195