

Mess Sir R. Dixon 6th

N^o 596 A




MIDSHIP SECTION.

(amended) ✓


S.S. "Herron"

MIDDLESBRO' 10931

RETAIN

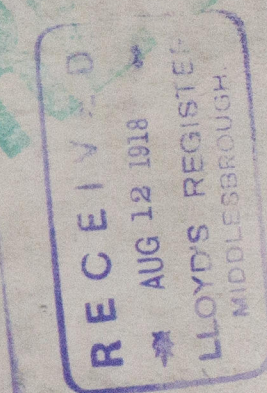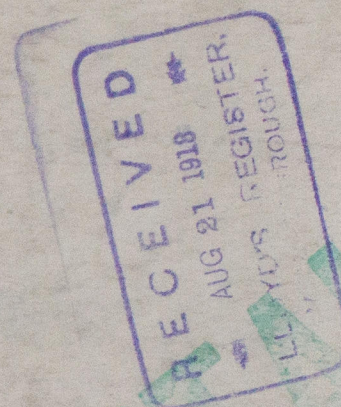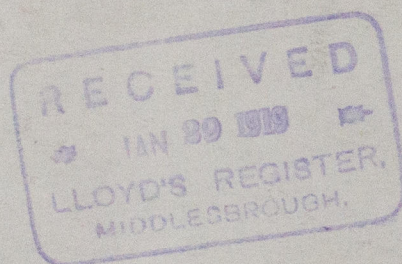

W402-0151

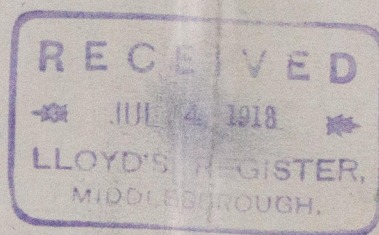

W402-0151



© 2020

Lloyd's Register
Foundation