

# MIDSHIP SECTION

— S T N<sup>o</sup> 135 —

DIMENSIONS 90' 0" B.P. x 18' 0" M.D. x 10' 4" M.D.

SCALE  $\frac{3}{4}$ " = ONE FOOT

TO CLASS A.1. AT LLOYDS FOR RIVER AND TOWING PURPOSES


## EQUIPMENT

11-12-04

1 <sup>st</sup> AND 2 <sup>nd</sup> ANCHORS EACH	3 $\frac{1}{2}$ CWT. EX. STOCK OR 4 $\frac{3}{8}$ CWT. STOCKLESS
3 <sup>rd</sup> "	2 " " " OR 2 $\frac{1}{2}$ " "
60 FATHOMS	1 $\frac{3}{16}$ " STUD CHAIN CABLE
60 "	5 $\frac{1}{2}$ " HAWSER OR 1 $\frac{1}{2}$ " STEEL WIRE
60 "	3 " WARP " " "

## NUMERALS

$\frac{1}{2}$ GIRTH	=	16.25
$\frac{1}{2}$ BREADTH	=	9.00
DEPTH	=	10.70
		35.95 = 1 <sup>st</sup> NUM.
35.95 x 89.15 =		3204.9 = 2 <sup>nd</sup> NUM. & EQUIP.

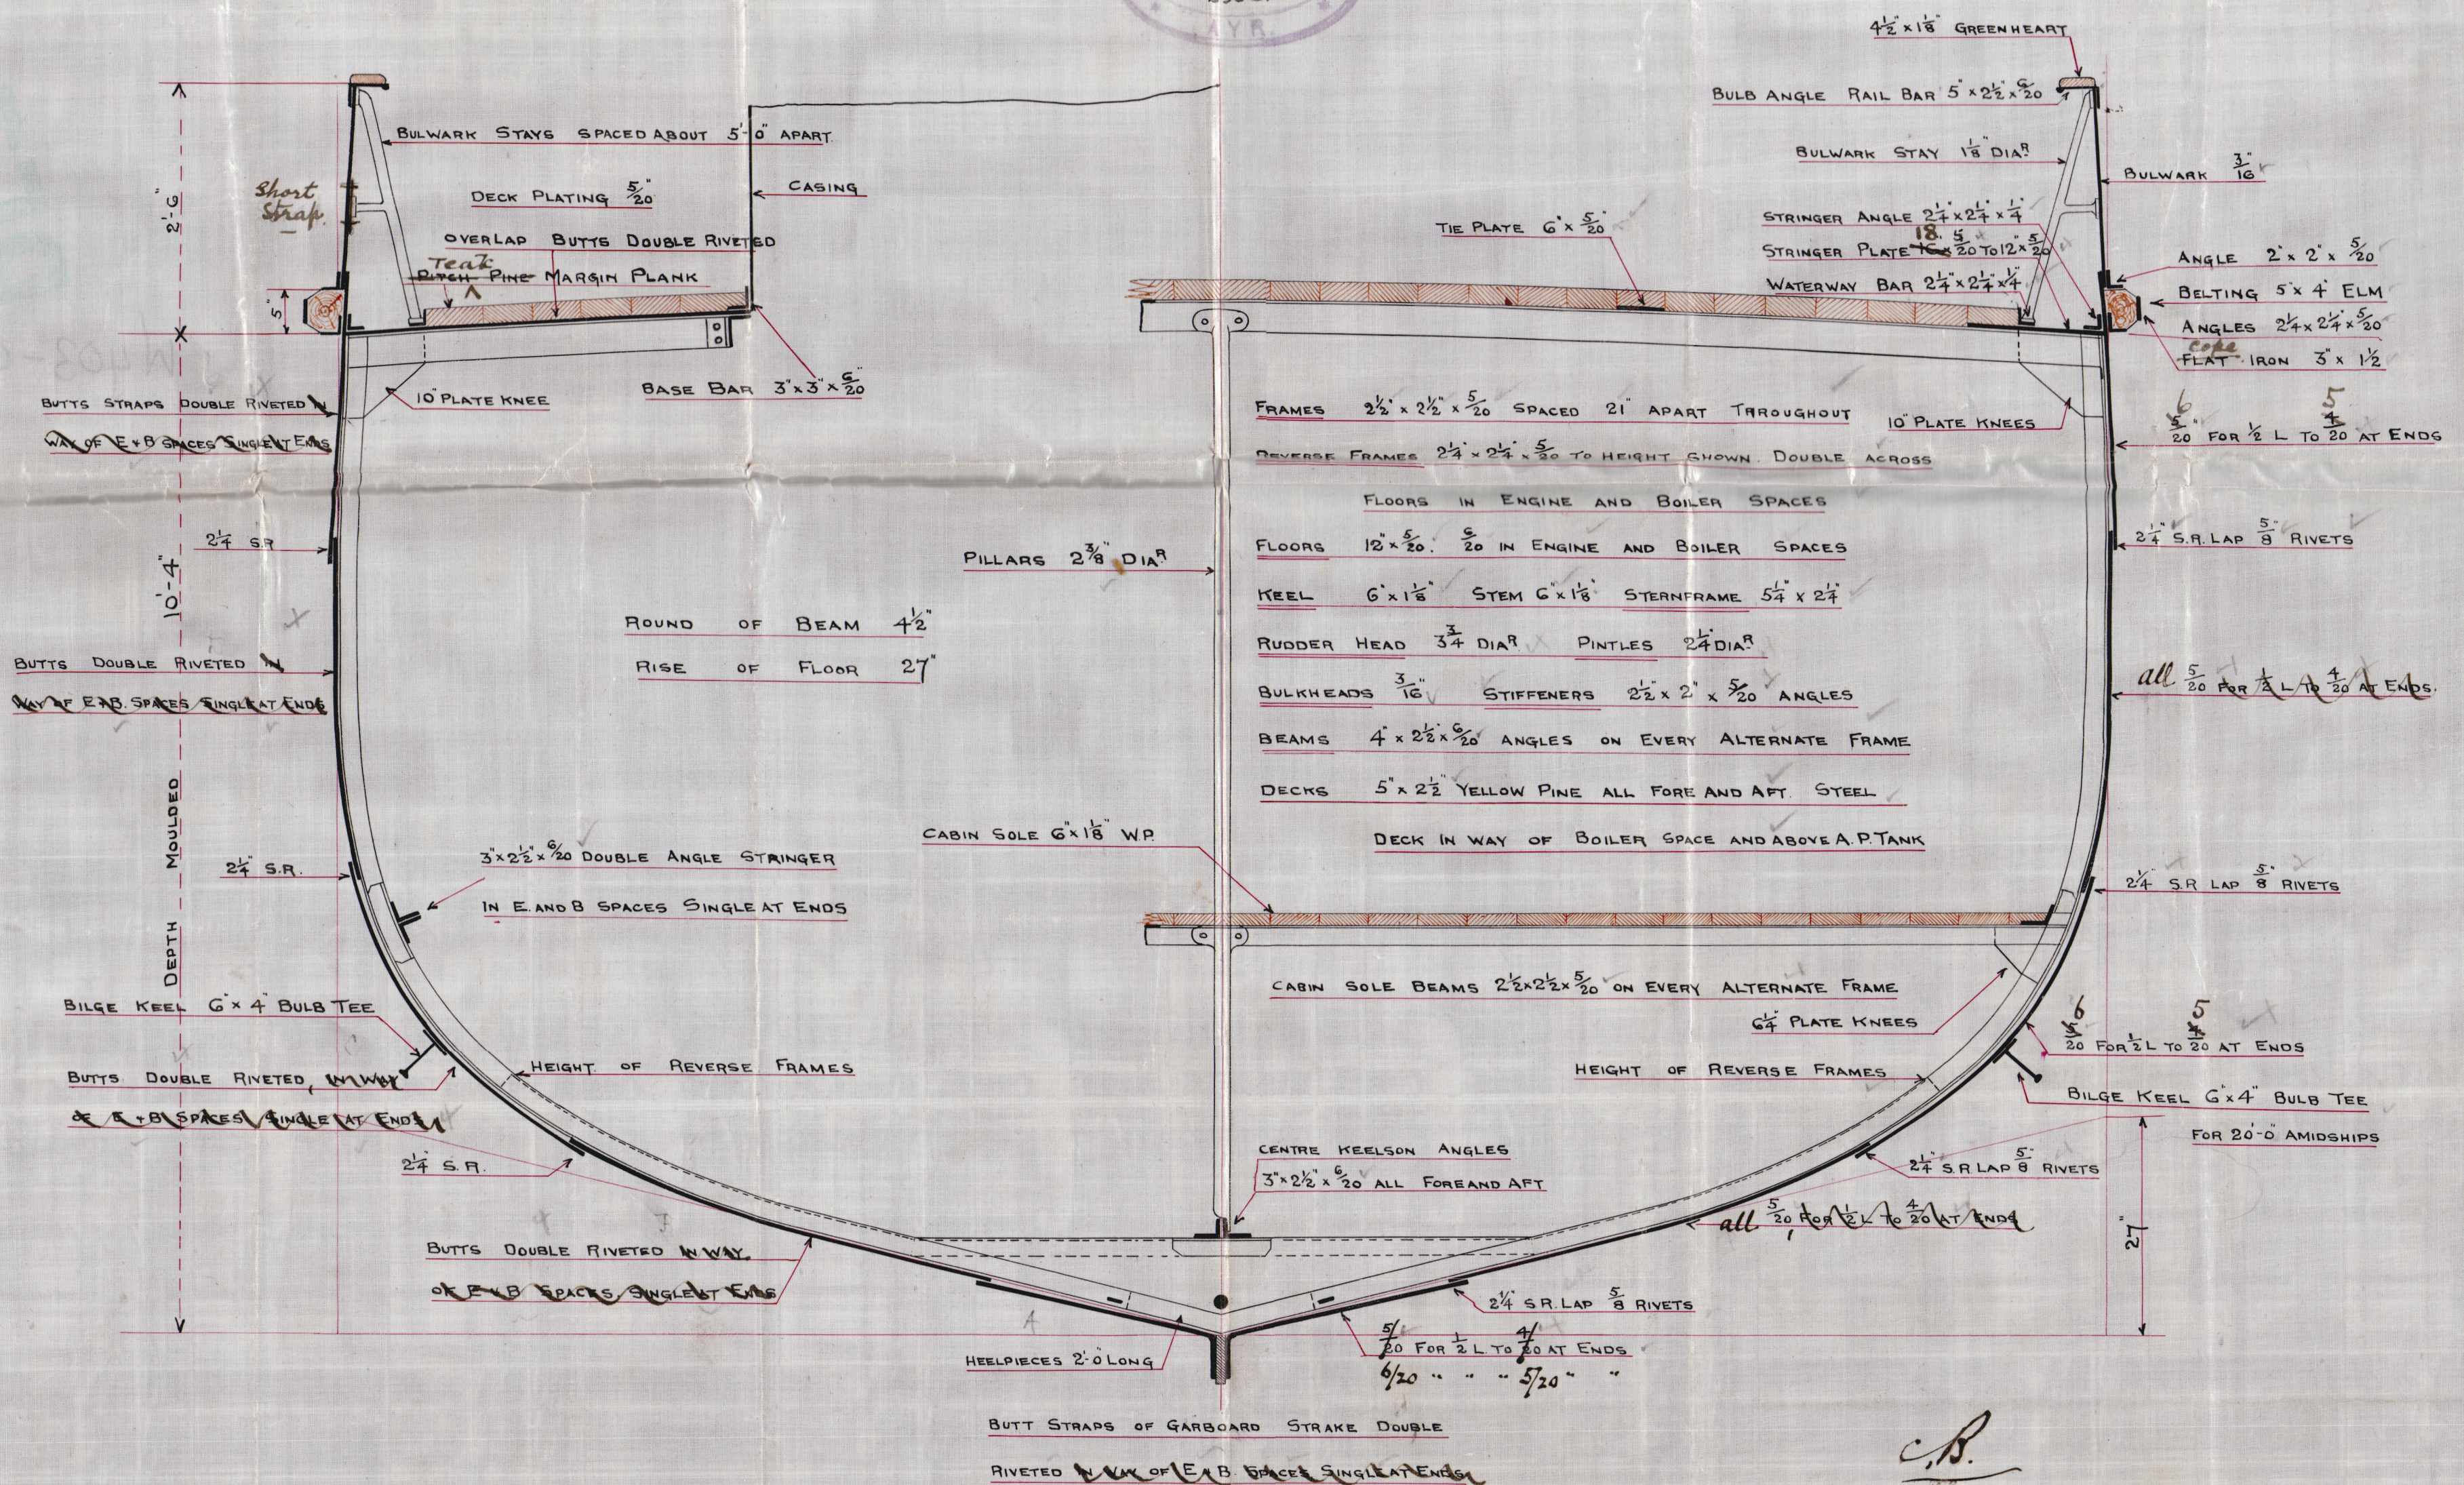

C.B.  
21.12.04.



Guardaman  
Jes. nkt. no 2.3109

W403-0133  
Lloyd's Foundation

Lloyd's Register  
Foundation