

PROFILE & DECKS


N°418

DIMENSIONS LENGTH 383'-6" x 51'-11" MLD x 28'-9 1/2" MLD


SCALE 1/8" = 1 FOOT

ISHERWOOD SYSTEM (PATENT)




S.S. "HOME SIDE."

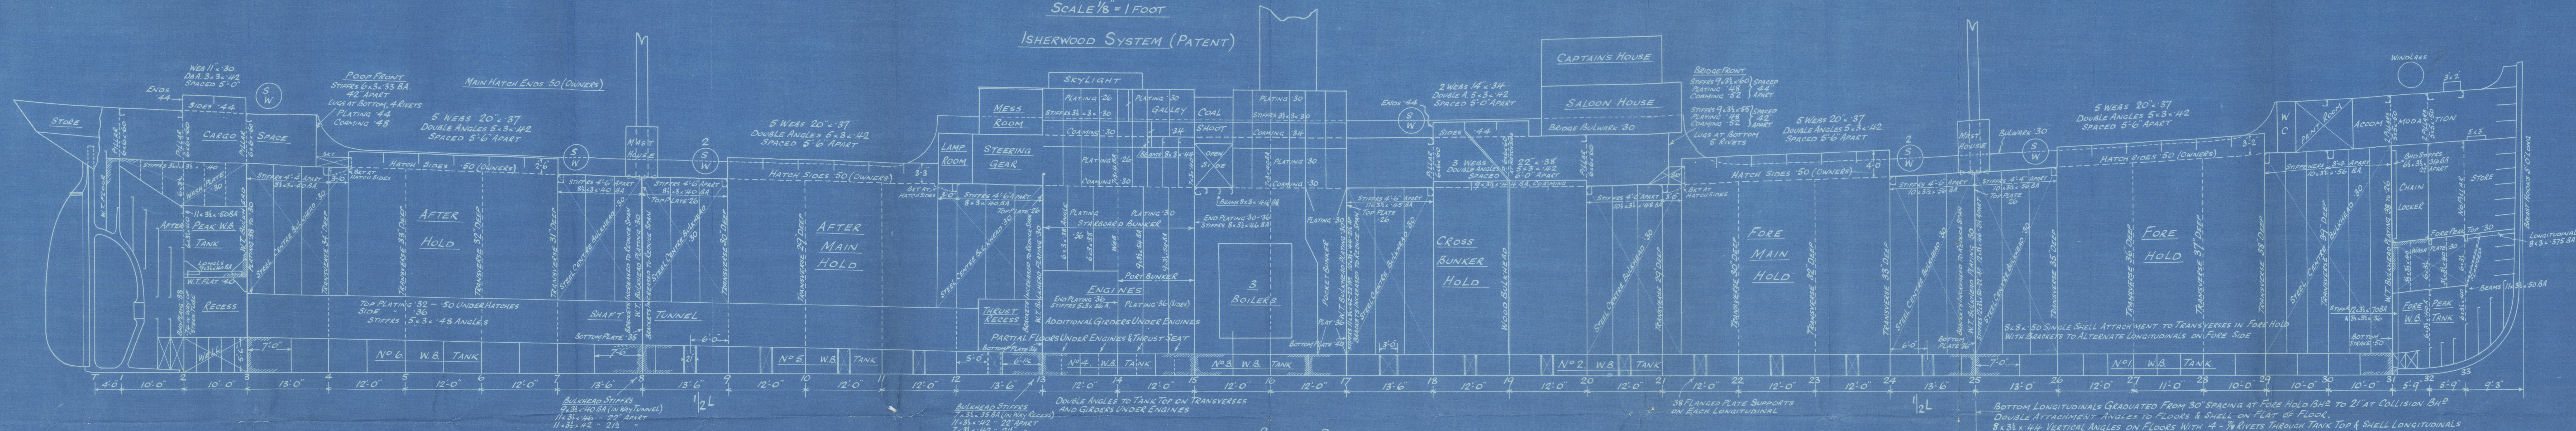

BRIDGE DECK

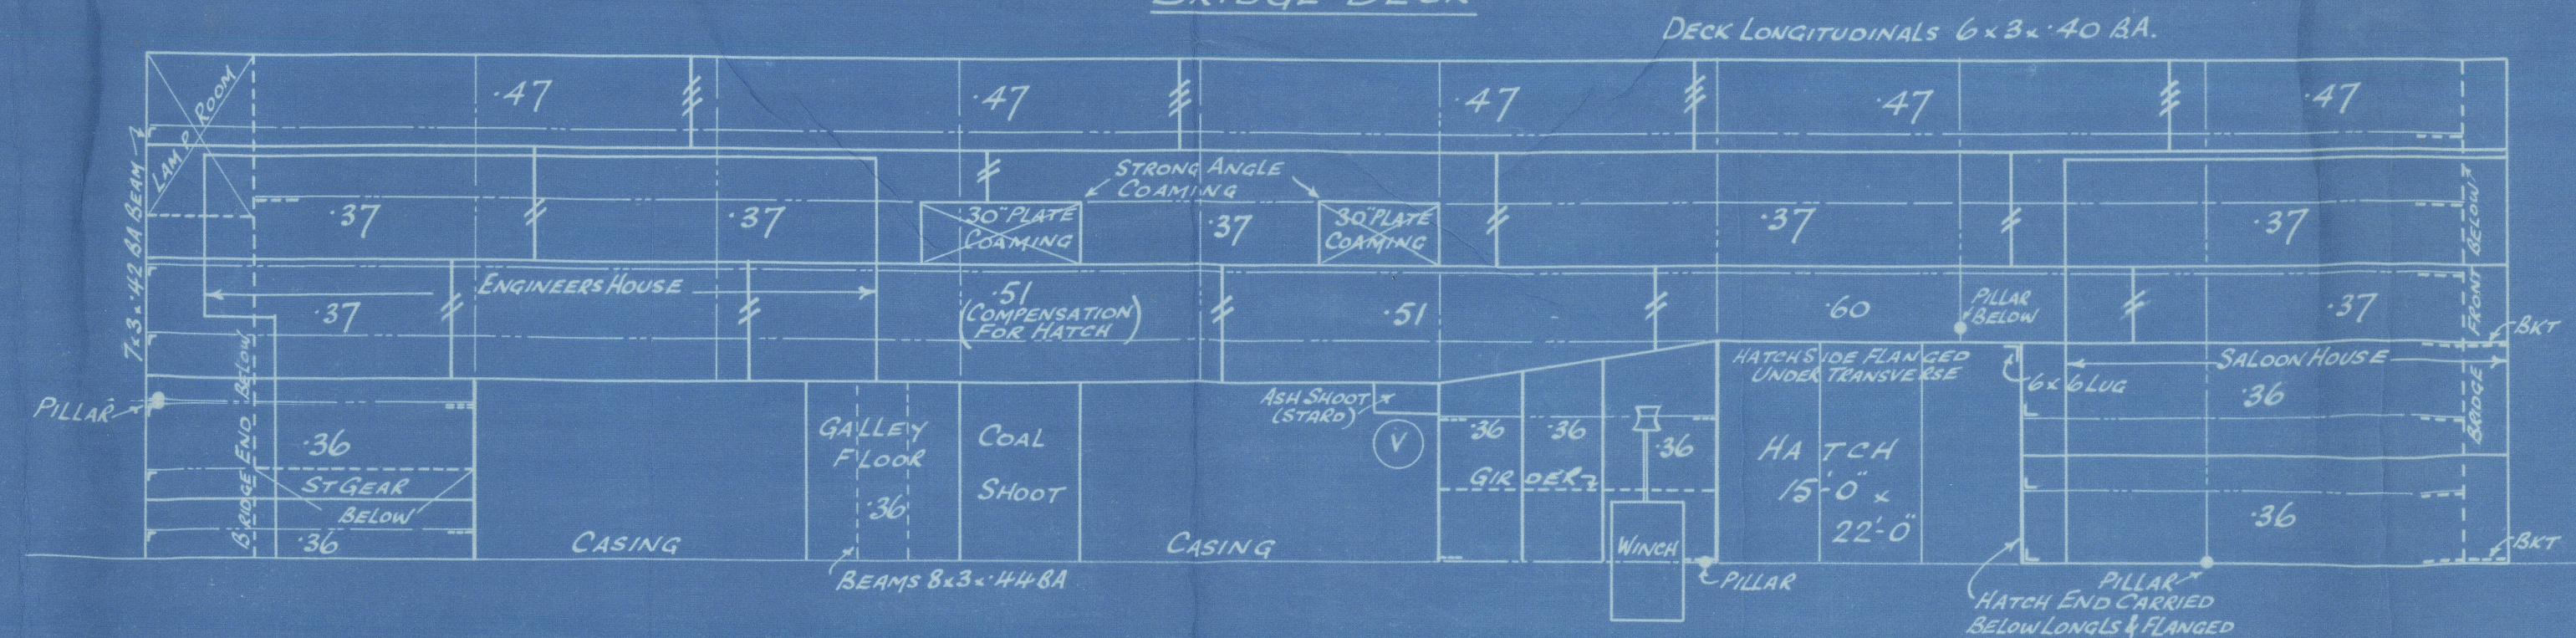

NOTE: LONGITUDINALS CONTINUOUS AT HATCH SIDES

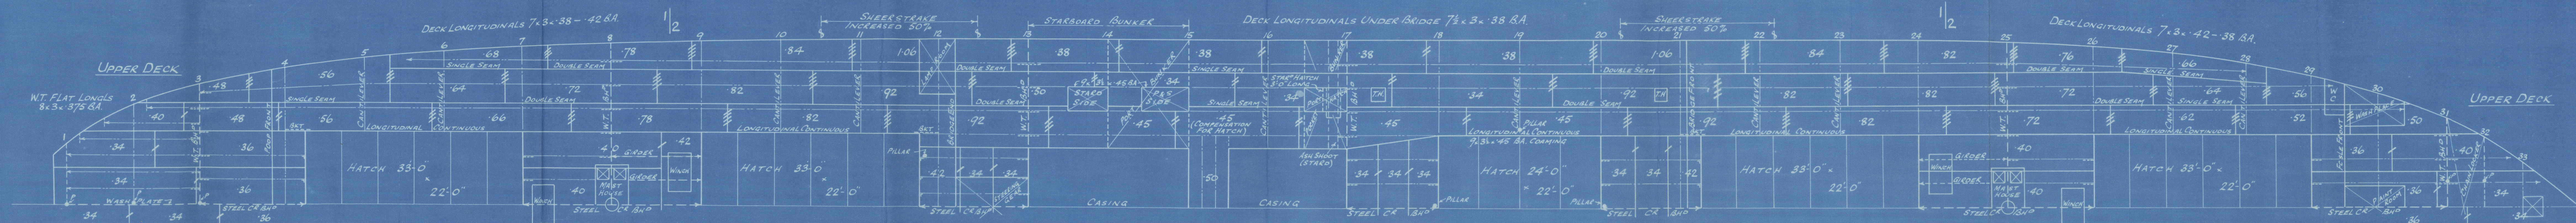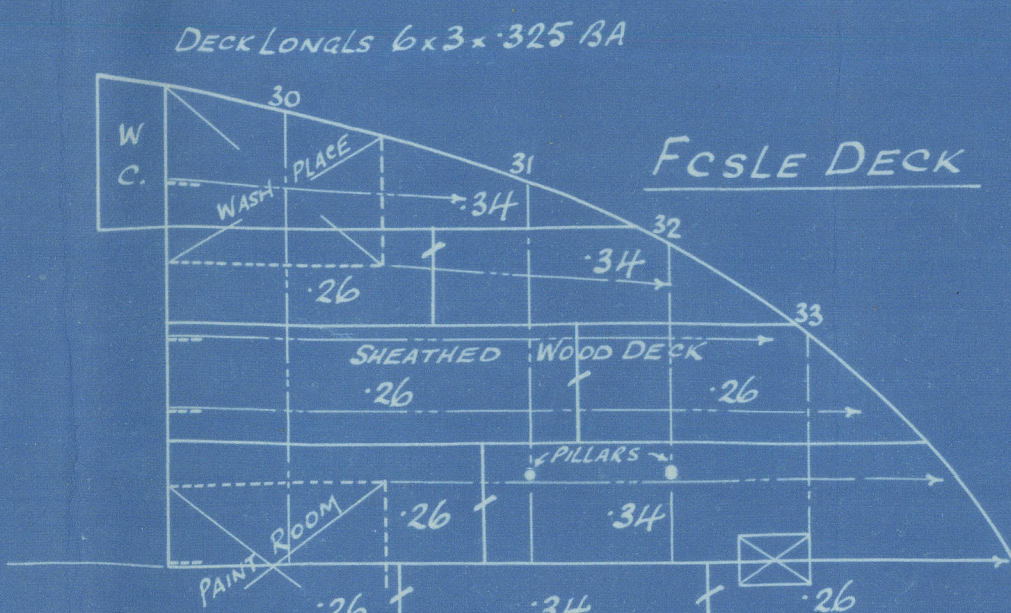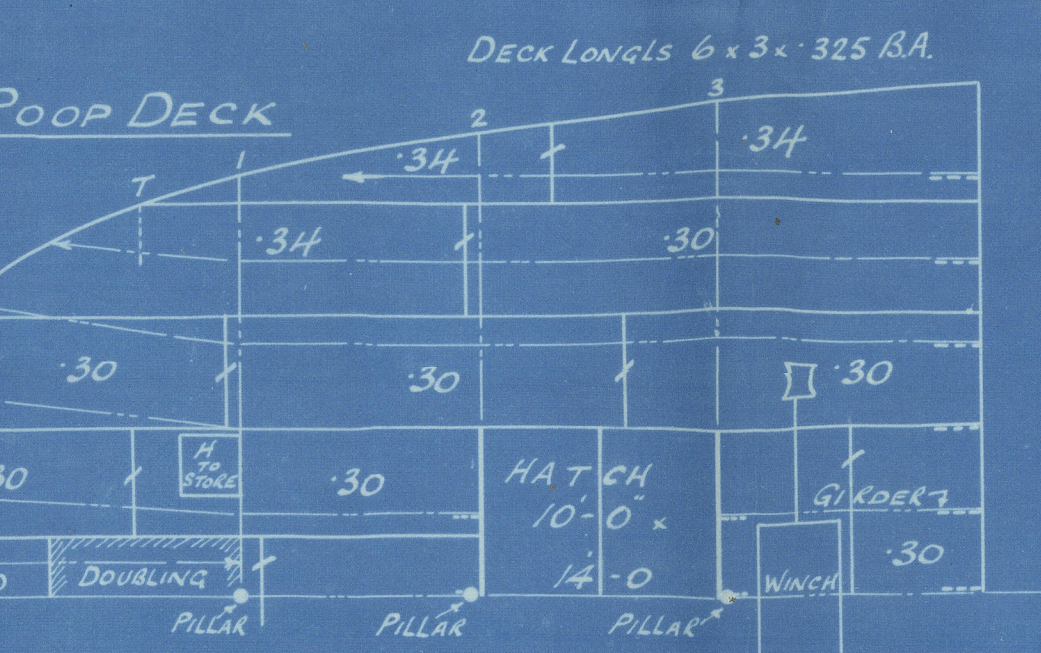

Profile (as built)

N^o 418

Short-Bros Lt-
Sunderland

S.S. "HOMESIDE"

SUNDERLAND BUILT. NO. 289K2

RETAIN

W 404-0053



© 2020

Lloyd's Register
Foundation