



6/2/25

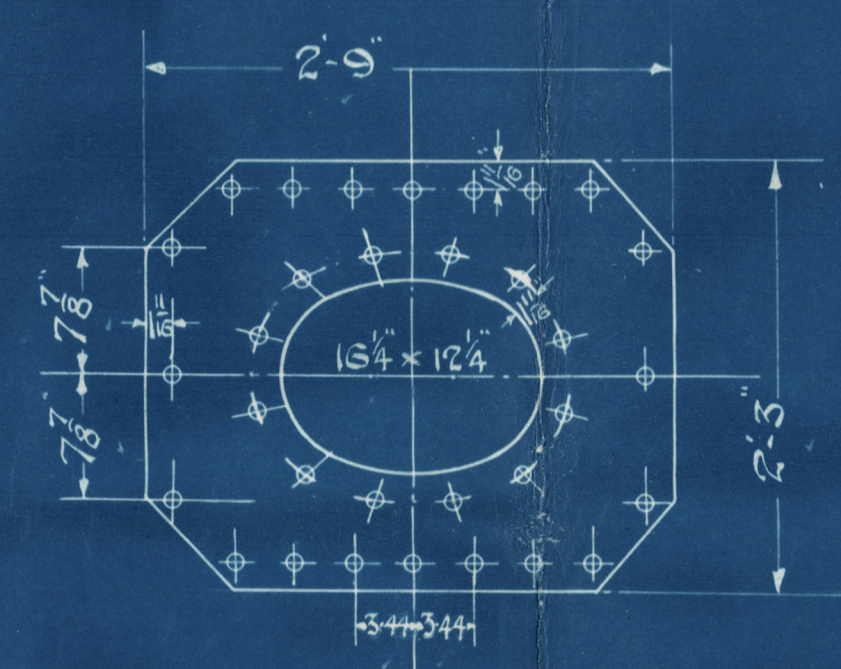

Shell Opening 15'-12"
 Manhole Doubling Plates 1 1/2" Thick
 Rivet Holes 1 1/2" Dia.
 M^cNeil's Doors.
 Bottom of Manhole Given Later.

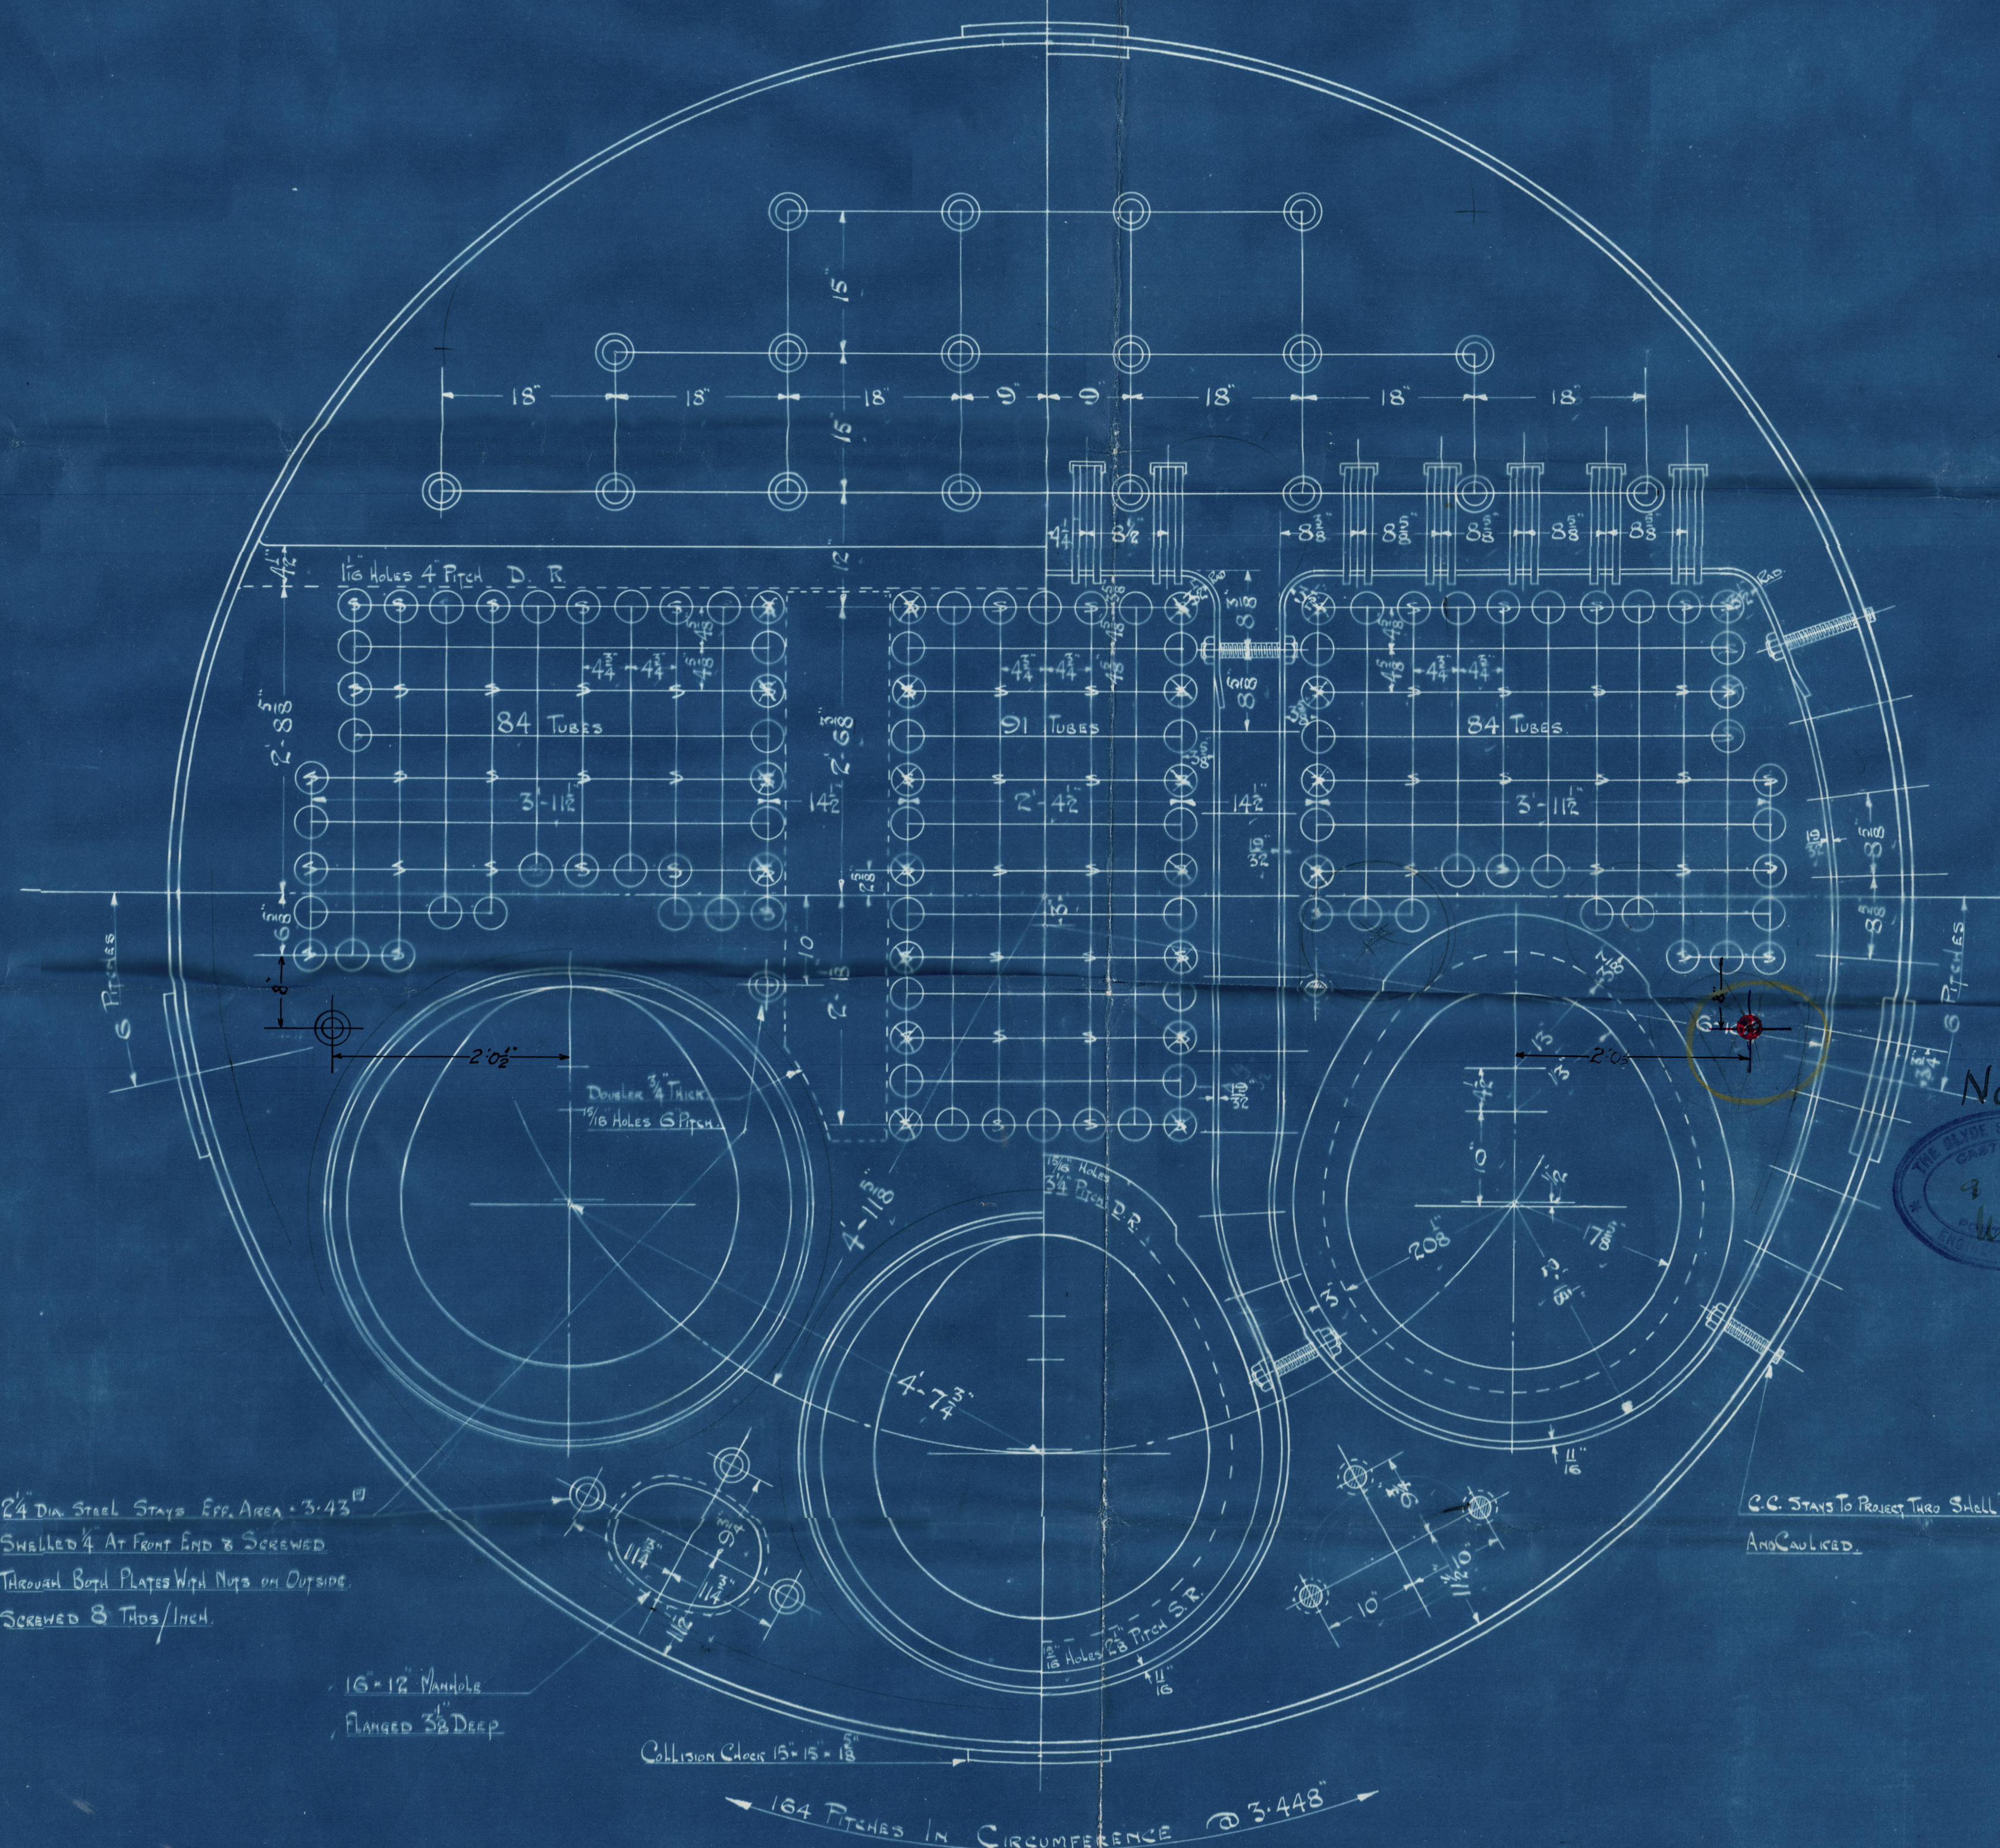


2 1/2" Dia. Steel Stays Eff. Area = 3.43"
 Shelled 4" At Front End & Screwed
 Through Bolt Plates With Nuts on Outside
 Screwed 8 Ties/Inch.

16'-12" Manhole
 Plunged 3 1/2" Deep.

2 1/2" Stays To Rivet Tubes Shell 1/4"
 And Caulked.

Noted
 4 FEB 1935
 H. W. LLOYD

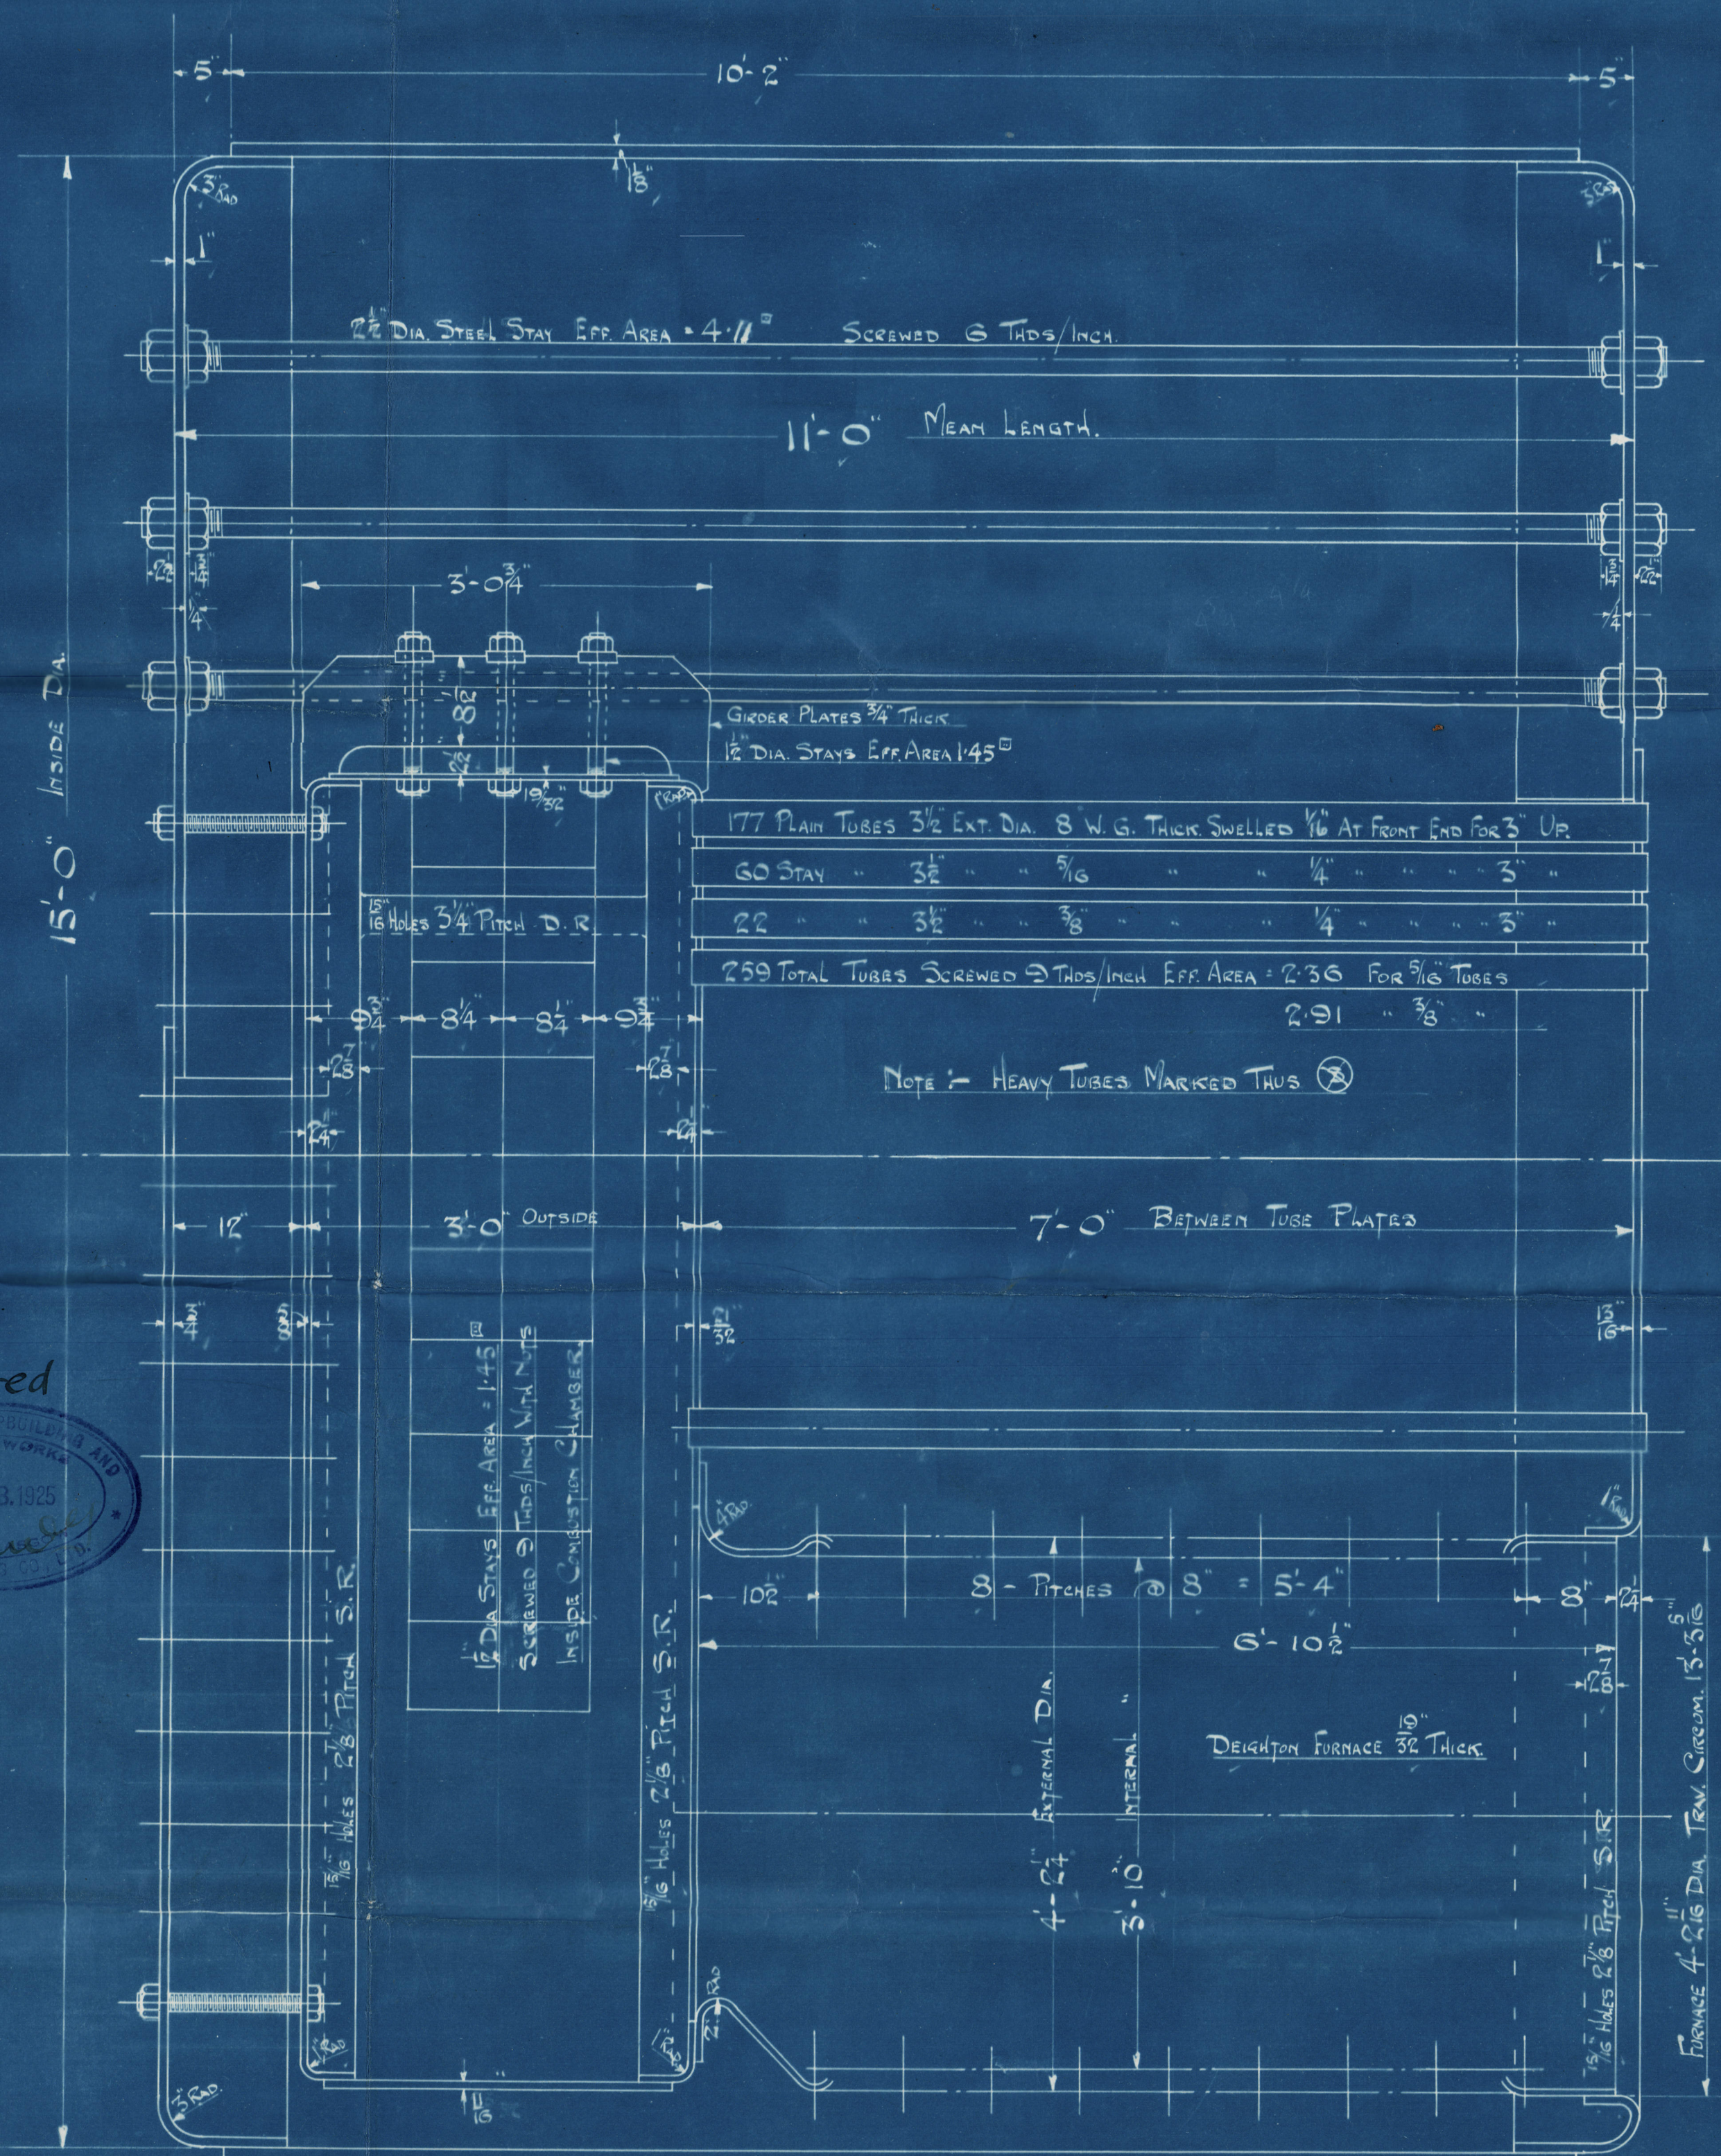


Girders Plates 3/4" Thick
 1 1/2" Dia. Stays Eff. Area 1.45"

177 Plain Tubes 3 1/2" Ext. Dia. 8 W.G. Thick Swelled 1/8" At Front End For 3" UP
 60 Stay " 3 1/2" " 5/16" " 1/4" " 3"
 22 " " 3 1/2" " 3/8" " 1/4" " 3"
 259 TOTAL TUBES SCREWED @ 8 TIES/INCH EFF. AREA = 2.36 FOR 7 1/2" TUBES
 2.91 " 3/8"

Note: Heavy Tubes Marked Thus ⊗

1 1/2" Dia. Stays Eff. Area = 1.45"
 Screwed @ 8 Ties/Inch With Nuts
 Inside Combustion Chamber.

DEIGHTON FURNACE 30" THICK

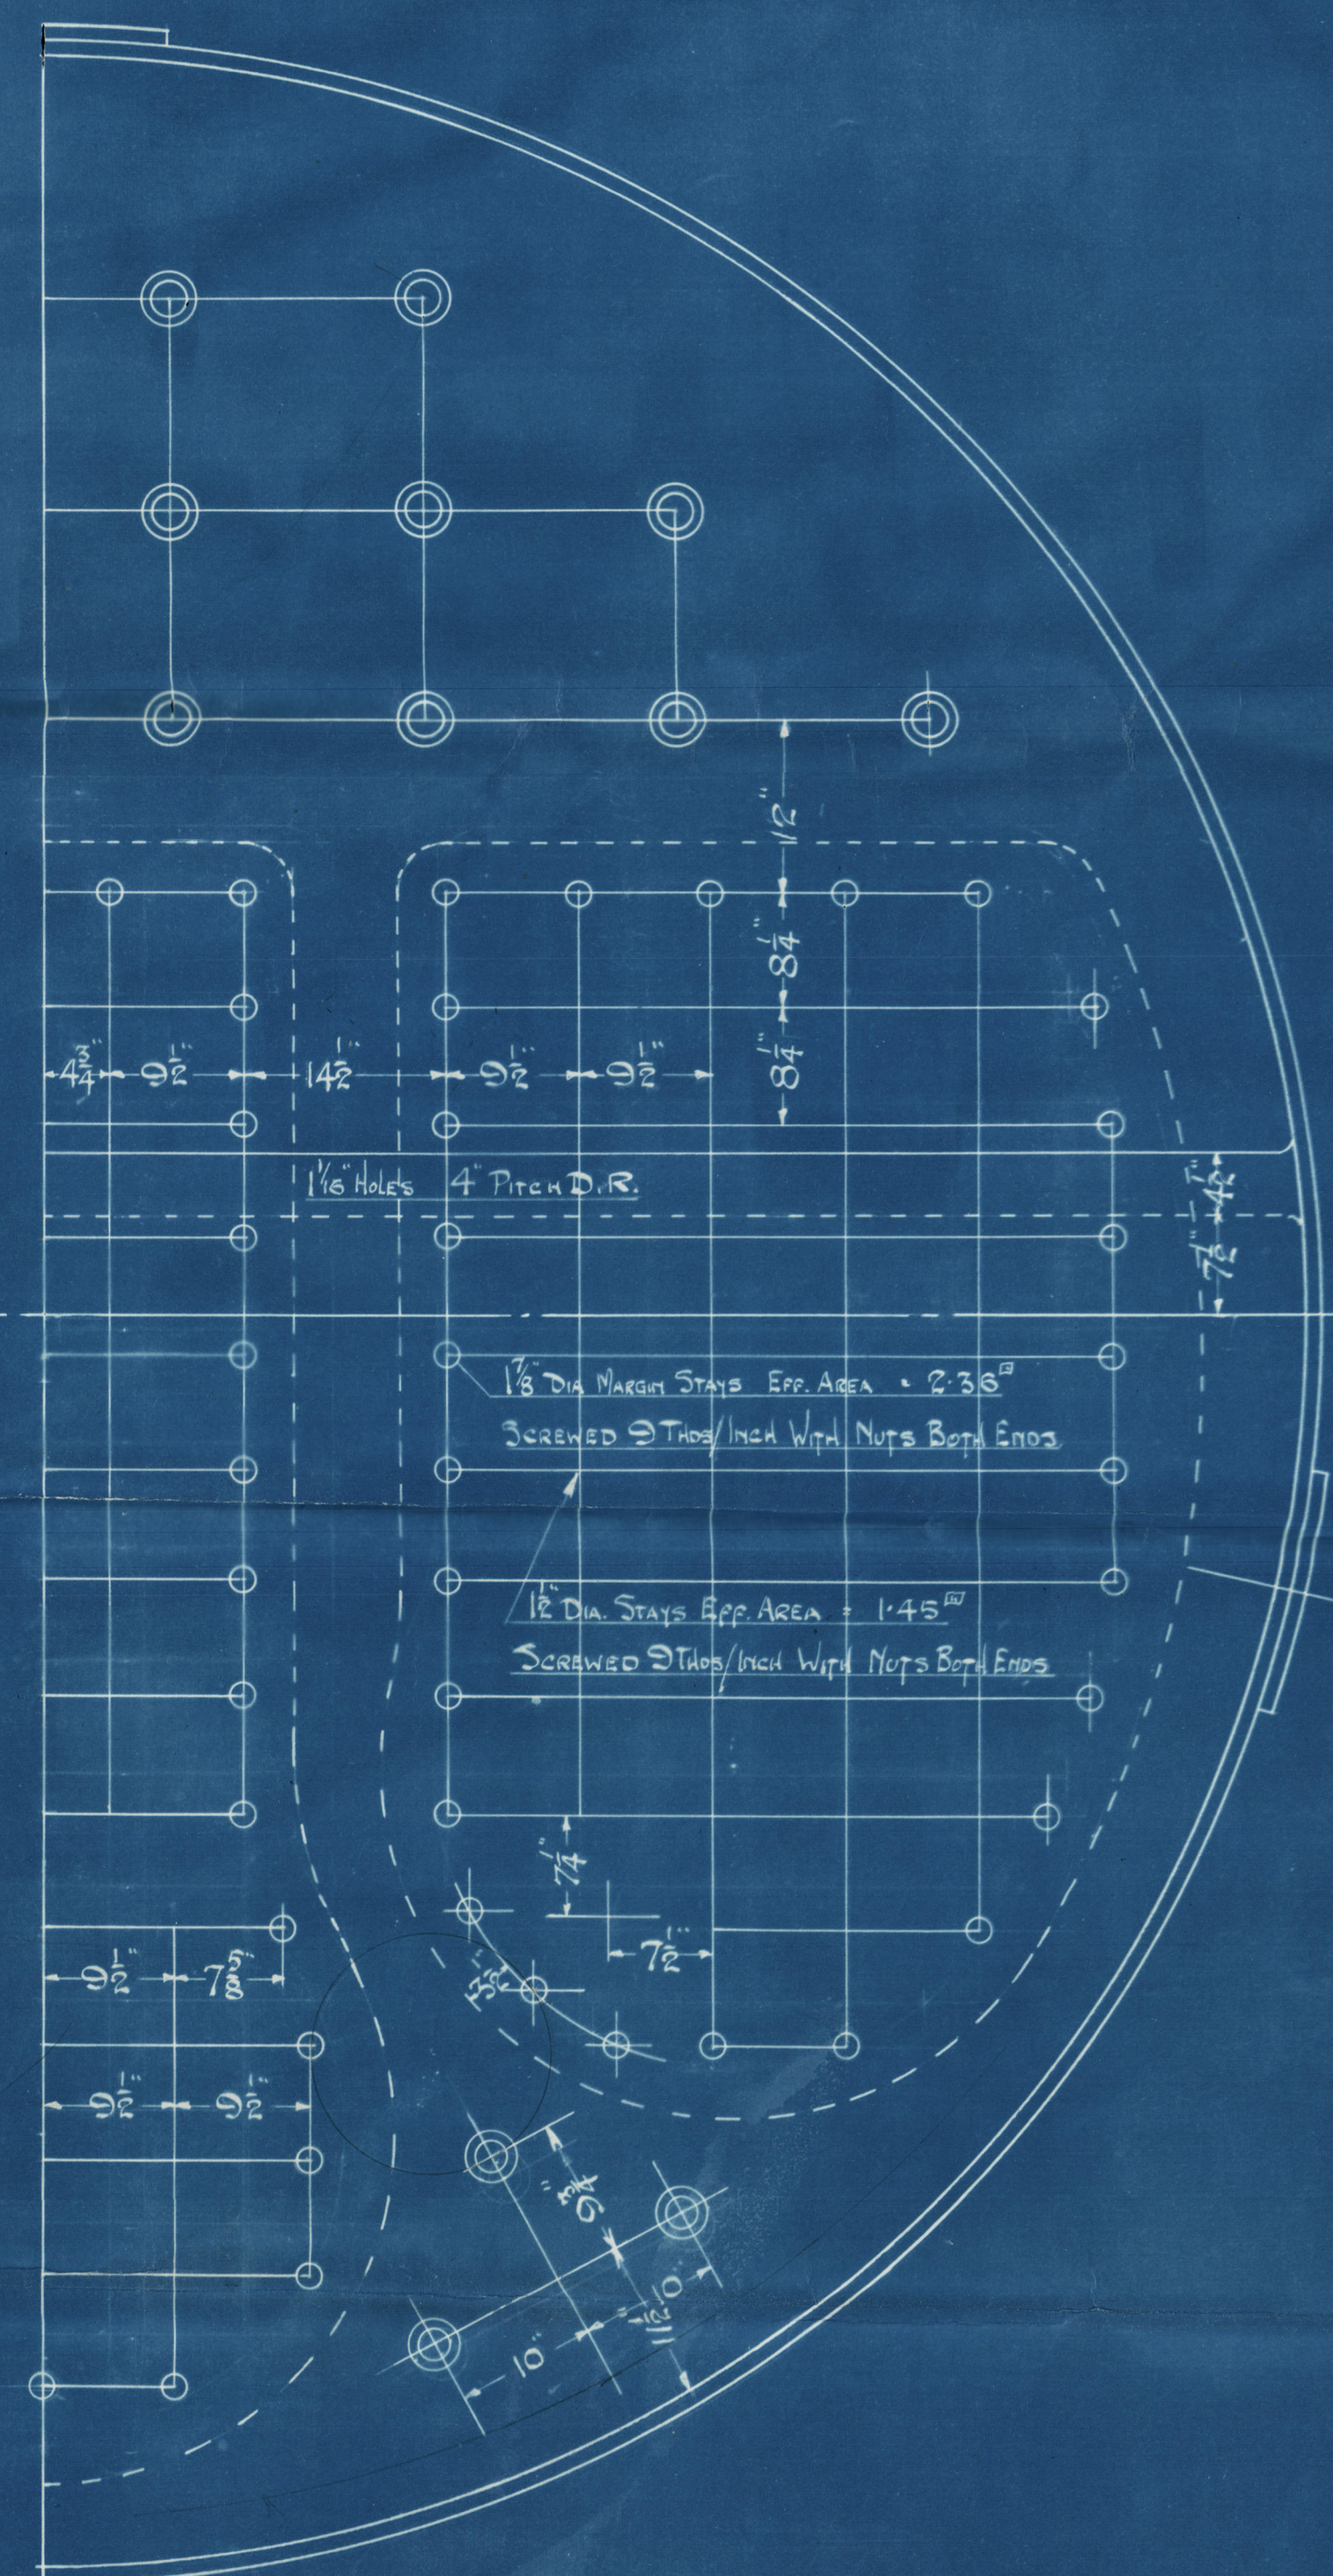

1 1/2" Dia. Manhole Stays Eff. Area = 2.36"
 Screwed @ 8 Ties/Inch With Nuts Both Ends
 1 1/2" Dia. Stays Eff. Area = 1.45"
 Screwed @ 8 Ties/Inch With Nuts Both Ends

Material and Tests

NAME OF PART	MATERIAL	TENSILE LIMIT	MINIMUM ELONGATION
Shell, Butt, Straps, Girders	STEEL	28,750 LBS	20% on Length
Comb. Chambers, Furnaces, Flanged Plates	"	28,300 "	25% " "
Other Plates	"	28,300 "	20% " "
Longitudinal Stays	"	28,300 "	20% on Surface B
Comb. Chamber "	"	28,300 "	25% " "
Rivet Bars	"	28,300 "	25% " "
Tubes	IRON		


RIVETING

	LONG.	CIRCUM.
Rivet Hole Dia	1 1/2"	1 1/2"
Pitch	7 1/2"	3.448"
% PLATE	85.7	67.5
% RIVET	86.48	42.08
% COMB.	88.75	

SURFACES

PART	SQ FEET
H.S. IN TUBES	1682
" FURNACES	135
" COMB. CHAM.	303
" TOTAL	2100
G.S. 5'-6" BARS	63

Note: All Rivet Holes Drilled In Place, Plates Afterwards Taken Apart and Bars Removed
 To P. H. LLOYD'S SURVEY FOR A WORKING PRESSURE OF 150 LBS/SQ
 TEST PRESSURE 200 LBS/SQ

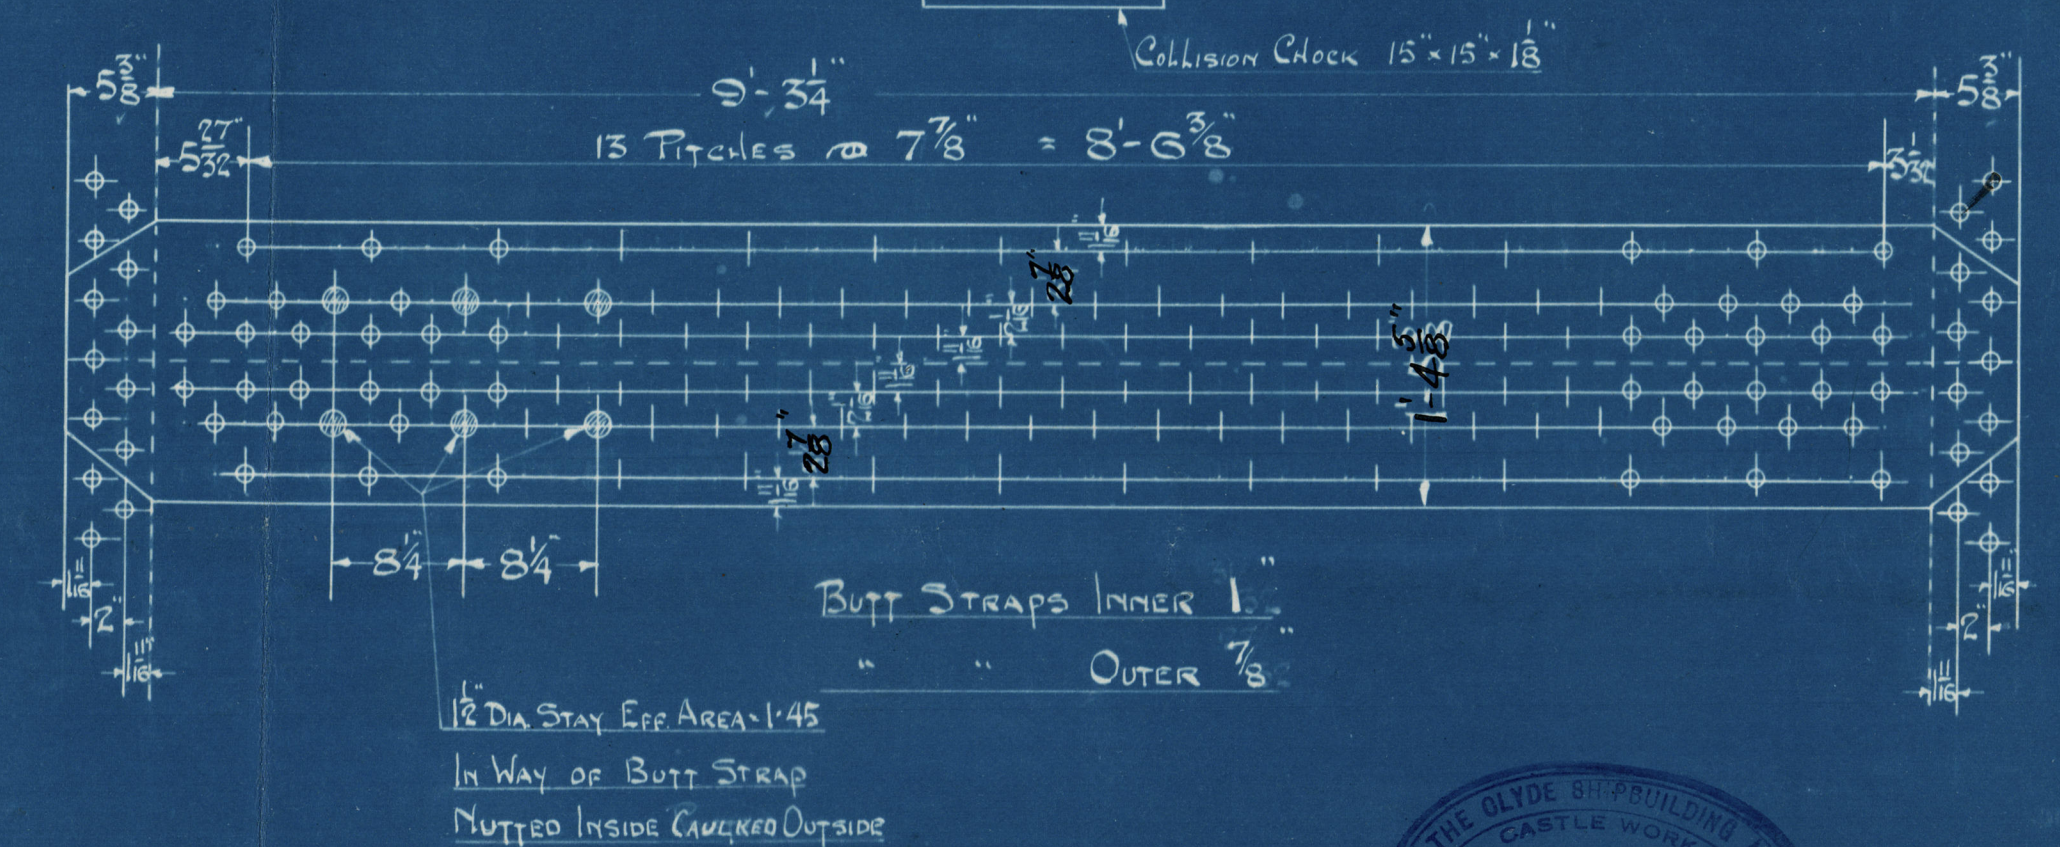

1 1/2" DIA STAY EFF. AREA 1.45"
 IN WAY OF BUTT STRAP
 NUTTED INSIDE CAULKED OUTSIDE

 27 JAN 1935
 H. W. LLOYD
 ENGINEERING CO. LTD

MAIN BOILER
 SO 918

SCALE 1" = 1'-0"

7571

W 405-0114

RETAIN


Clyde S B & E Co.
Port Glasgow.
S O 918,
New Boiler for
SS "ACHROITE"

W.P. 160 LBS

Greenock Shipyard No. 18449

RETAIN

W405-01442019

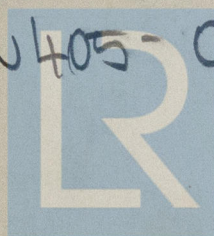

Lloyd's Register
Foundation