


Solid Wing Stay
now taken out.

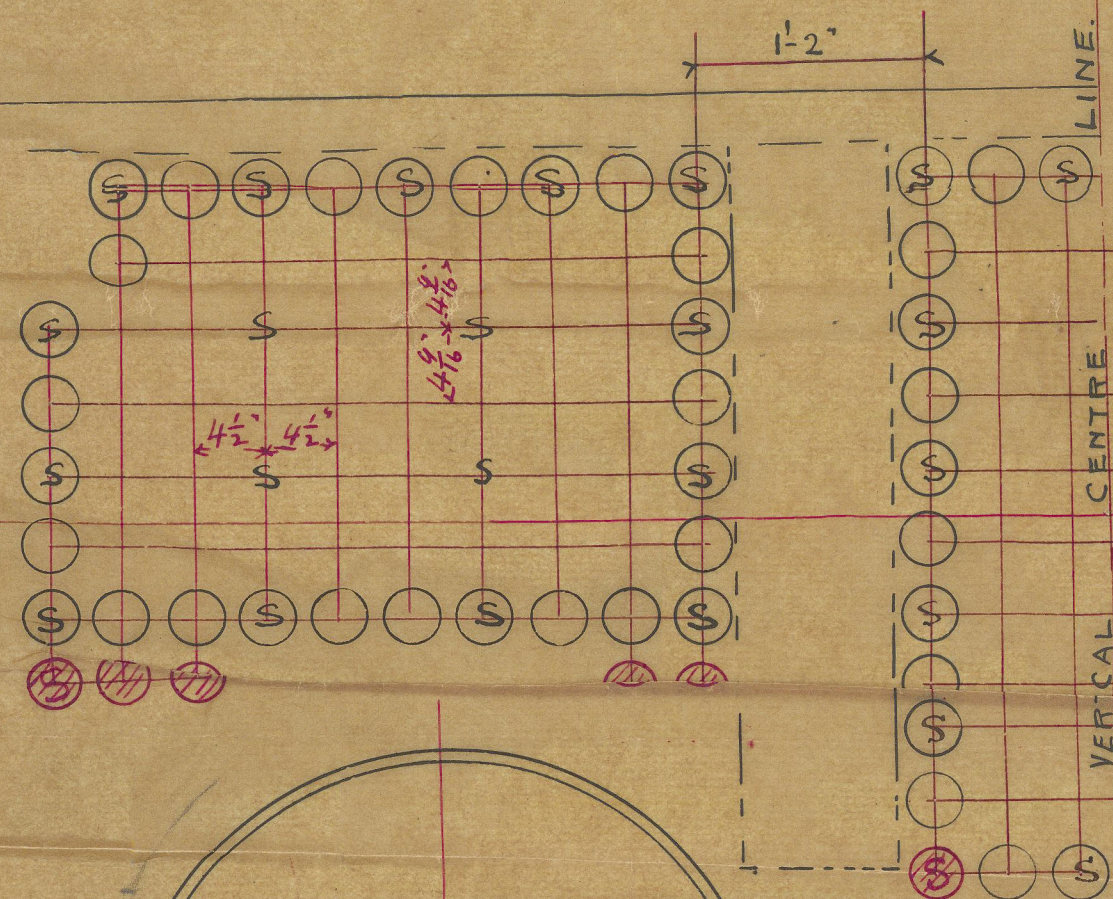

12 additional tubes to be fitted
6 on each side of Vert Centre line as shown in Red

Amended H.S. 1540 of total

Amended Drawing of Blr N°1012
showing additional tubes
to be fitted.

