


MIDSHIP SECTION

SS N°133

TO CLASS 100 A.I. AT LLOYDS + STEEL

DIMENSIONS:- 155'-0" B.P. 25'-6" MLD x 12'-3" DEPTH MLP


SCALE 1/2" IN. = ONE FOOT

EQUIPMENT			
1 ST AND 2 ND BOWER ANCHOR EACH	10 1/2 CWTs	COLLECTIVE	CWTs OR LBS.
3 RD " " "	8 3/4 " "	WEIGHT	STOCKLESS
1 STREAM ANCHOR	3 1/2 CWTs	EX STOCK	4 - 1 - 14
1 KEDGE " "	1 1/2 " "	" "	1 - 3 - 14
165 FATHOMS 1 1/2" STUB CHAIN CABLE	95 - 1 - 9		
60 1/2" x 3 1/2" STEEL WIRE (STREAM)			
75 - 2 1/2" " (TOWLINE)			
90 - 1 1/2" " (HANSER)			

NUMERALS	
HALF GIRTH	= 23.18
HALF BREADTH	= 12.75
DEPTH	= 12.78
1 ST NUMERAL	= 48.72
2 ND NUMERAL	= 153.94
3 RD NUMERAL	= 749.41
EQUIPMENT NUMERAL	= 8489.97
PROPORTIONS	
DEPTHS TO LENGTH	= 12.04
BREADTHS TO LENGTH	= 6.03
ERECTOR'S	
QUARTER DECK	= 82.25 x 3.75 x 2 = 618
BRIDGE	= 10.50 x 7.0 x 1.5 = 112
FORECASTLE	= 25.00 x 7.0 x 1.5 = 262
	117.75
114.75 - 153.94 = 70	
70.88 - 11.75 = 59.13	
712.31	

Modified

85.75 x 3.75 x 2 = 643
 9.92 x 7.0 x 1.5 = 104
 23.25 x 7.0 x 1.5 = 234
 991

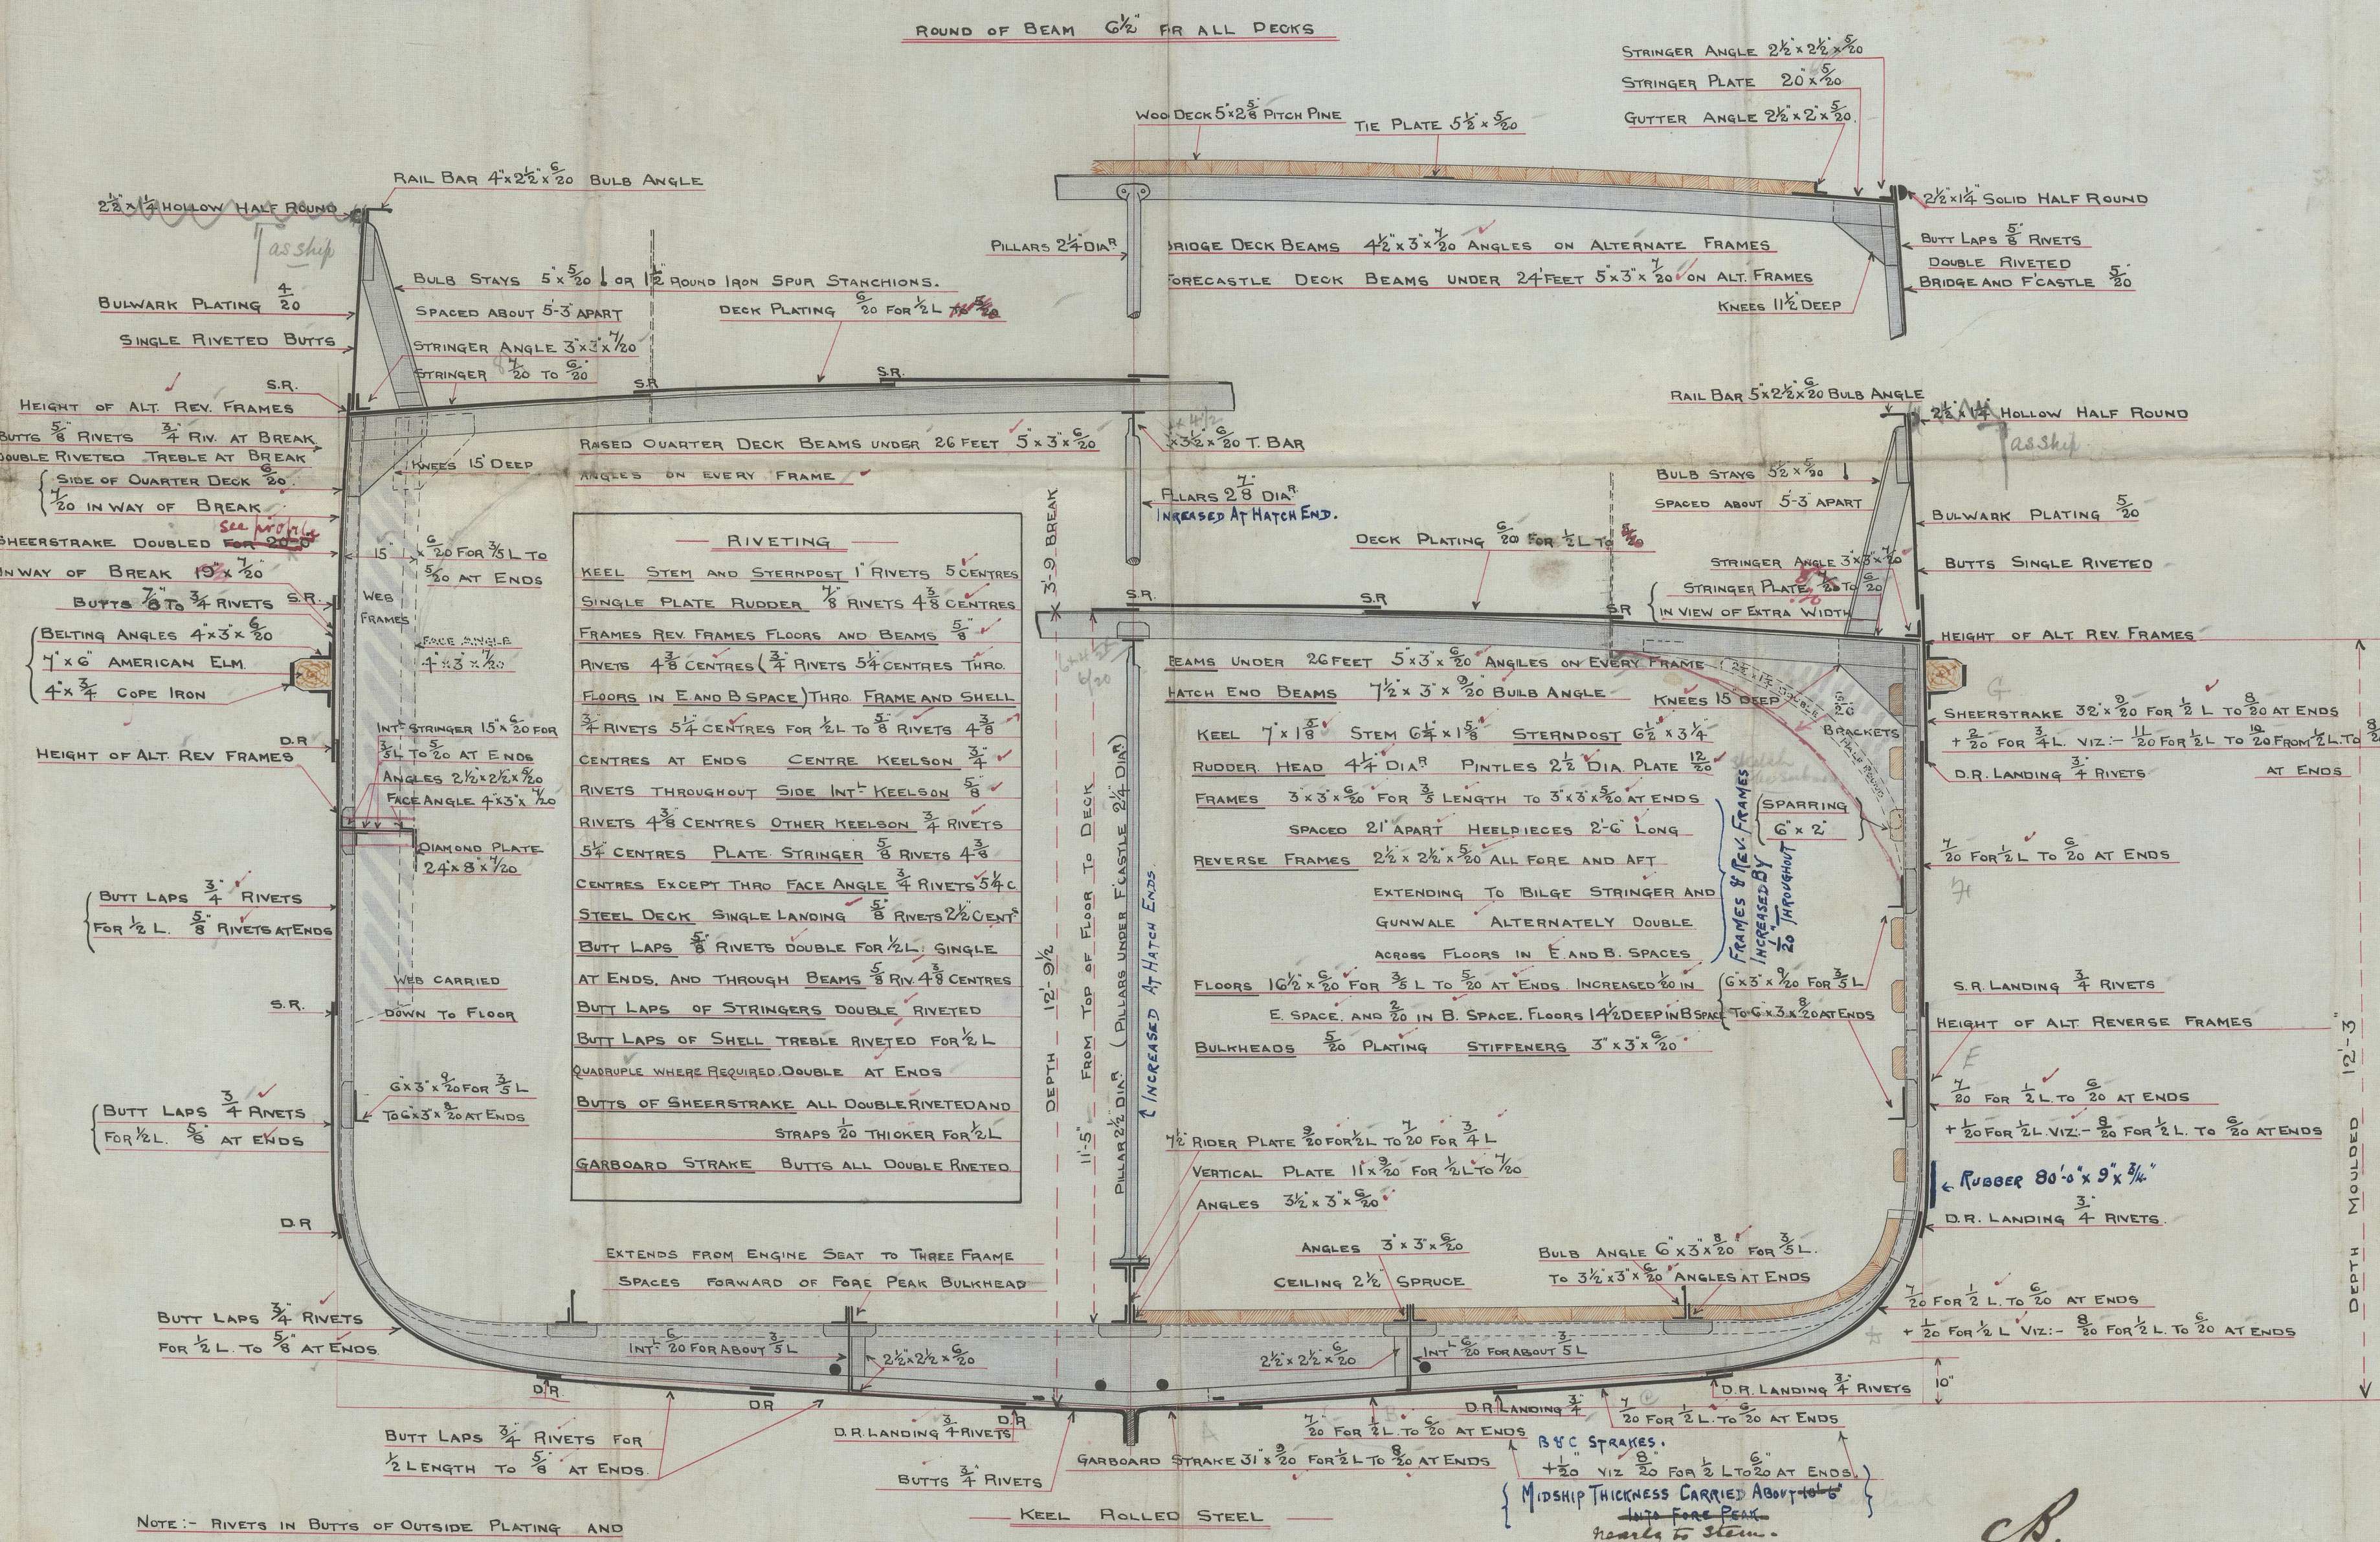

NOTE:- RIVETS IN BUTTS OF OUTSIDE PLATING AND STRINGERS SPACED 3/4" DIA. APART AND 4" TO 4 1/2" DIA. IN EDGES OF PLATING AND AT OTHER PARTS

Handwritten signature/initials

5.10.04

Midship Section
ailed 8 B Q's 133

n/n "Kyle Lirth"

ex
Senga
Glasgow rpt. no. 22740

Kyle Lirth

Senga

RETAIN



© 2019

Lloyd's Register

Foot 0048