

MIDSHIP SECTION.
SAILING BARQUE N^o 88.
TO CLASS 100 A. I. STEEL.
SCALE $\frac{1}{2}$ INCH = 1 FOOT.

DEPTH. 25.14 ✓
HALF BREADTH. 19.5 ✓
GIRTH. 40.1 ✓
 $1\frac{37}{100}$ IN² $84.74 \times 250.5 = 21227 = 2\frac{77}{100}$ IN².
+ $\frac{15}{100}$ for erections. 1415
22642 = EQUIP²

EQUIPMENT.


2 BOWER ANCHORS $3\frac{1}{2}$ CWT. EX STOCK } COLLEGE W^T W^T
1 " " " " " " " " } 104 CWT.
1 STREAM " " " " " " " " }
1 KEDGE " " " " " " " " }
270 FATHOMS $1\frac{15}{16}$ STUD CHAIN CABLE (MIN. W^T 51-1-14)
75 " " " " " " " " (MIN W^T STUD 43-1-9)
90 " " " " " " " " 11" TOWLINE OR 4" STEEL WIRE.
90 " " " " " " " " 10 $\frac{1}{2}$ " HANSEY OR 3 $\frac{3}{4}$ " " " " " " " "
90 " " " " " " " " 6 $\frac{1}{2}$ " WARP OR 2 $\frac{1}{2}$ " " " " " " " "

RIVETING.

KEEL, STEM, & STEERN POST 1 $\frac{1}{2}$ " RIVETS 5 $\frac{1}{2}$ " CENTRES.
 RUDDER ^{1 $\frac{1}{2}$ "} RIVETS ^{5 $\frac{1}{2}$ "} CENTRES.
 FRAMES THROUGHOUT $\frac{3}{4}$ " RIVETS 5 $\frac{1}{2}$ " CENTRES, THRO' FRAME &
 SHELL $\frac{1}{2}$ " RIVETS AMIDSHIPS 6 $\frac{1}{2}$ " CENTRES, TO $\frac{3}{4}$ " RIVETS AT
 ENDS, 5 $\frac{1}{2}$ " CENTRES.
 BEAMS $\frac{3}{4}$ " RIVETS 5 $\frac{1}{2}$ " CENTRES, THRO' STRINGERS & TIES $\frac{3}{4}$ " RIVETS.
 MAIN DECK STAB^{CS} BUTT LAPS TREBLE $\frac{1}{2}$ " RIVETS FOR $\frac{1}{2}$ L., DOUBLE AT
 ENDS. THREN DK. STAB^{CS} BUTT LAPS TREBLE $\frac{3}{4}$ " RIVETS FOR $\frac{1}{2}$ L.
 DOUBLE AT ENDS, OTHER BUTT LAPS OF STRINGERS & TIES DOUBLE $\frac{3}{4}$ " RIVETS.
 SHELL LANDINGS DOUBLE RIVETED WITH $\frac{1}{2}$ " RIVETS FOR $\frac{1}{2}$ L. 6 in SPACE,
 $\frac{3}{4}$ " RIVETS AT ENDS, 7 in SPACE, EXCEPT GARB^{CS} & LOWER EDGE
 OF SHEER STRAKE WHICH IS $\frac{1}{2}$ " RIVETS THROUGHOUT 6 in SPACE.
 BUTT STRAPS OF GARB^{CS} & SHEER STRAKES TO BE $\frac{3}{20}$ FOR $\frac{1}{2}$ L.
 $\frac{2}{20}$ THICKER AT ENDS & ALL TREBLE RIVETED, OTHER SHELL BUTTS
 LAPPED AND TREBLE RIVETED THROUGHOUT. ^{quadruple rivet}
 BUTTS OF POOF & FORECASTLE SIDES DOUBLE $\frac{3}{4}$ " RIVETS AND
 LANDINGS SINGLE RIVETED.
 CENTRE KEELSON $\frac{1}{2}$ " RIVETS, AND BUTT LAPS OF VERTICAL
 & RIDER PLATES TREBLE RIVETED WITH $\frac{1}{2}$ " RIVETS, ALL
 OTHER KEELSONS $\frac{3}{4}$ " RIVETS, 5 $\frac{1}{2}$ " CENTRES THROUGHOUT.

NOTES. RIVETS in BUTTS of OUTSIDE PLATING & STRINGER PLATES spaced not more than $3\frac{1}{2}$ dia $\frac{r}{s}$ apart.

PROPORTIONS.
BREADTH \bar{t} o LENGTH 6.42. ✓
DEPTH " " " 9.96. ✓

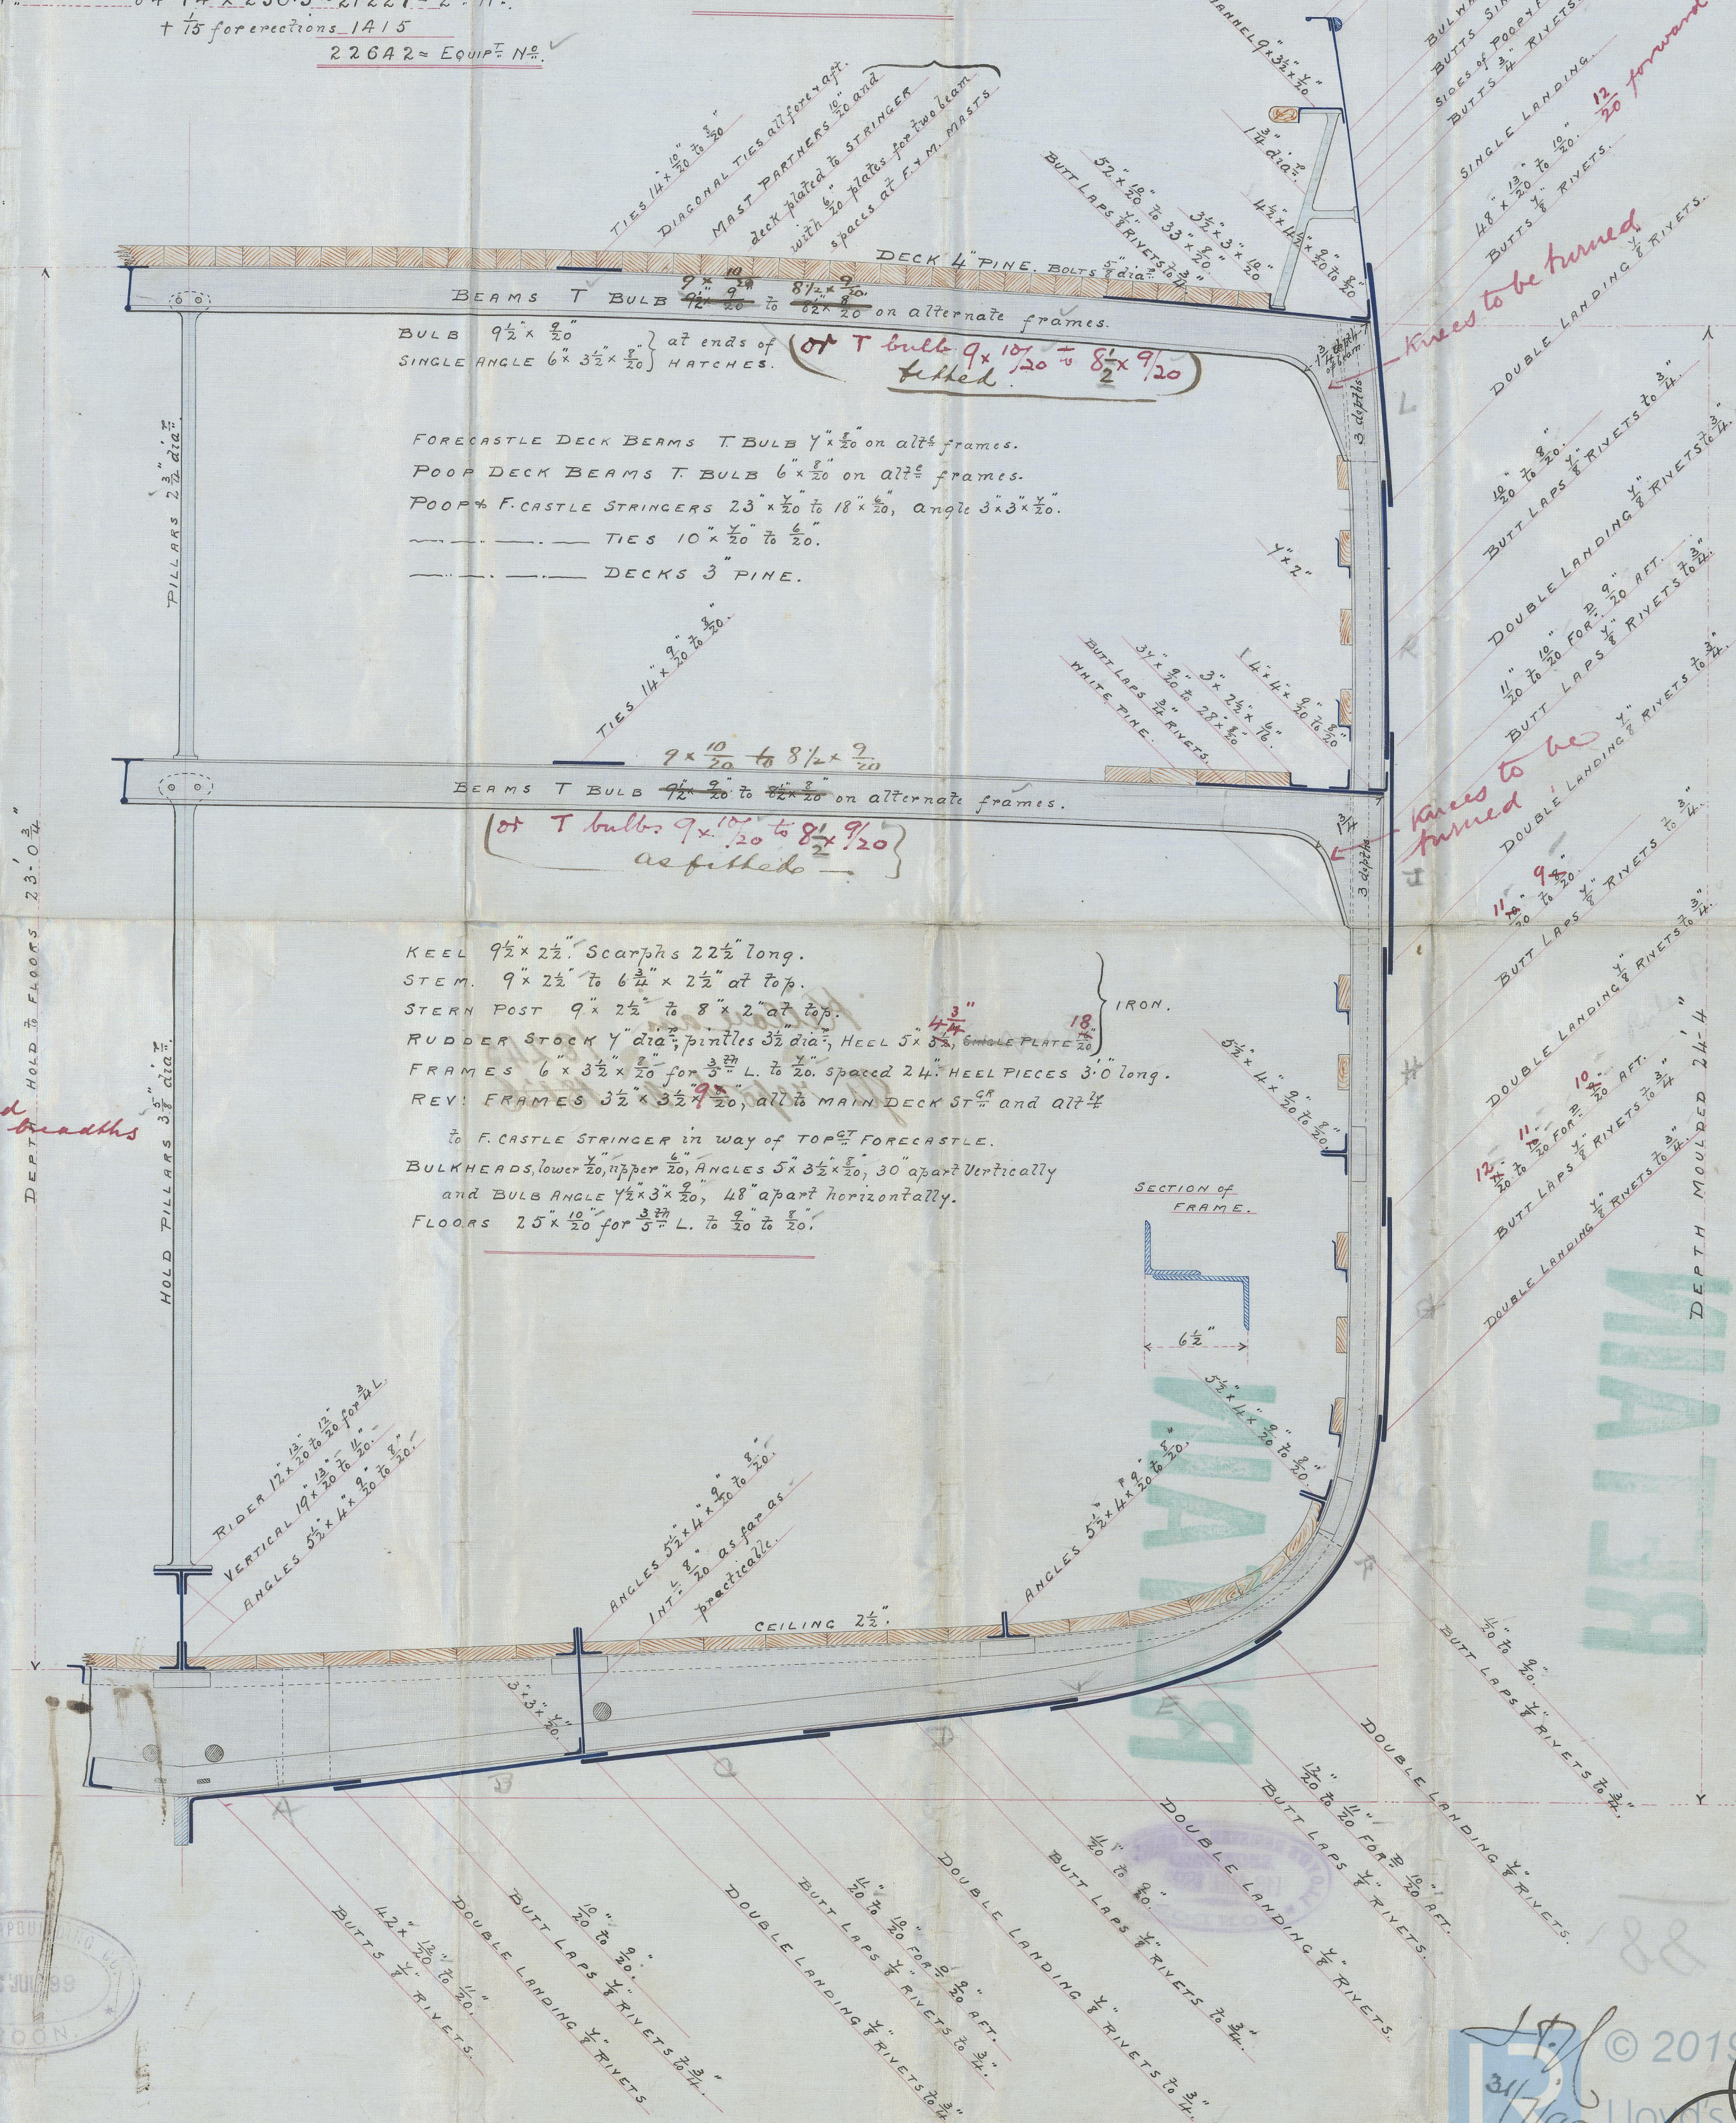

© 2019
Lloyd's Register
Foundation

Ailsa & Co

No: 88

"Killovan"

Glasgow Pt No. 18245

pp. 8.1
pp. 8.2



FRAMES THROUGHOUT THE KEEL 35 RIVETS, TWO FRAMES
KEEL, STEEL Y STEEL POST 17 RIVETS, 35 RIVETS.





RETAIN

RETAIN

Killouan 18245
Gls. report no 18136.

88

17/1/40
18/1/40
19/1/40



© 2019
Lloyd's Register
Foundation