


17.10.99

to what is shown  
in plan

RETAIN

RETAIN

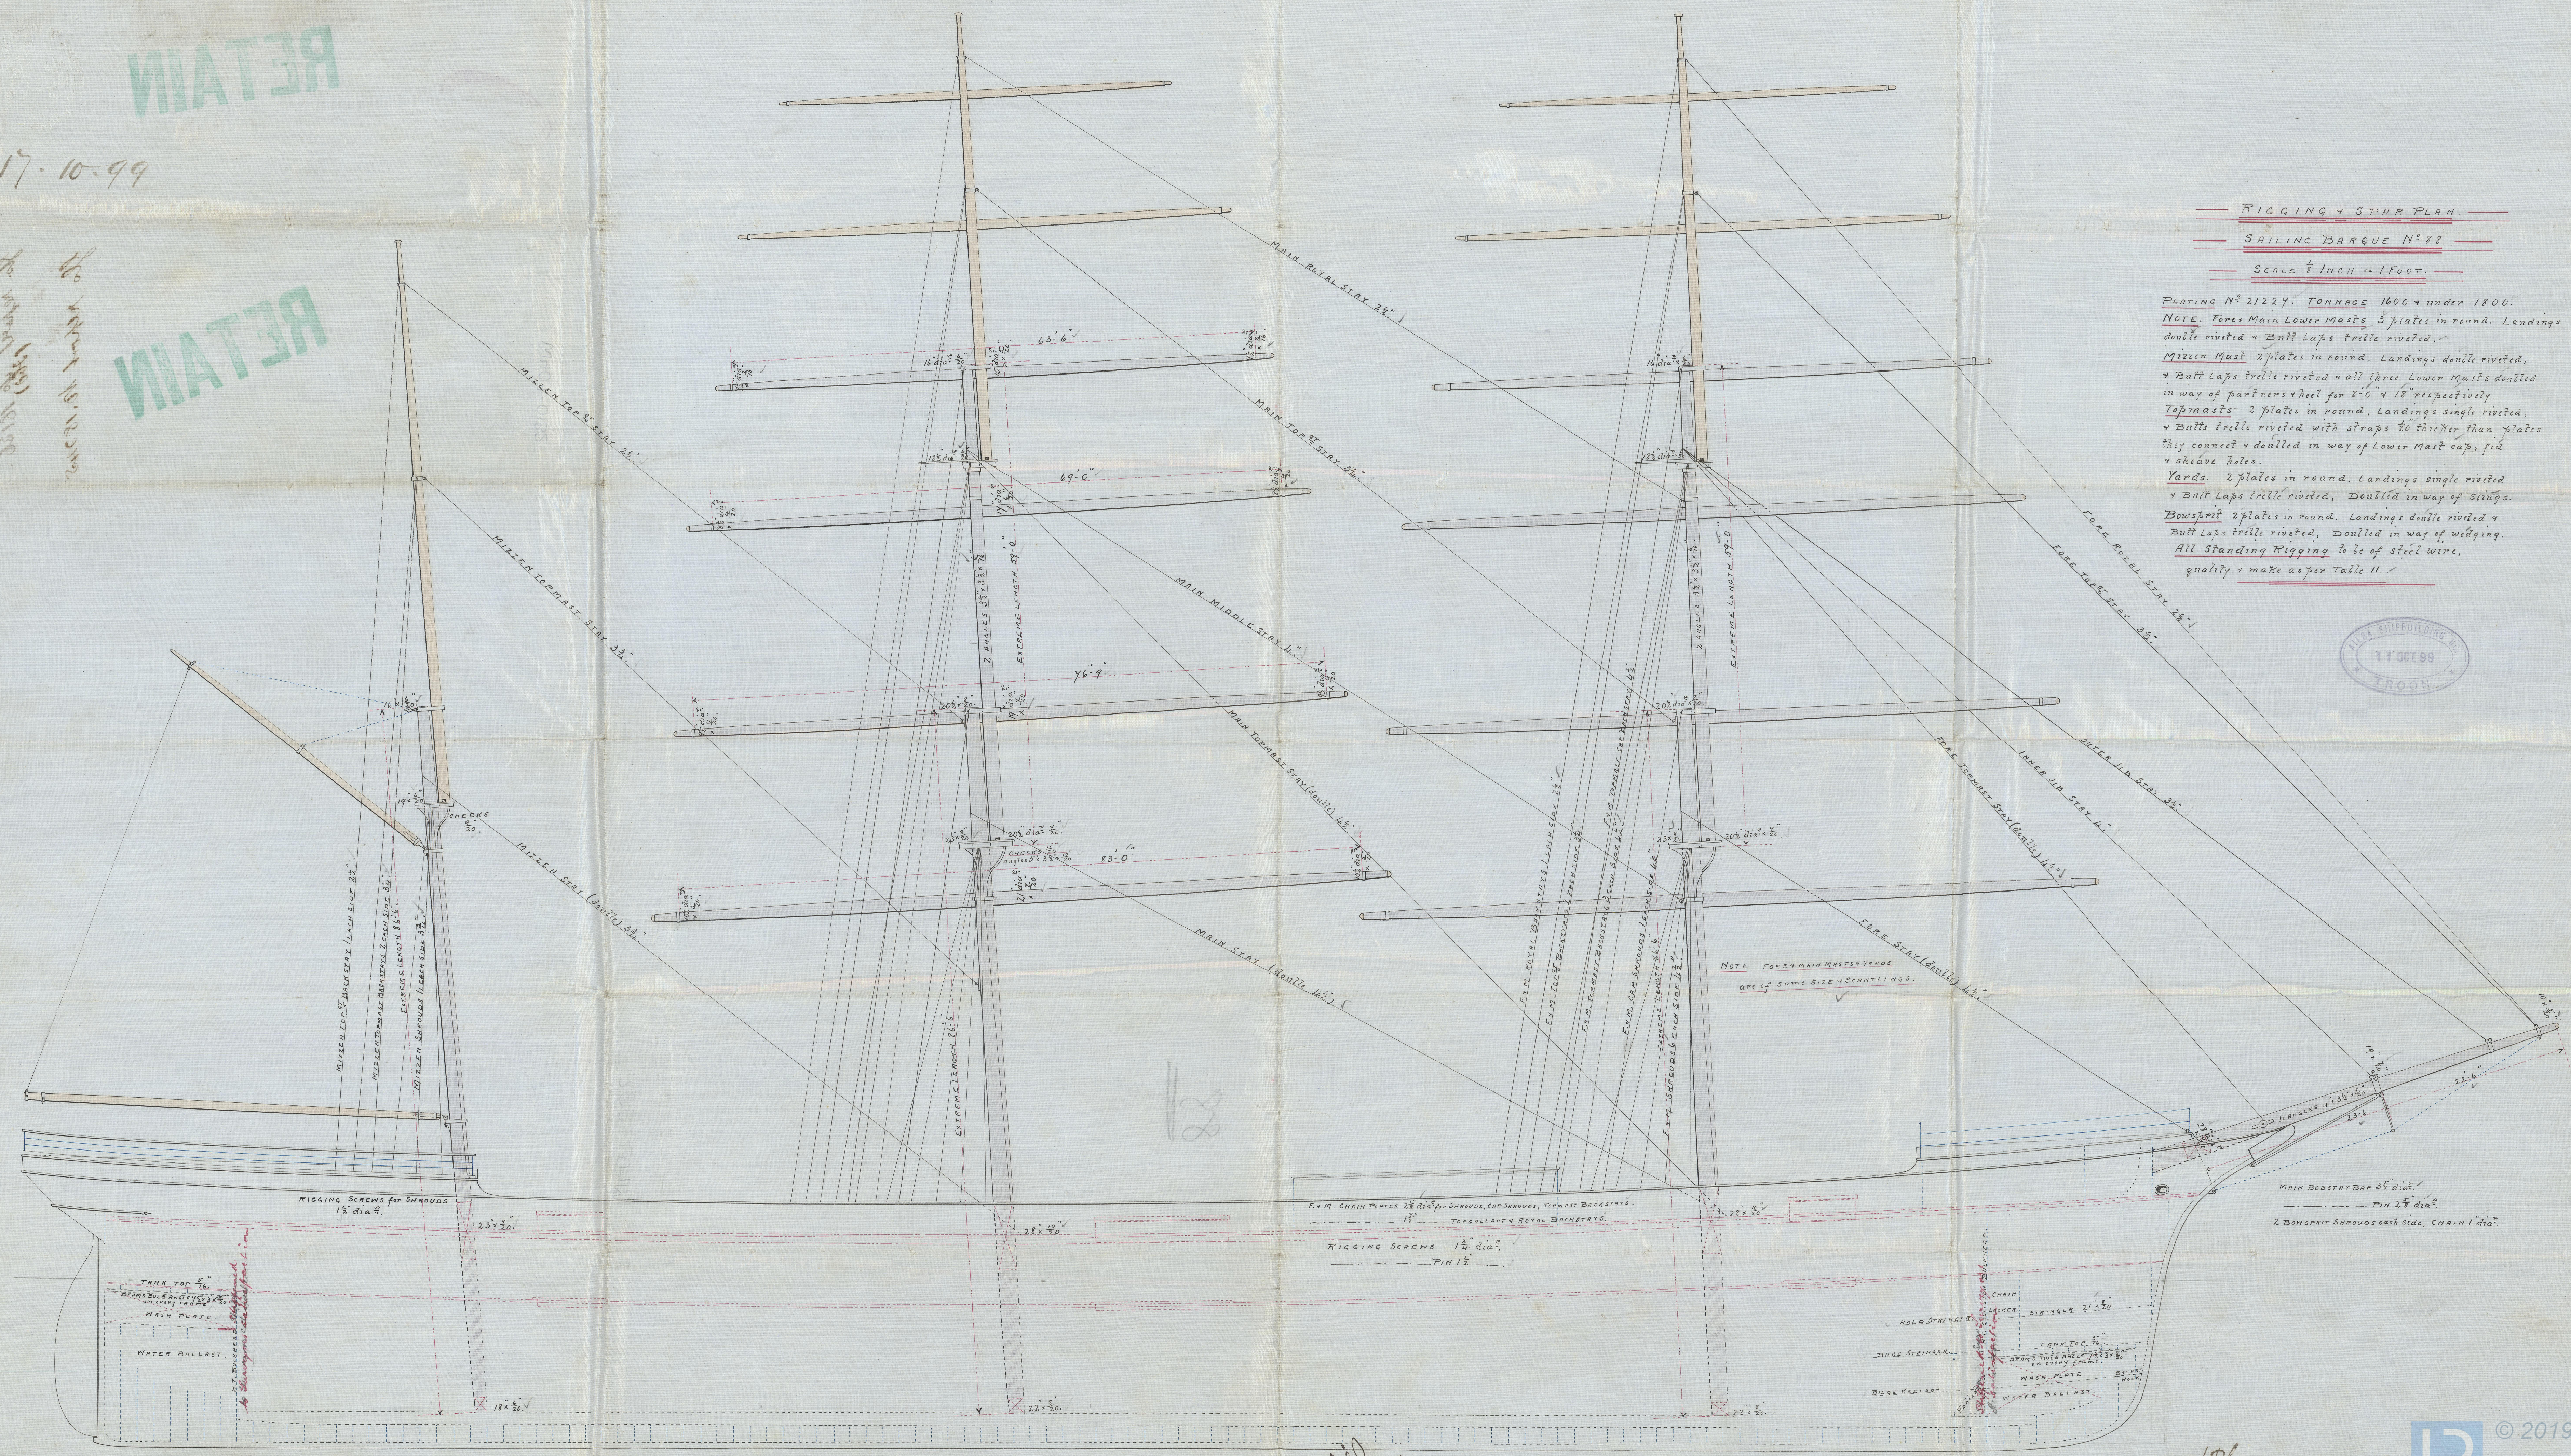

RIGGING & SPAR PLAN.  
SAILING BARQUE N° 22.  
SCALE 1/4 INCH = 1 FOOT.

PLATING N° 21224. TONNAGE 1600 under 1800.  
NOTE. Fore & Main Lower Masts 3 plates in round. Landings  
double riveted & Butt Laps treble riveted.  
Mizzen Mast 2 plates in round. Landings double riveted,  
& Butt Laps treble riveted & all three Lower Masts doubled  
in way of partners & heel for 8'0" & 18' respectively.  
Topmasts 2 plates in round. Landings single riveted,  
& Butts treble riveted with straps 30 thicker than plates  
they connect & doubled in way of Lower Mast caps, fid  
& sheave holes.  
Yards. 2 plates in round. Landings single riveted  
& Butt Laps treble riveted. Doubled in way of stings.  
Bowsprit 2 plates in round. Landings double riveted &  
Butt Laps treble riveted. Doubled in way of wedging.  
All Standing Rigging to be of steel wire,  
quality & make as per Table II.



NOTE FORE MAIN MASTS & YARDS  
are of same size & SCANTLINGS.

F.M. CHAIN PLATES 2 1/2 dia. for SHROUDS, CAP SHROUDS, TOPMAST BACKSTAYS.  
1 1/2 TOPGALLANT & ROYAL BACKSTAYS.  
RIGGING SCREWS 1 1/2 dia.  
PIN 1 1/2

MAIN BOOMSTAY BAR 3 1/2 dia.  
PIN 2 1/2 dia.  
2 BOWSPRIT SHROUDS each side, CHAIN 1 dia.

TANK TOP 5' 6"  
DECK BARS 3' 6" x 3' 6"  
WASH PLATE  
WATER BALLAST

HOLD STRAINERS  
RIGID STRIPS  
BUSH KEEL  
TANK TOP 5' 6"  
DECK BARS 3' 6" x 3' 6"  
WASH PLATE  
WATER BALLAST  
BEAST HOLE

12  
13/10/99


17/10/99



88

0.5 x 8.5

EXTRAWE LENGTH 8.5

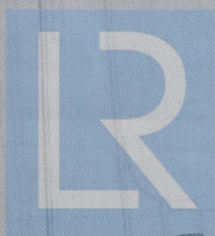

© 2019

Lloyd's Register  
Foundation

W407-032



RETAIN


22.6.21

Kellareau

Sh. report (No. 18136)

Sh. report No. 18245

RETAIN

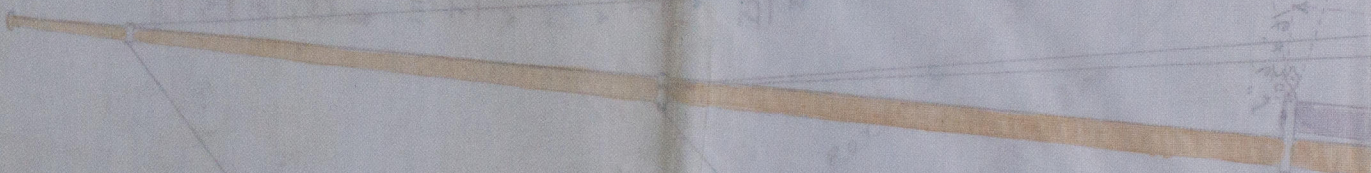

W407-0132



© 2019  
Lloyd's Register  
Foundation