


vertical joint  $\frac{13}{16}$  rivets  $2\frac{3}{4}$  pitch

Boiler No 195  
200 lb  
11 p well.  
16-3-14

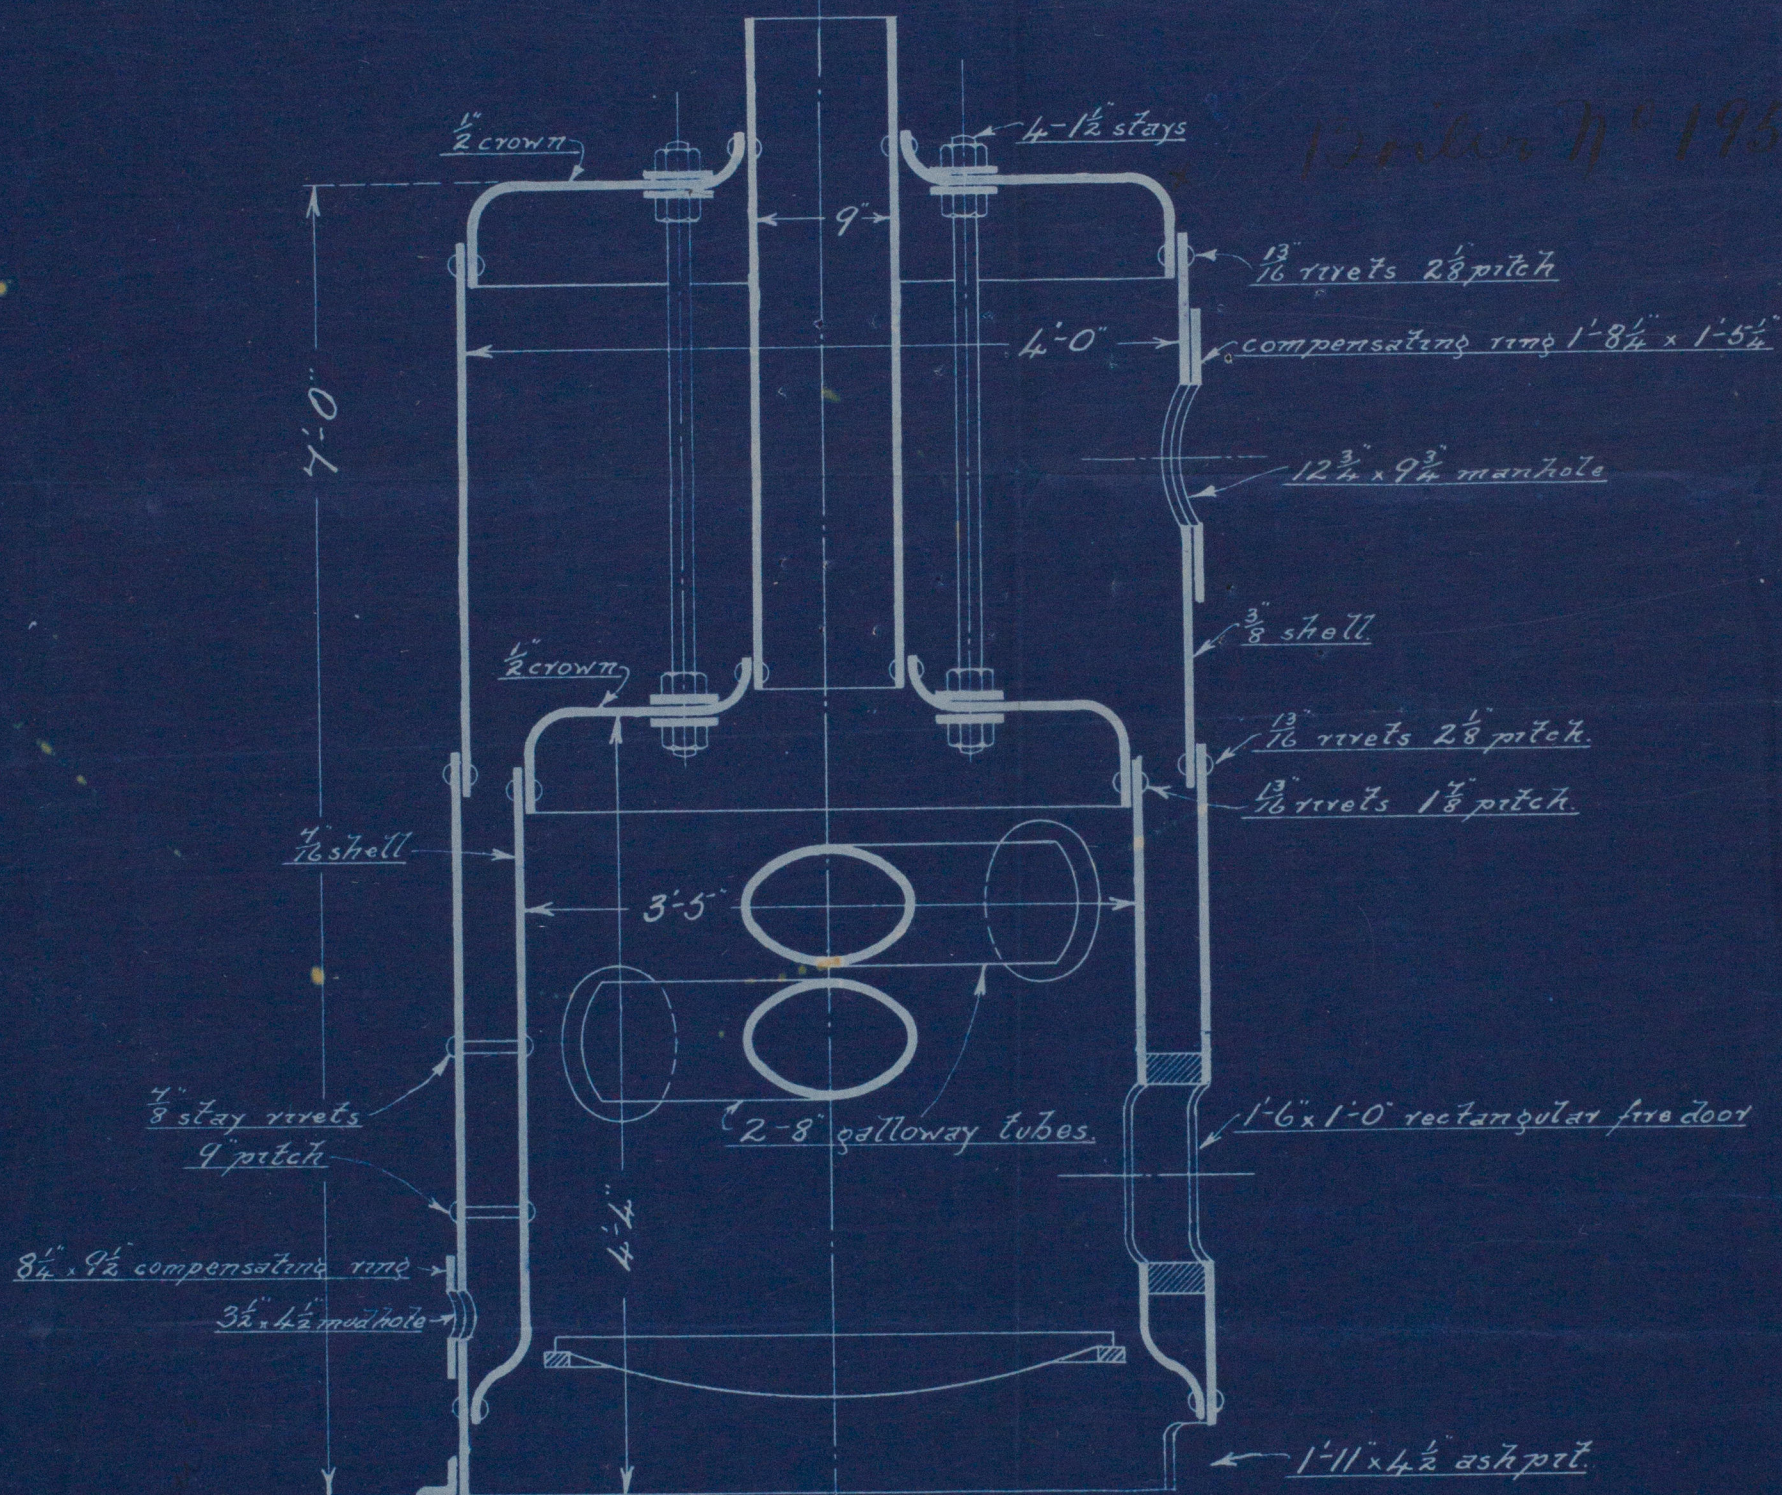

100 LB. Steam Pressure.

Boiler No 195  
200 lb  
10 p well.

VERTICAL HIGH PRESSURE BOILER

for

Drawing No 2176 Scale 1"=1'-0" J.A.H.

16-3-14.

J. & JOSEPHSON  
ENGINEERS  
AND  
BOILER MAKERS  
1113 Broadway  
New York City

LR

© 2019

Lloyd's Register  
Foundation



1108 1108 1108  

Bk. Killoran  
R.S.W. 961

RETAIN


W407-0134



"Killoran"  
Rept-N.S.W. 961.

Boiler Plan.



RETAIN

