


- S.S. N° 291 - - BEAM ARRANGEMENT -

SCALE 1/8" = 1' 0"
ROBERT THOMPSON & SONS LTD.
IRON AND STEEL SHIPBUILDERS
AND REPAIRERS
SOUTHWICK YARD
SOUTHWICK
FEBRUARY 5TH 1915.

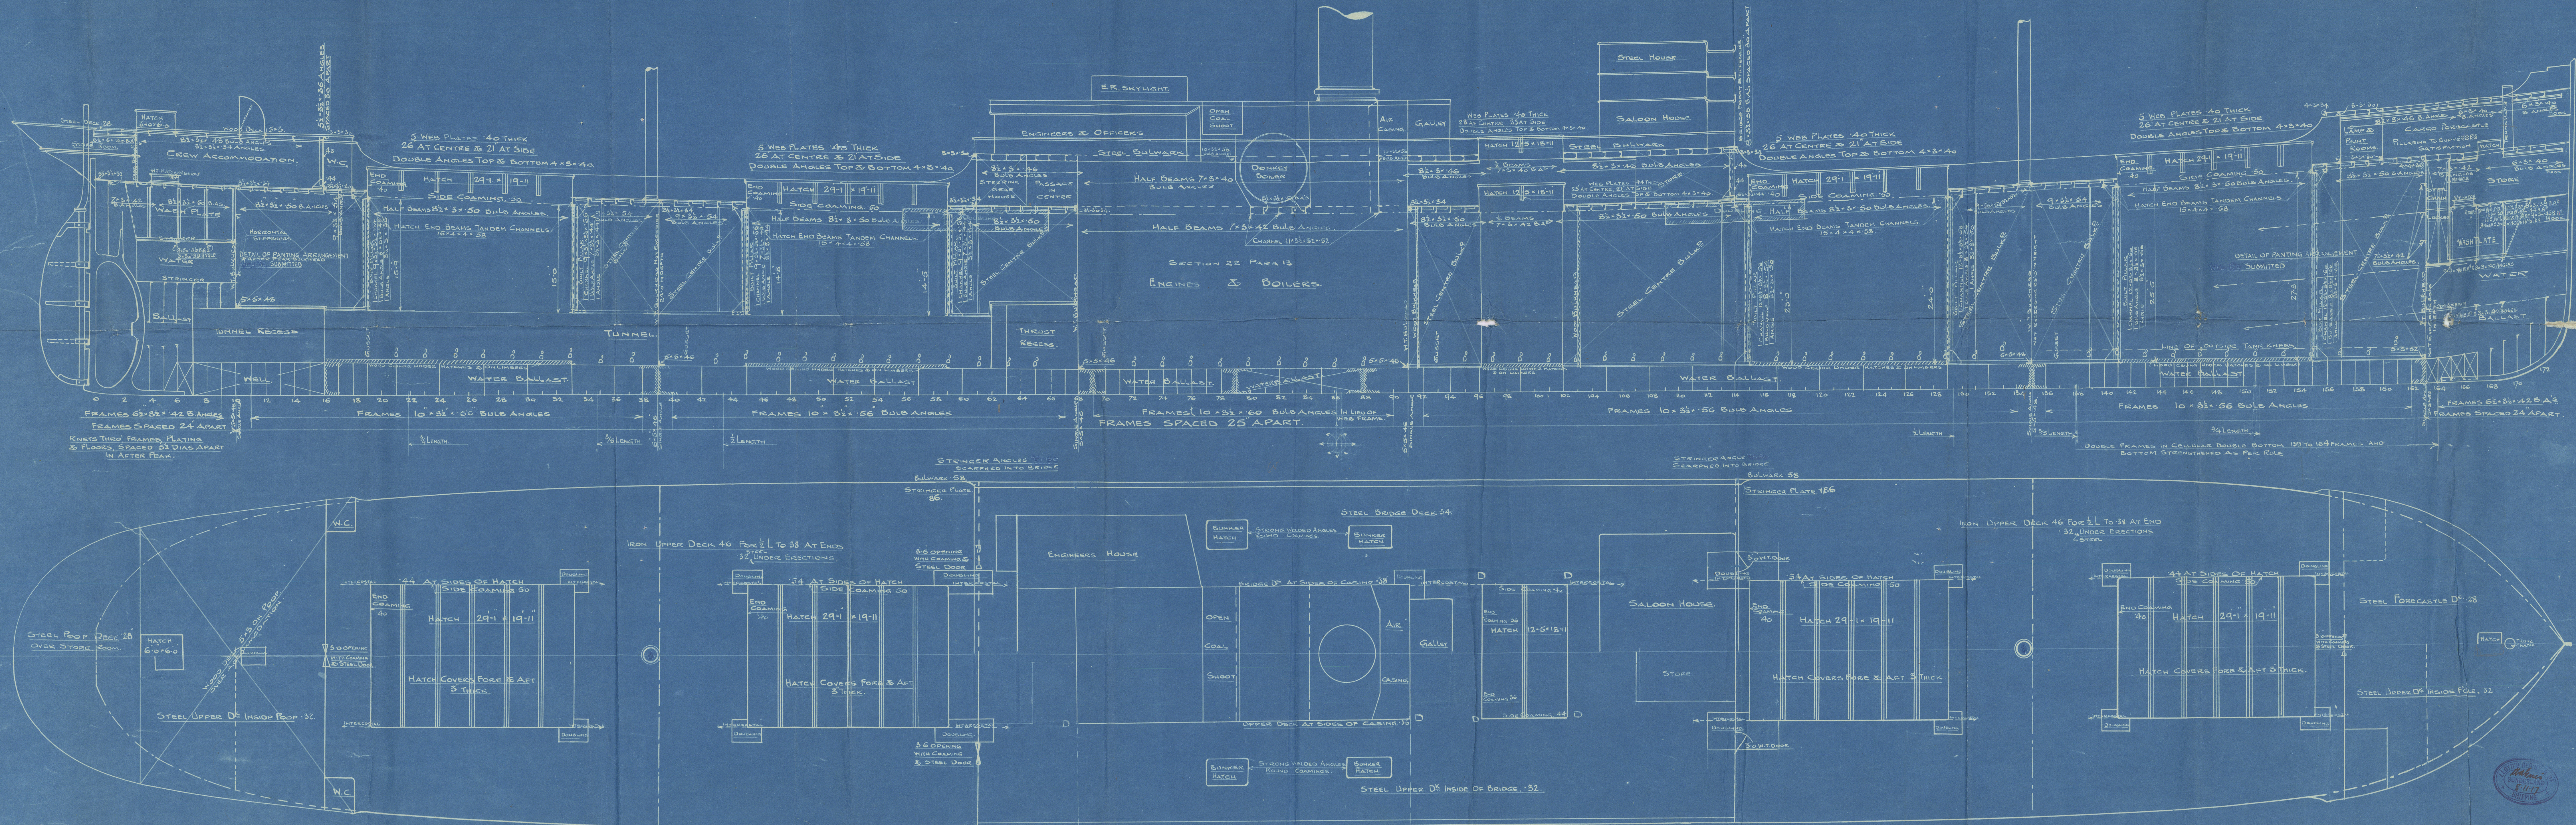

S.S. CAPEL CASTLE

R. THOMPSONS N^o 291.

PROFILE AND DECK PLAN

AS FITTED

SLO RPT NO.

27088

NOW

VINRIVER

RETAIN

W409-R153 Lloyd's Register Foundation