

Amended Plan of  
Main Buildings  
Alex. Stephen House No. 534

W.P. 21046.

H.S. 3107. £

s/s "Gazcon".


GLASGOW REPORT No. 52703

W41-0036




© 2019

Lloyd's Register  
Foundation


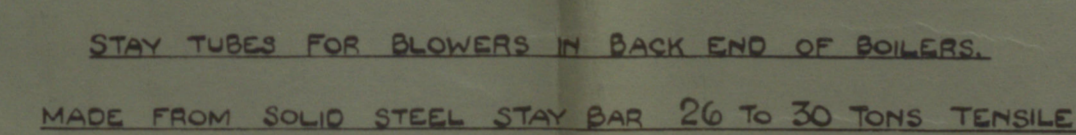


COMB. CHAM. ST. SCR:  
SCR: THRO' SHE & B'STRAP:  
MARKED ⊗

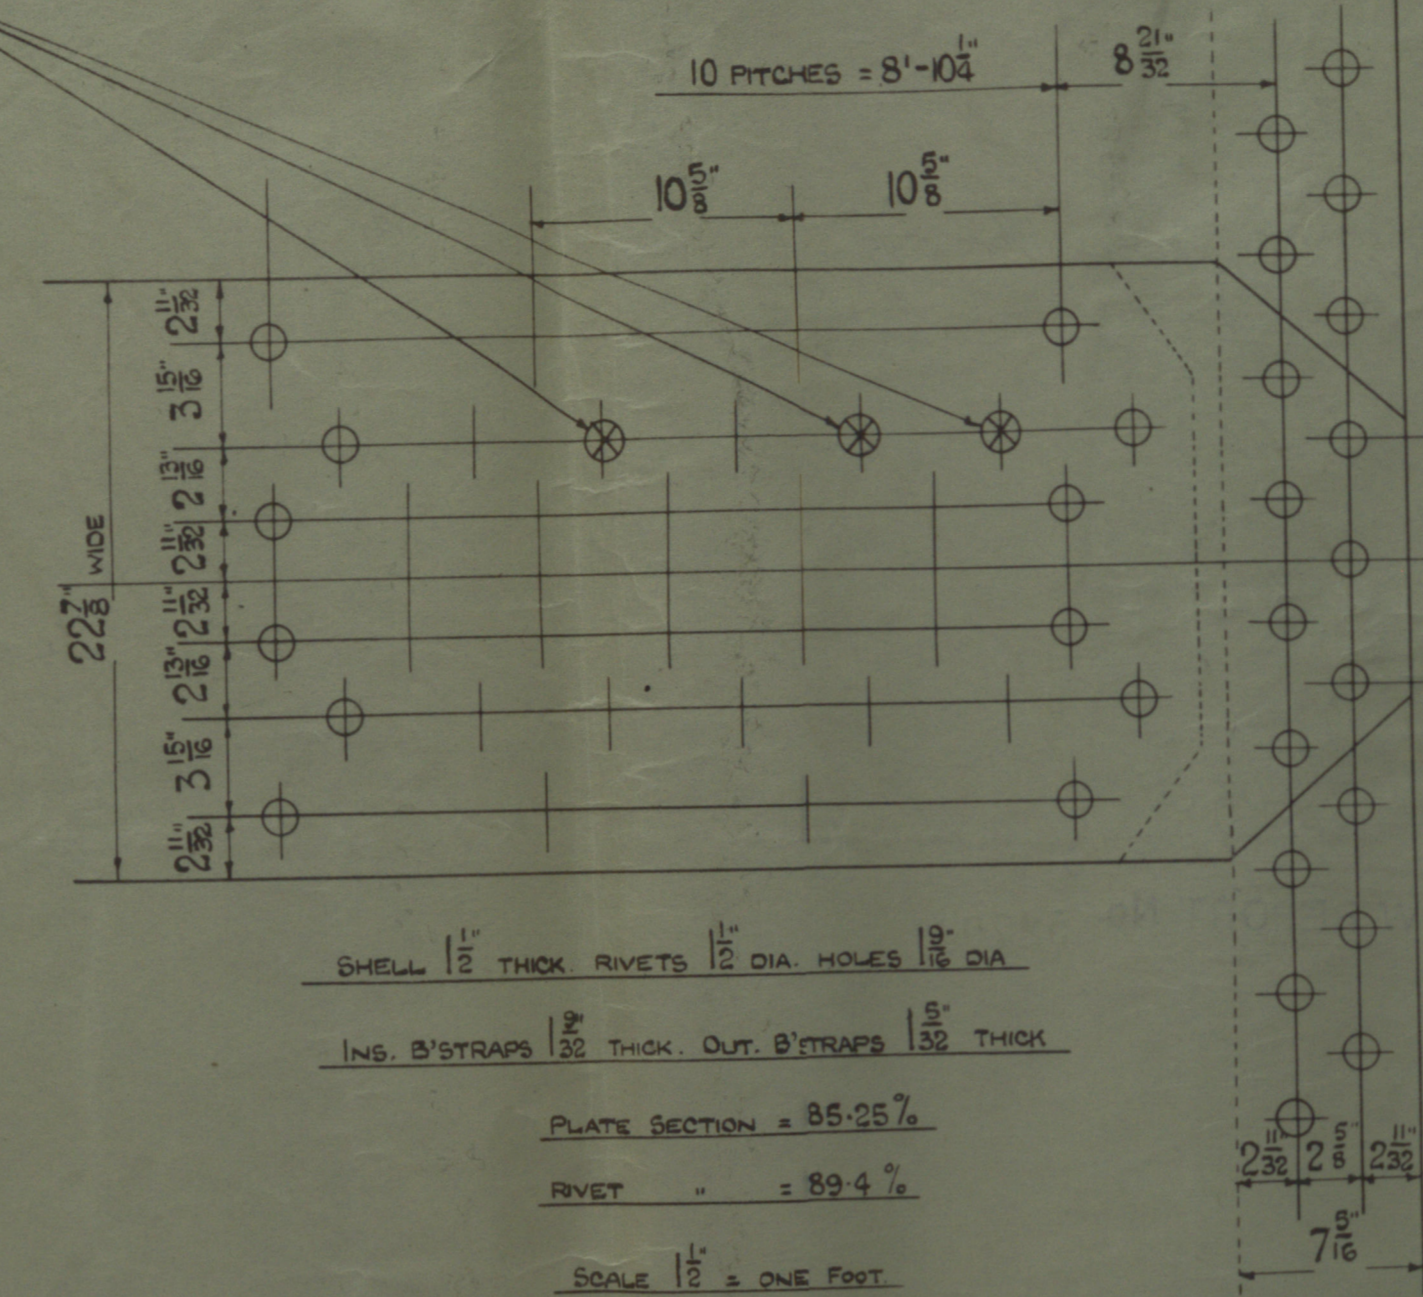

CIRCUM. SEAMS RIVETS  $\frac{1}{2}$ " DIA. HOLES  $\frac{3}{16}$ " DIA. DIST. SECTION 42.7%

HEATING SURFACE	82 FT.
TUBES	258
FURNACES	192.5
COND. CHAMBS	358.2
TOTAL IN ONE BOILER	3106.2
" " TWO BOILERS	6214
Q.A. WITH 5'-6" BARS ONE BOILER	688
" " " TWO BOILERS	132
RATIO OF Q.A. TO H.S.	1.47

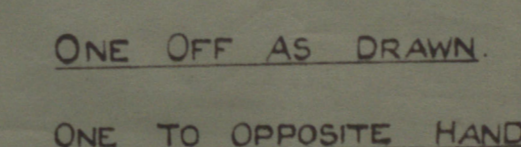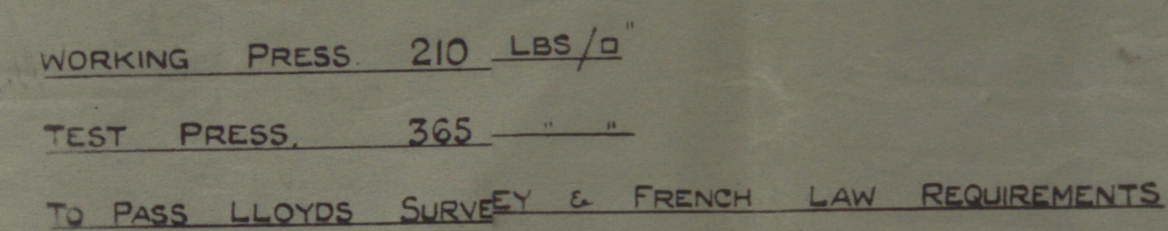[illegible]

Nº 537  
MAIN BOILER  
SCALE 1" = ONE FOOT

DRG. No. _____	
COSTS	
WORKING	SPARE
R. 21.	R. 19