



12/3/32

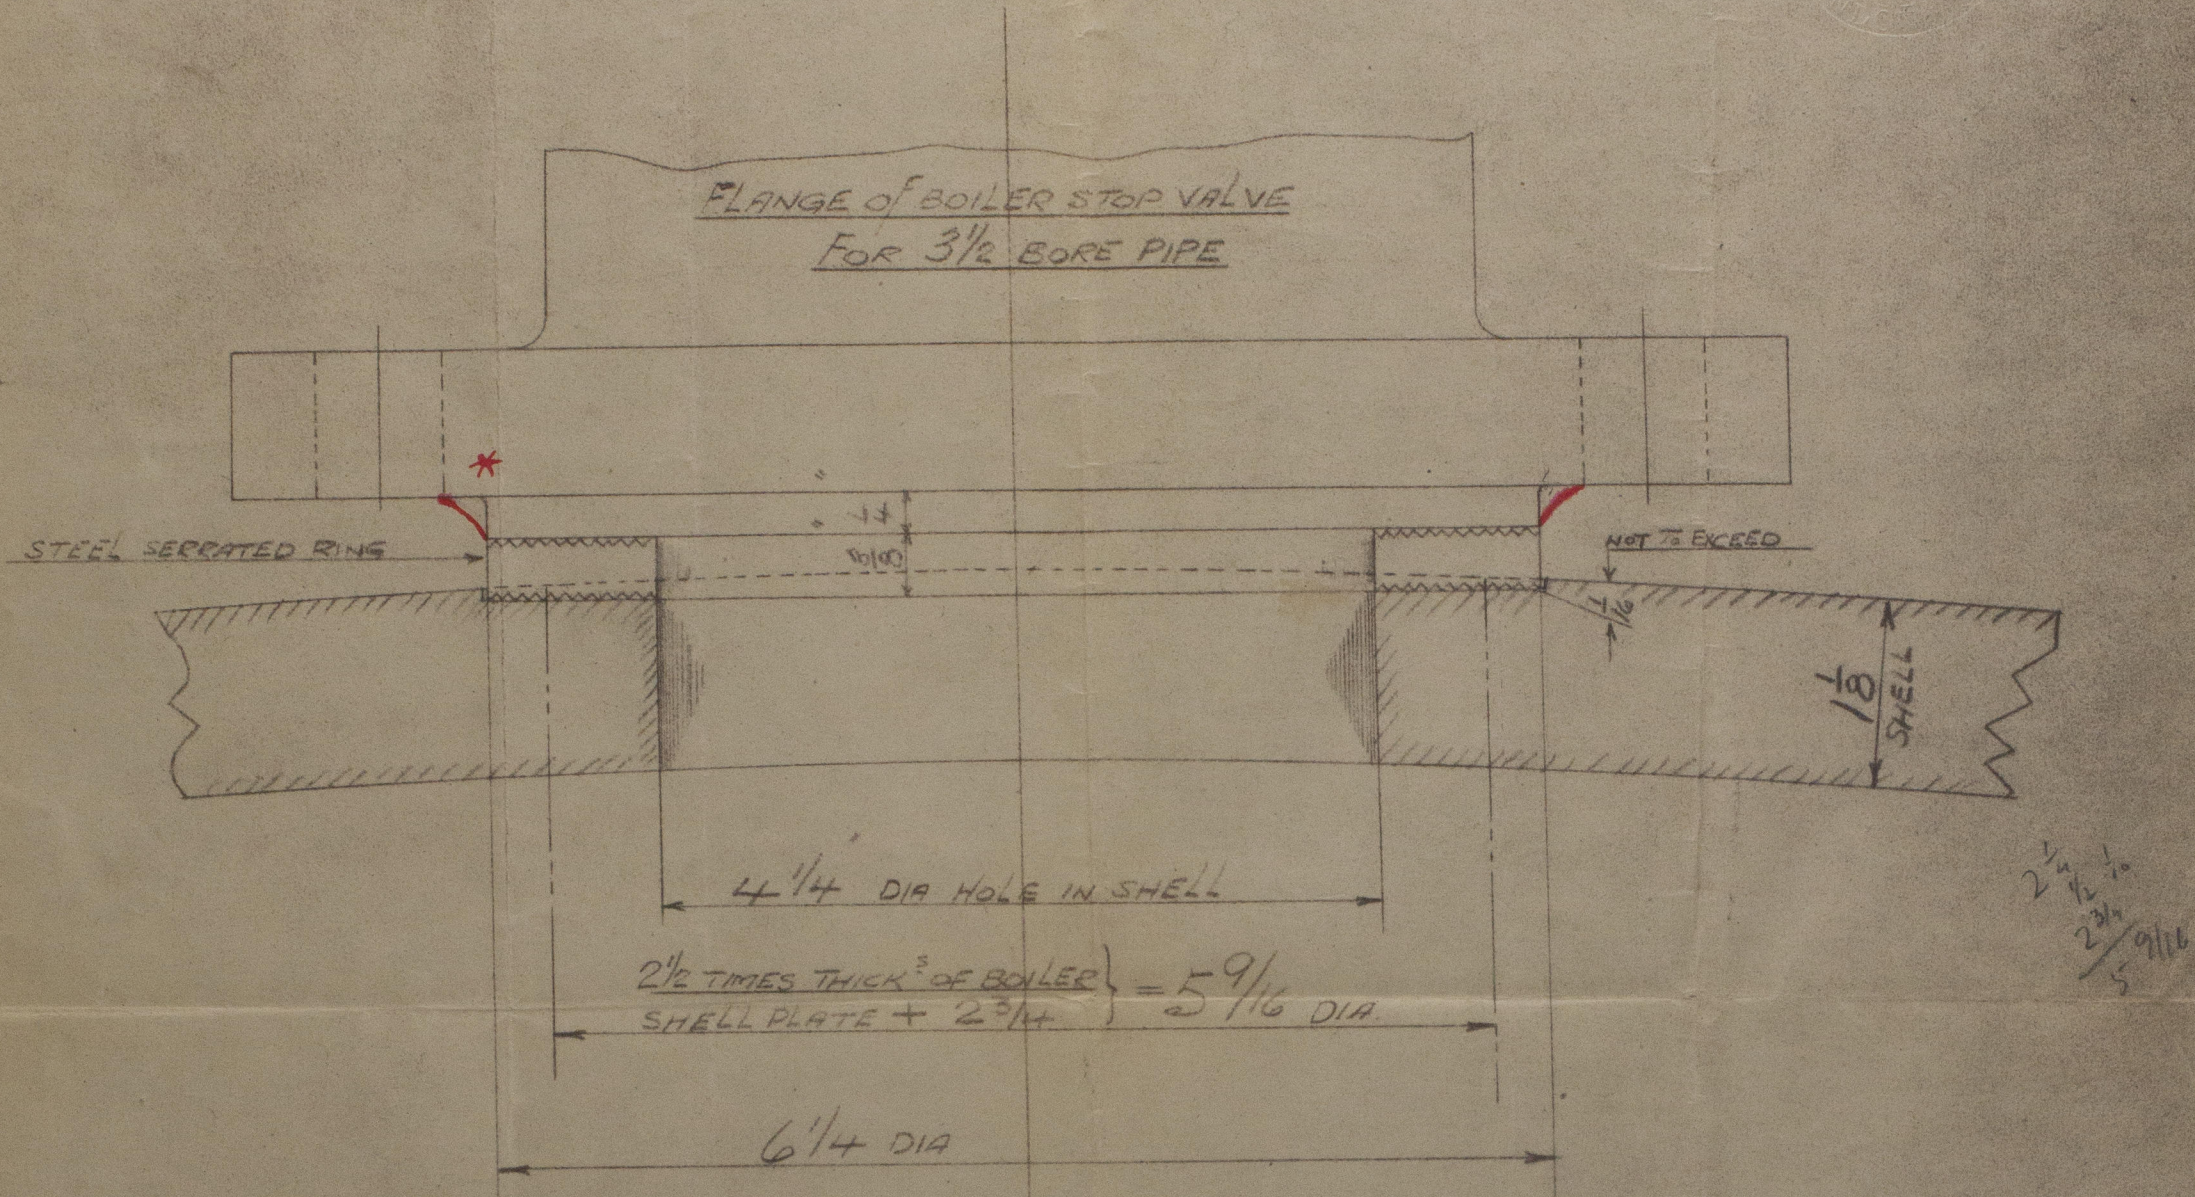

\* Radius to be as large as practicable.  
Valve chests to be made of steel.

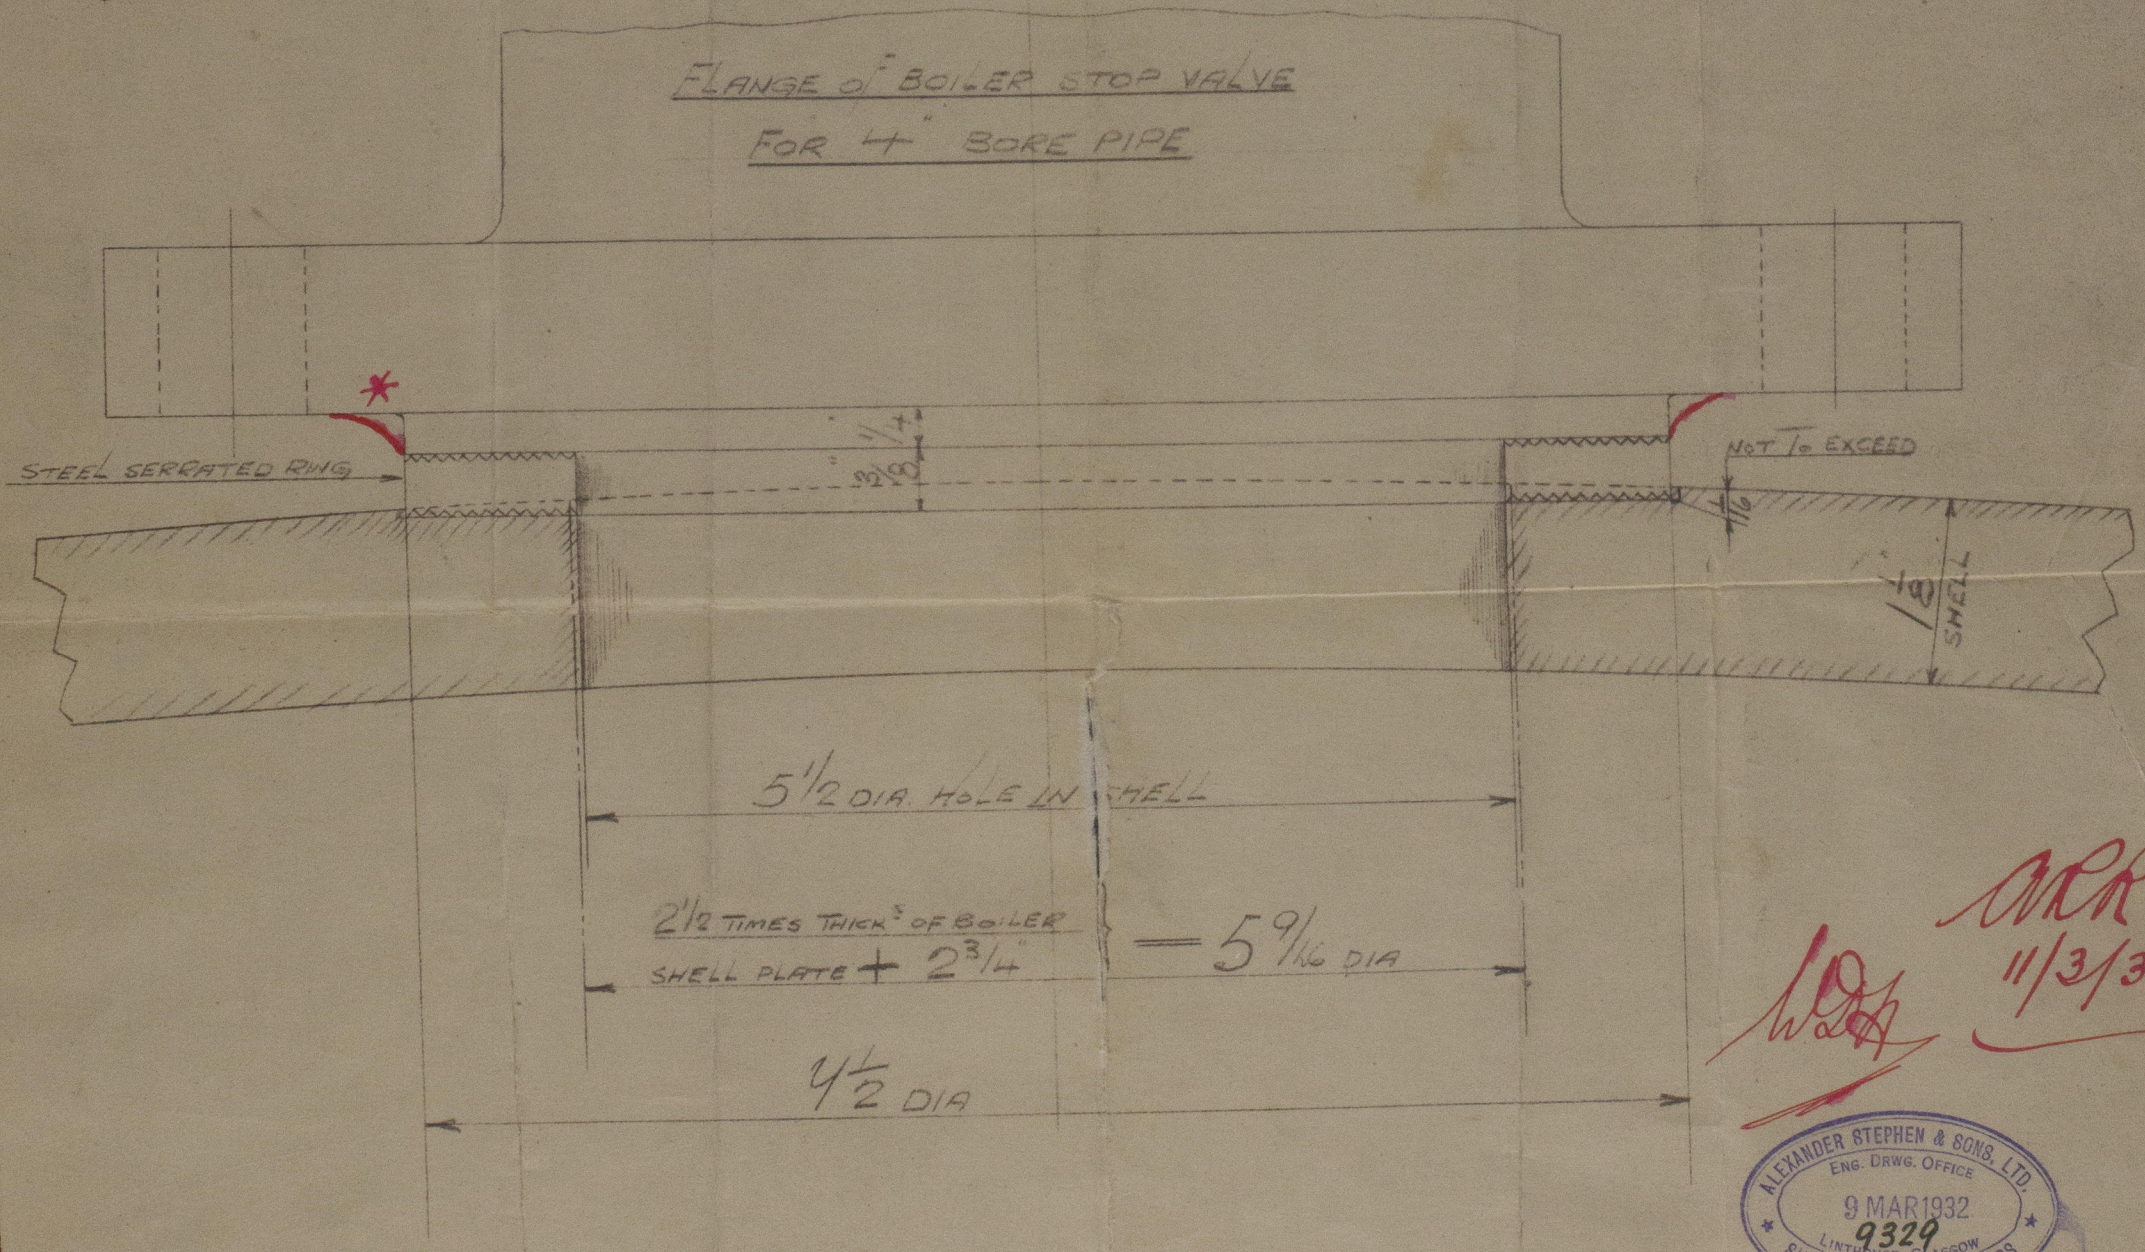

WRR  
 11/3/32

ALEXANDER STEPHEN & SONS, LTD.  
 ENG. DRWG. OFFICE  
 9 MAR 1932  
 9329  
 LINTHOUSE, GLASGOW  
 SHIPBUILDERS & ENGINEERS

SS N° 534

METHOD OF MACHINING BOILER SHELL TO RECEIVE MOUNTINGS

SCALE: FULL SIZE

9/3/32

W41-0042

LR

ALEXANDER STEPHEN & SONS, LTD.  
 ENG. DRWG. OFFICE  
 17 MAR 1932  
 LINTHOUSE, GLASGOW  
 SHIPBUILDERS & ENGINEERS

noted



Plan of Attachment  
of Steam Pipe valves  
to Boiler Shell

A Sketch of the

"Gazcon"

GLASGOW REPORT No. 52703

W41-0042



© 2019

Lloyd's Register  
Foundation