

9/12/27


DIMENSIONS: LENGTH B.P. 304'-11 1/2", BREADTH MLD. 50'-0",
DEPTH MLD. 15'-0", DRAUGHT 18'4"

YARD No 197

DISEGNO No 154


PROFILE & DECK PLANS

SCALE 1/8" = 1 Foot

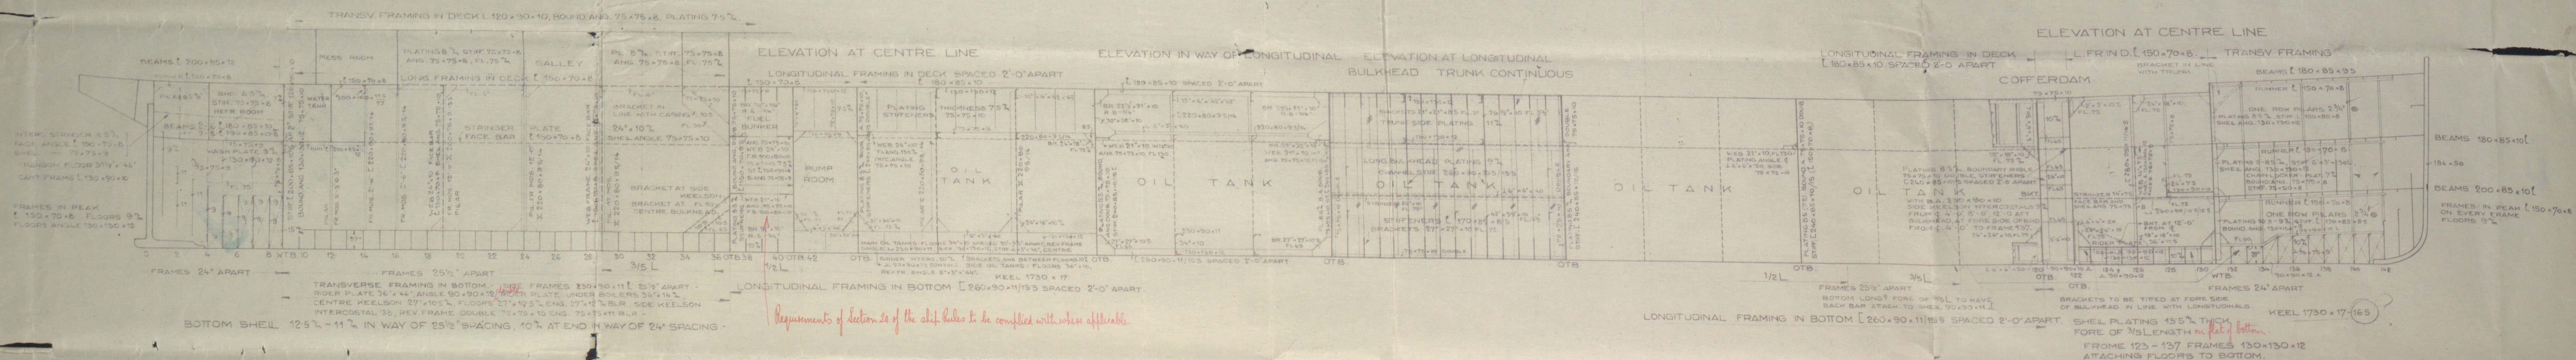

TRUNK DECK

UPPER DECK

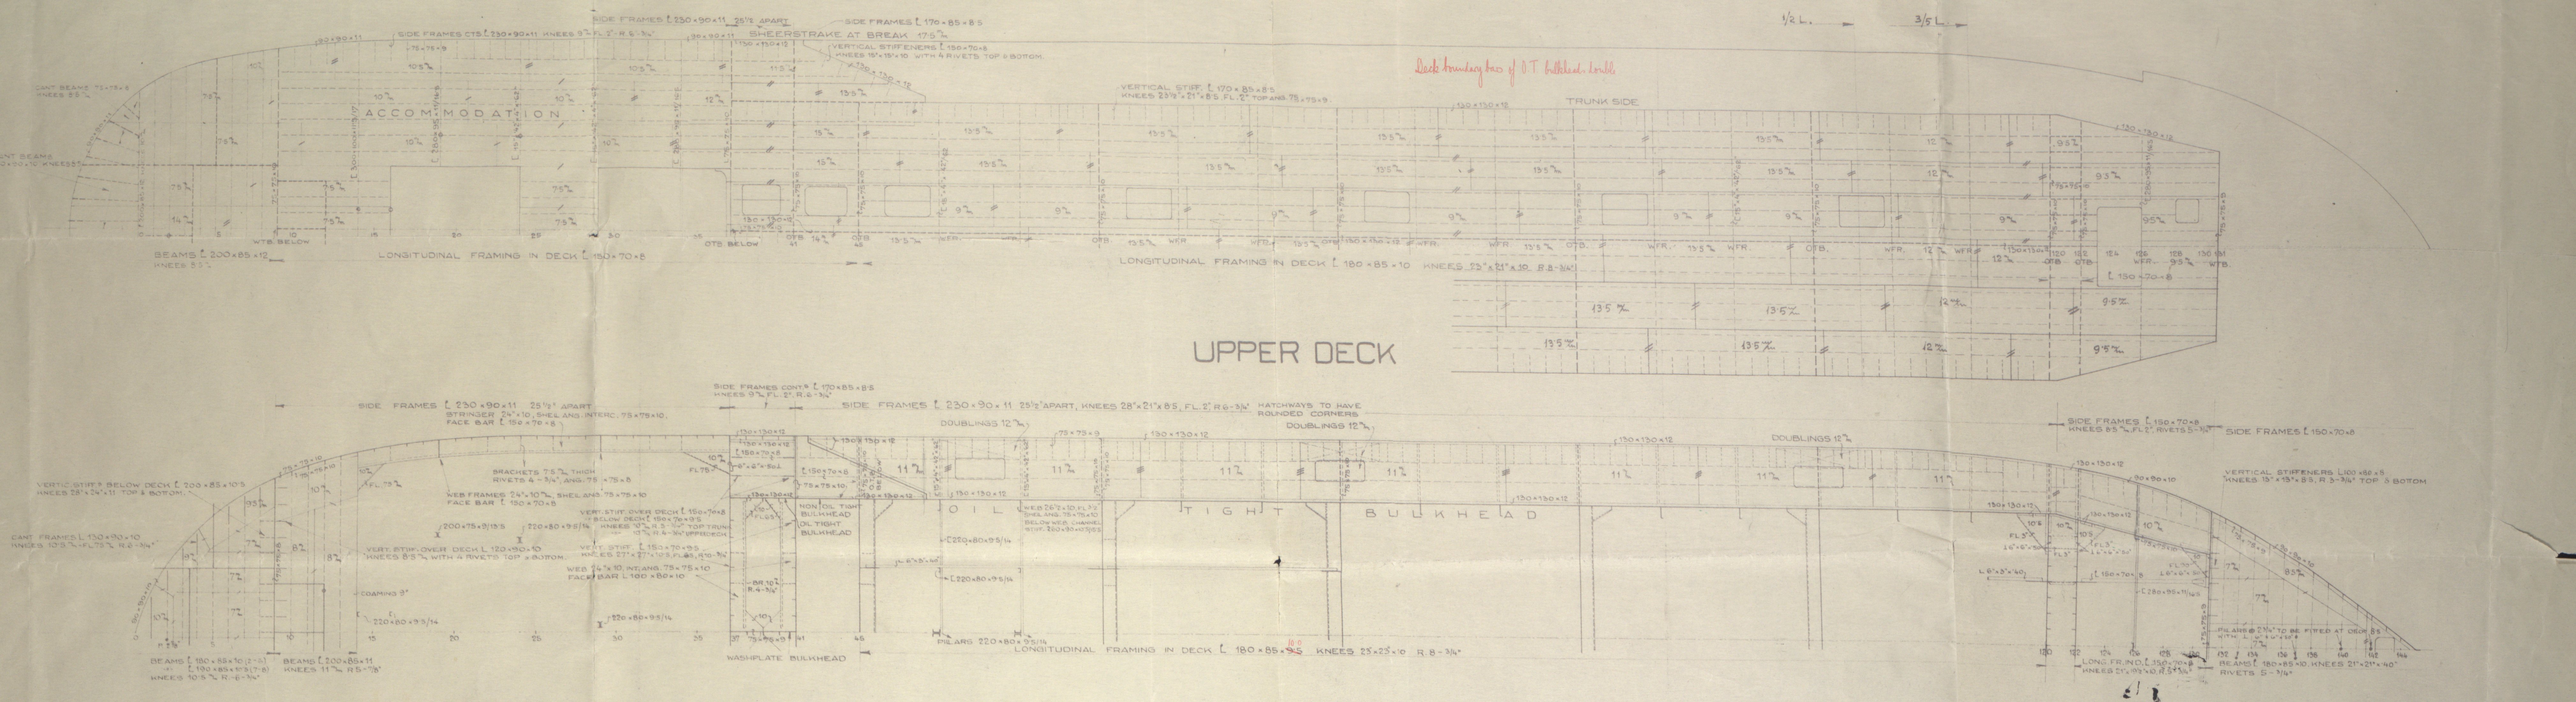

BOAT DECK

STRINGER

FORECASTLE DECK

9.12.27

858

Aug. Cassan

197

21

Long. e. Deck plow
Appr. R. R.

RETAIN

H. Leticia CNT 197

Triste Ppt. 7844

L. Lucrecia
CNT 203

Triste Rat 8045

RETAIN



© 2019

Lloyd's Register
Foundation