


Nov. 1931.

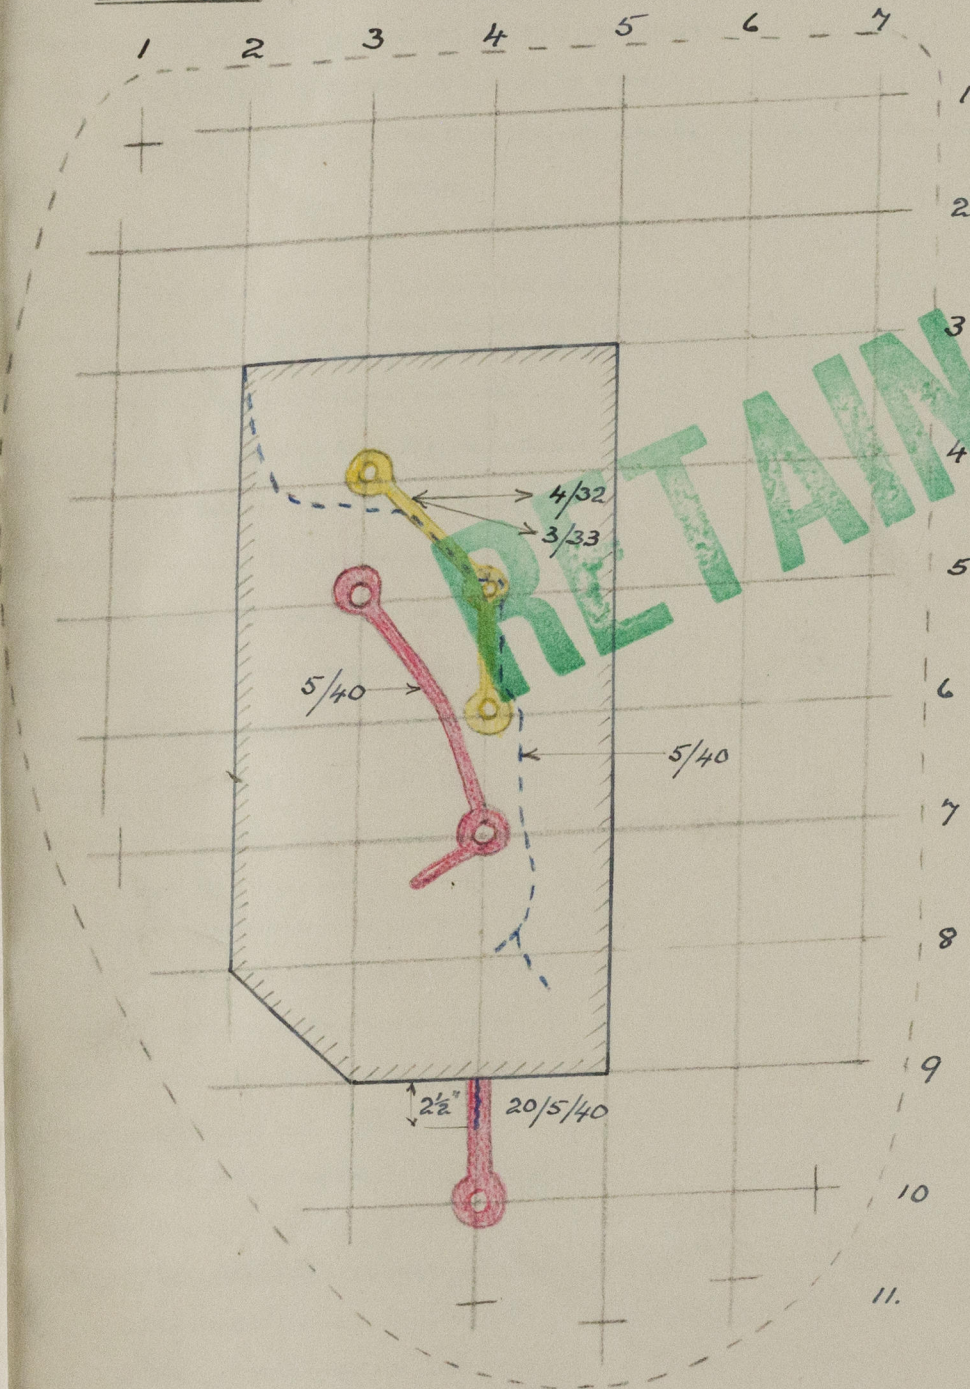

W.P. 180 lbs \square "

THICKNESS OF

PLATE

= $\frac{19}{32}$ "

- 4/32 and 3/33
- - - 5/40
- 5/40

S.S. "LEO."
PORT BOILER
PORT C.C.



© 2019

Lloyd's Register
Foundation

W410-0134