

— OF A —
SINGLE DECKED SCREW STEAMER.

LENGTH --- 390-0
BREADTH MLD --- 53-0
DEPTH MLD --- 26-0

- SCALE $\frac{1}{2}'' = \text{ONE FOOT.}$

-----do----- 11.47. Bridge Deck


— Hawser & Warps. —

120 fathoms Towline	14 or $4\frac{3}{4}$ Steel Wire
2-90 - " - Hawser	8"
2-90 - " - Warp	7

Poop Side plating. .38
- " Stringer plate 3/4 x .34
- " " " angle 3 1/2 x 3 1/2 x .34
- " Deck plating .26 Steel

1/4" Side plating .40
 -" Stringer plate 3/4 x 3/4
 -" -" Angle 3/2 x 3/2 x 3/4
 -" Deck plating .25 Steel, Wood Sheathed 5 x 2 1/2 PP

Butts of Poop & A/Cle side plating.
overlapped & double rivetted, Seams Single rivetted.

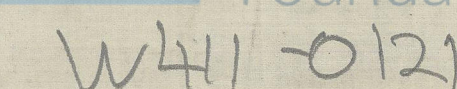


Shannonmede

S.S. LLANOVER

PICKERSGILLS No 193

MIDSHIP SECTION

SLO RPI No 26974

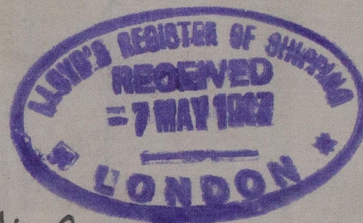

n/n "Leonidas. Z. Cambanis"

RETAIN

RETAIN

W411-0121



© 2021

Lloyd's Register
Foundation