

SCALE  $\frac{1}{2}'' = 1 \text{ FOOT}$


CLASS 100A.1 LLOYDS  
LLOYDS NUMERALS

IN WAY OF RAISED QUARTER DECK

DEPTH	MID	15' 12"
BREADTH	MID	<u>26' 00"</u>
		<u>41' 12"</u>
	b	= 9.93
	d	= 13' 10"


TRANS No

<u>EQUIPMENT</u>		Letter C
2 BOWER ANCHORS EACH	10 1/2 CWTs	STOCKLESS
1 " "	6 3/4 "	" "
1 STREAM "	3 1/2 "	EX STOCK
1 KEDGE "	1 1/2 "	" "
165 FATHOMS	1 1/2 "	STUD CHAINCABLE
60 "	2 3/4 "	STEEL STREAM WIRE
75 "	2 1/2 "	TOW LINE
1 HAWSER	90 FATHOMS	5 1/2 "

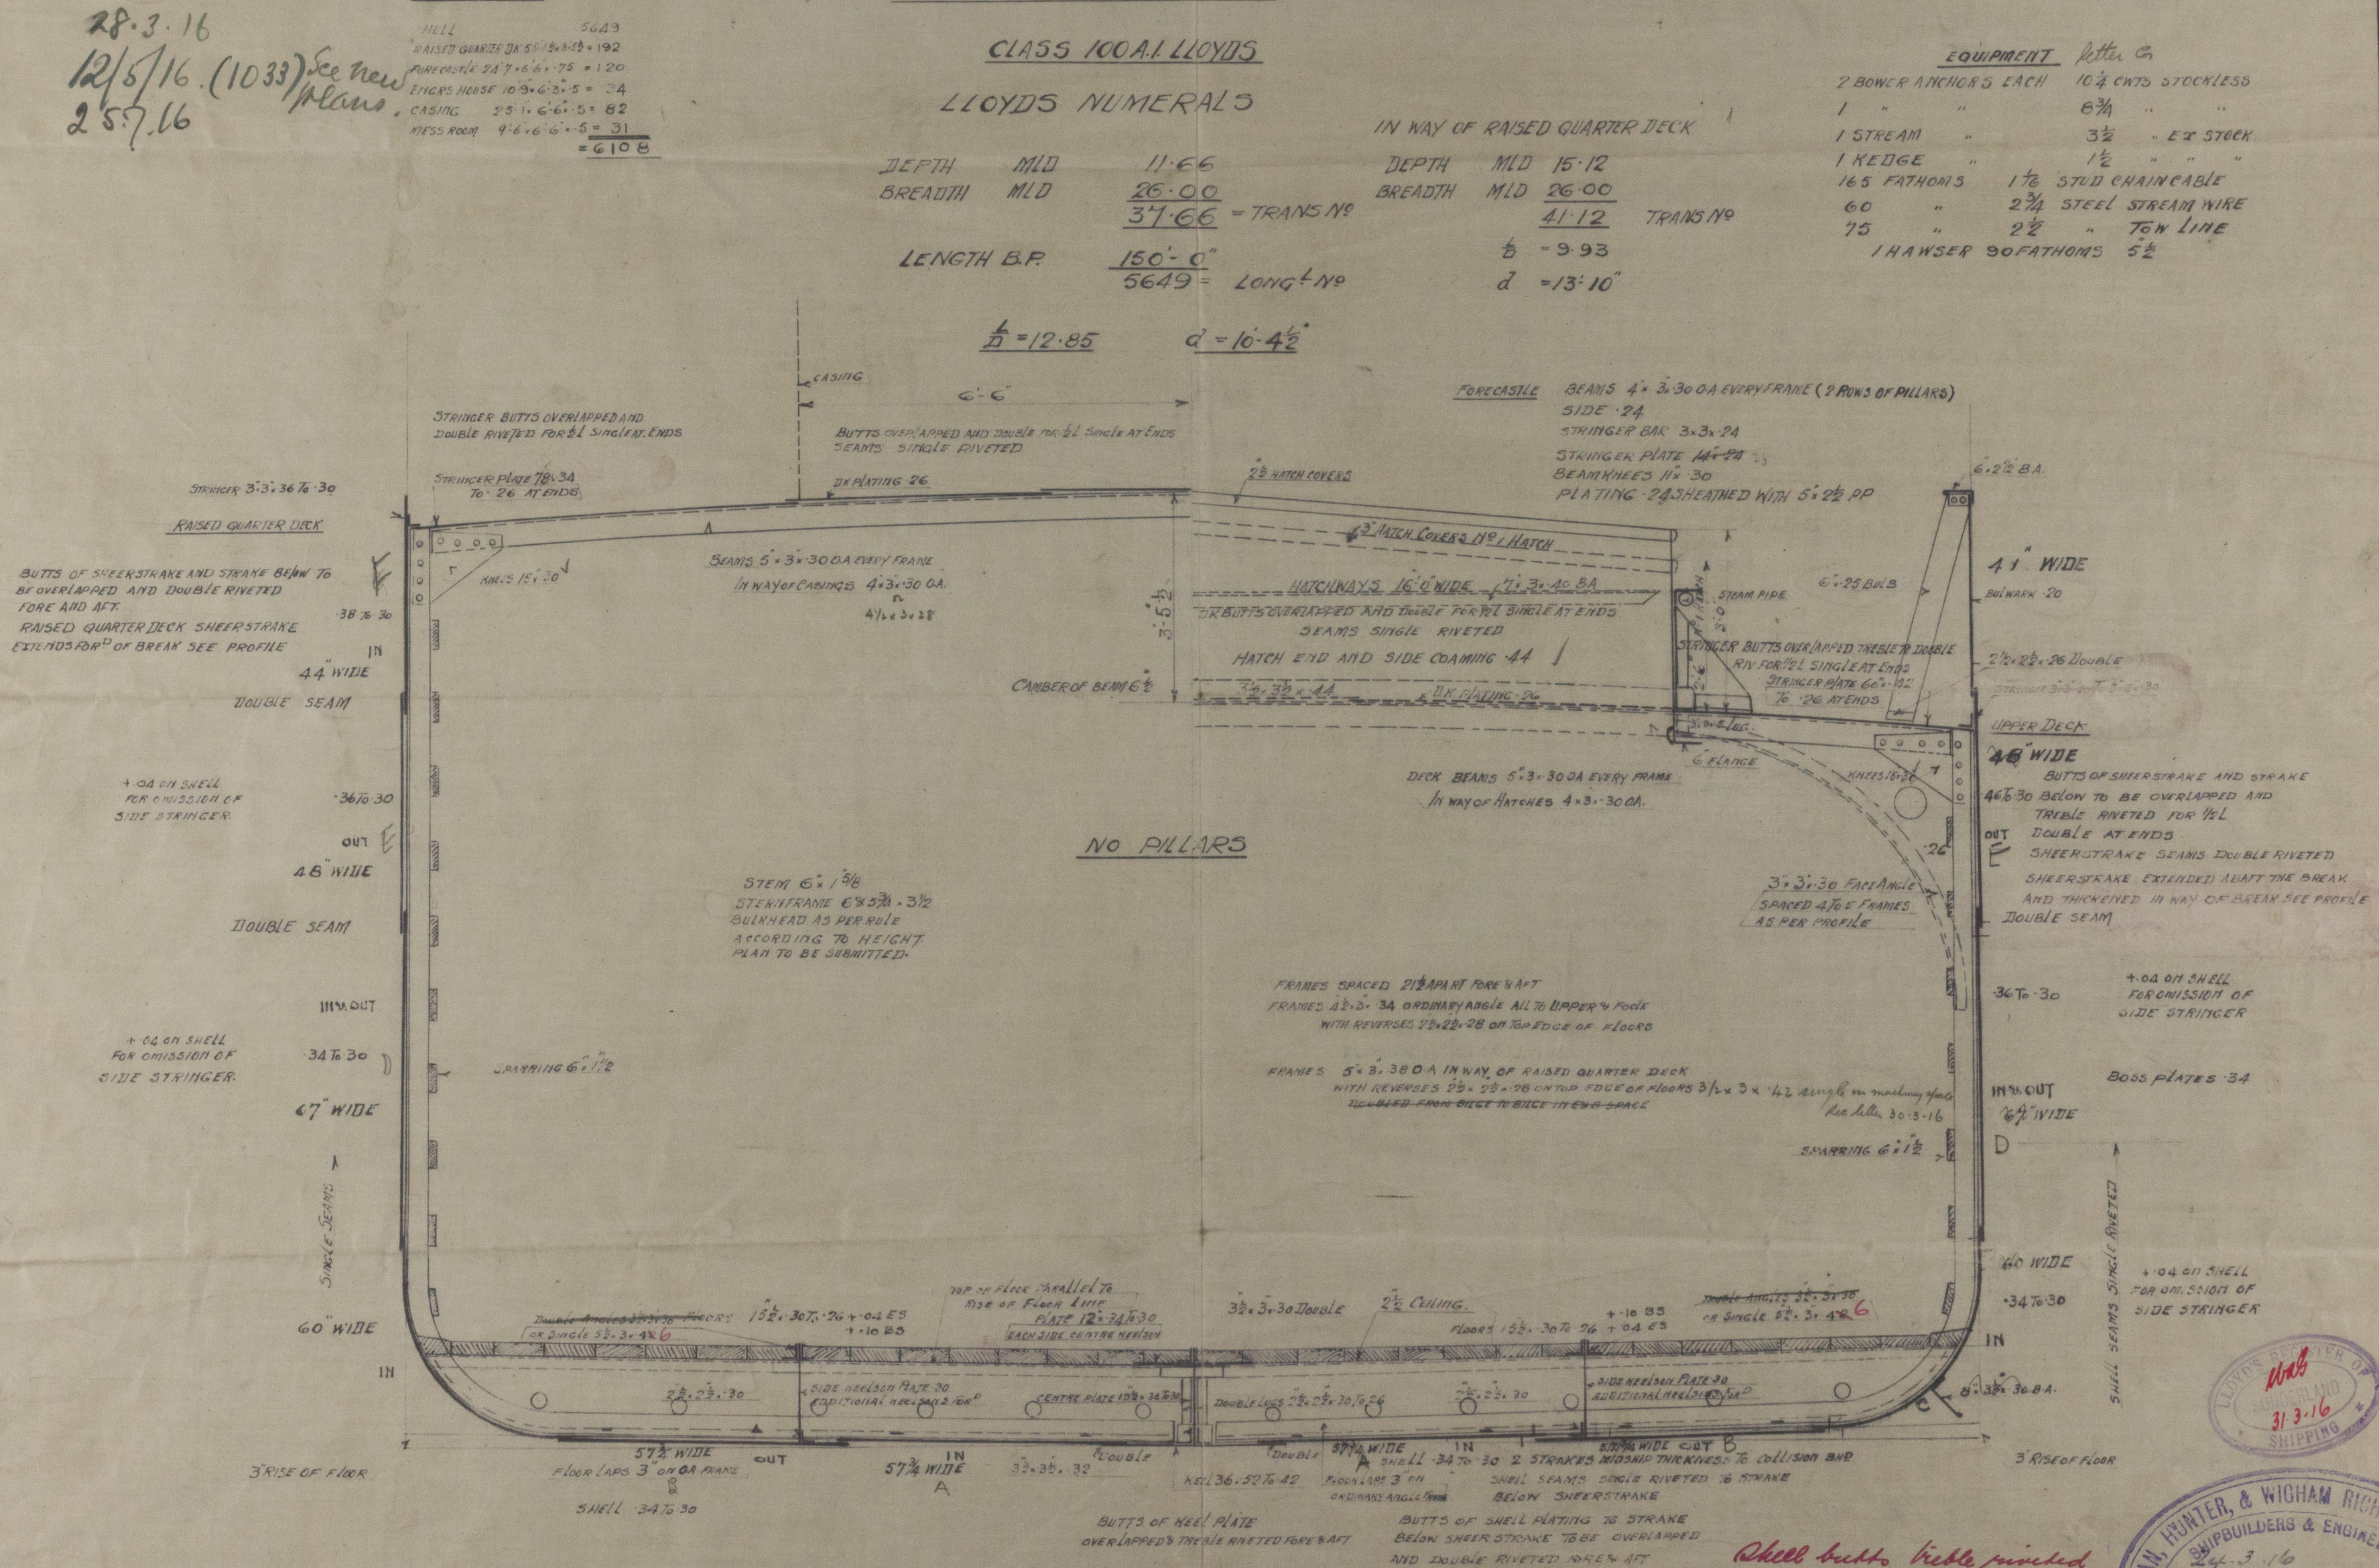

Shell butts visible pinched  
where over rule widths

Jul. 27. 3. 16

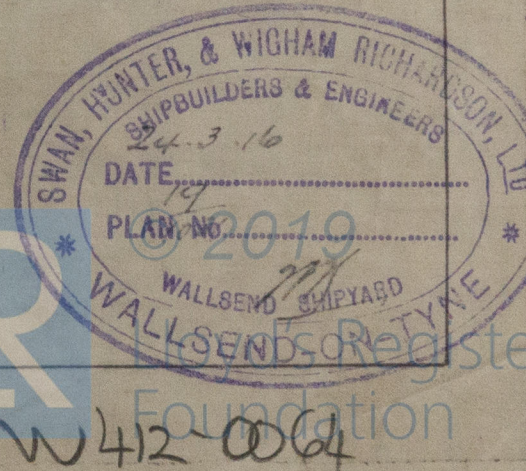








SWAN, HUNTER, + WIGHAM RICHARDSON, LD

Nº 1031

"Southwicks"  
MIDSHIP SECTION


SUNDERLAND RPT. NO. 26927

N.N. Rojo

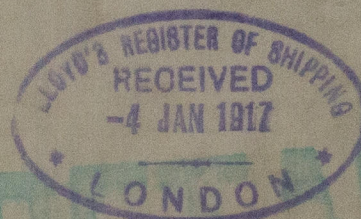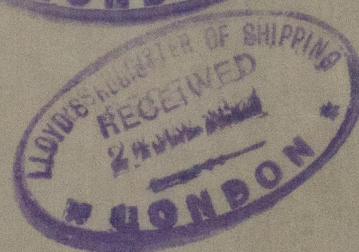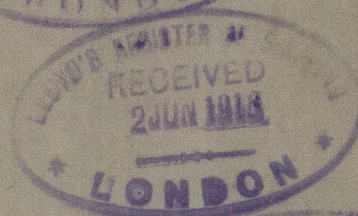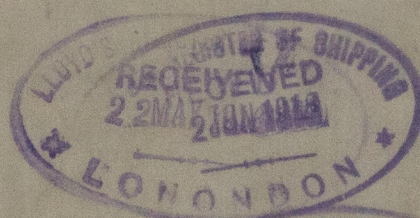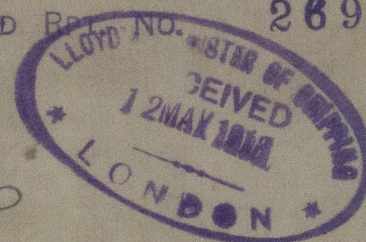

SUNDERLAND RPT. No.

W412-0064

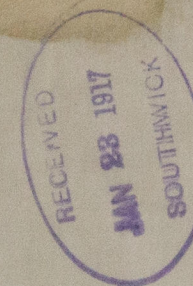

W412-0064



© 2019

Lloyd's Register  
Foundation