

SCALE $\frac{1}{2}'' = 1 \text{ FOOT}$

LENGTH	150'-0"
BREADTH	26'-0" MLD
DEPTH	11'-8" MLD


HULL 5649.
RAISED GUARTEE 55' 6" 5" = 192.
FORECASTLE 54' 6" 6" 5" = 120.
ENGINEER'S HOUSE 10' 9" 6" 3" 5" = 34.
CASING 25' 1" 6" 6" 5" = 82.
MESS ROOM 9' 6" 6" 5" = 31.
= 6108

CLASS 100A.1 LLOYDS
LLOYDS NUMERALS


DEPTH MLD 11.66'
BREADTH MLD 26.00'
37.66 = TRANS NO
LENGTH B.P. 150'-0"
5649 = 1 LONG 4 NO

DEPTH MLD 15-12'
BREADTH MLD 26-00'
41-12' TRANS NO
 $\frac{b}{d} = 9.93$
 $d = 13' 10'' \checkmark$

2 BOWER PUNCHES EACH	10 1/2 CWTs	STOCKLESS ✓
1 " "	8 3/4 "	" " ✓
1 STREAM "	3 1/2 "	EX STOCK ✓
1 KEDGE "	1 1/2 "	" " " ✓
165 FATHOMS	1 1/6 "	STUD CHAIN CABLE ✓
60 "	2 3/4 "	STEEL STREAM WIRE ✓
75 "	2 1/2 "	TOW LINE ✓
1 HAWSE 30 FATHOMS	5 1/2 "	

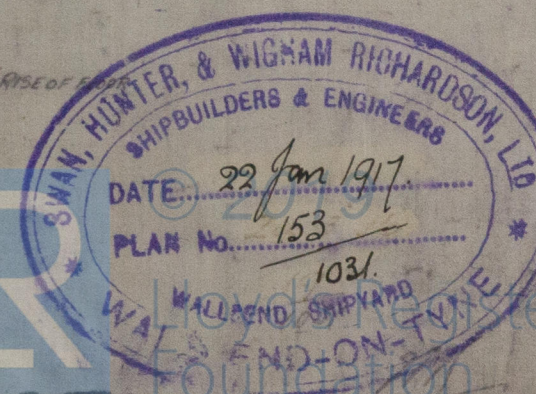

W412-0070

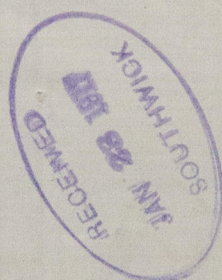

MIDSHIP SECTION
Rejo
S.S. SOUTHWICK (AS FITTED)

SWAN HUNTER AND WIGHAM RICHARDSON'S
Nº 1031

SLO. RPT. Nº 26927

RETAI

W412-0070



© 2019

Lloyd's Register
Foundation