


Nº 1031  
PROFILE & DECK PLANS  
SCALE  $\frac{1}{4}$  = ONE FOOT  
TO CLASS 100A' LLOYDS  
DIMENSIONS 150'0" x 26'0" MLD x 11'8" MLD



SWAN, HUNTER & WIGAM RICHARDSON LTD.  
 SHIPBUILDERS & ENGINEERS  
 DATE 22<sup>nd</sup> Jan 1917  
 PLAN No. 1031  
 WALSLEY SHIPYARD  
 WALSLEY-ON-TYNE  
 24.3.16. PLAN No. 18

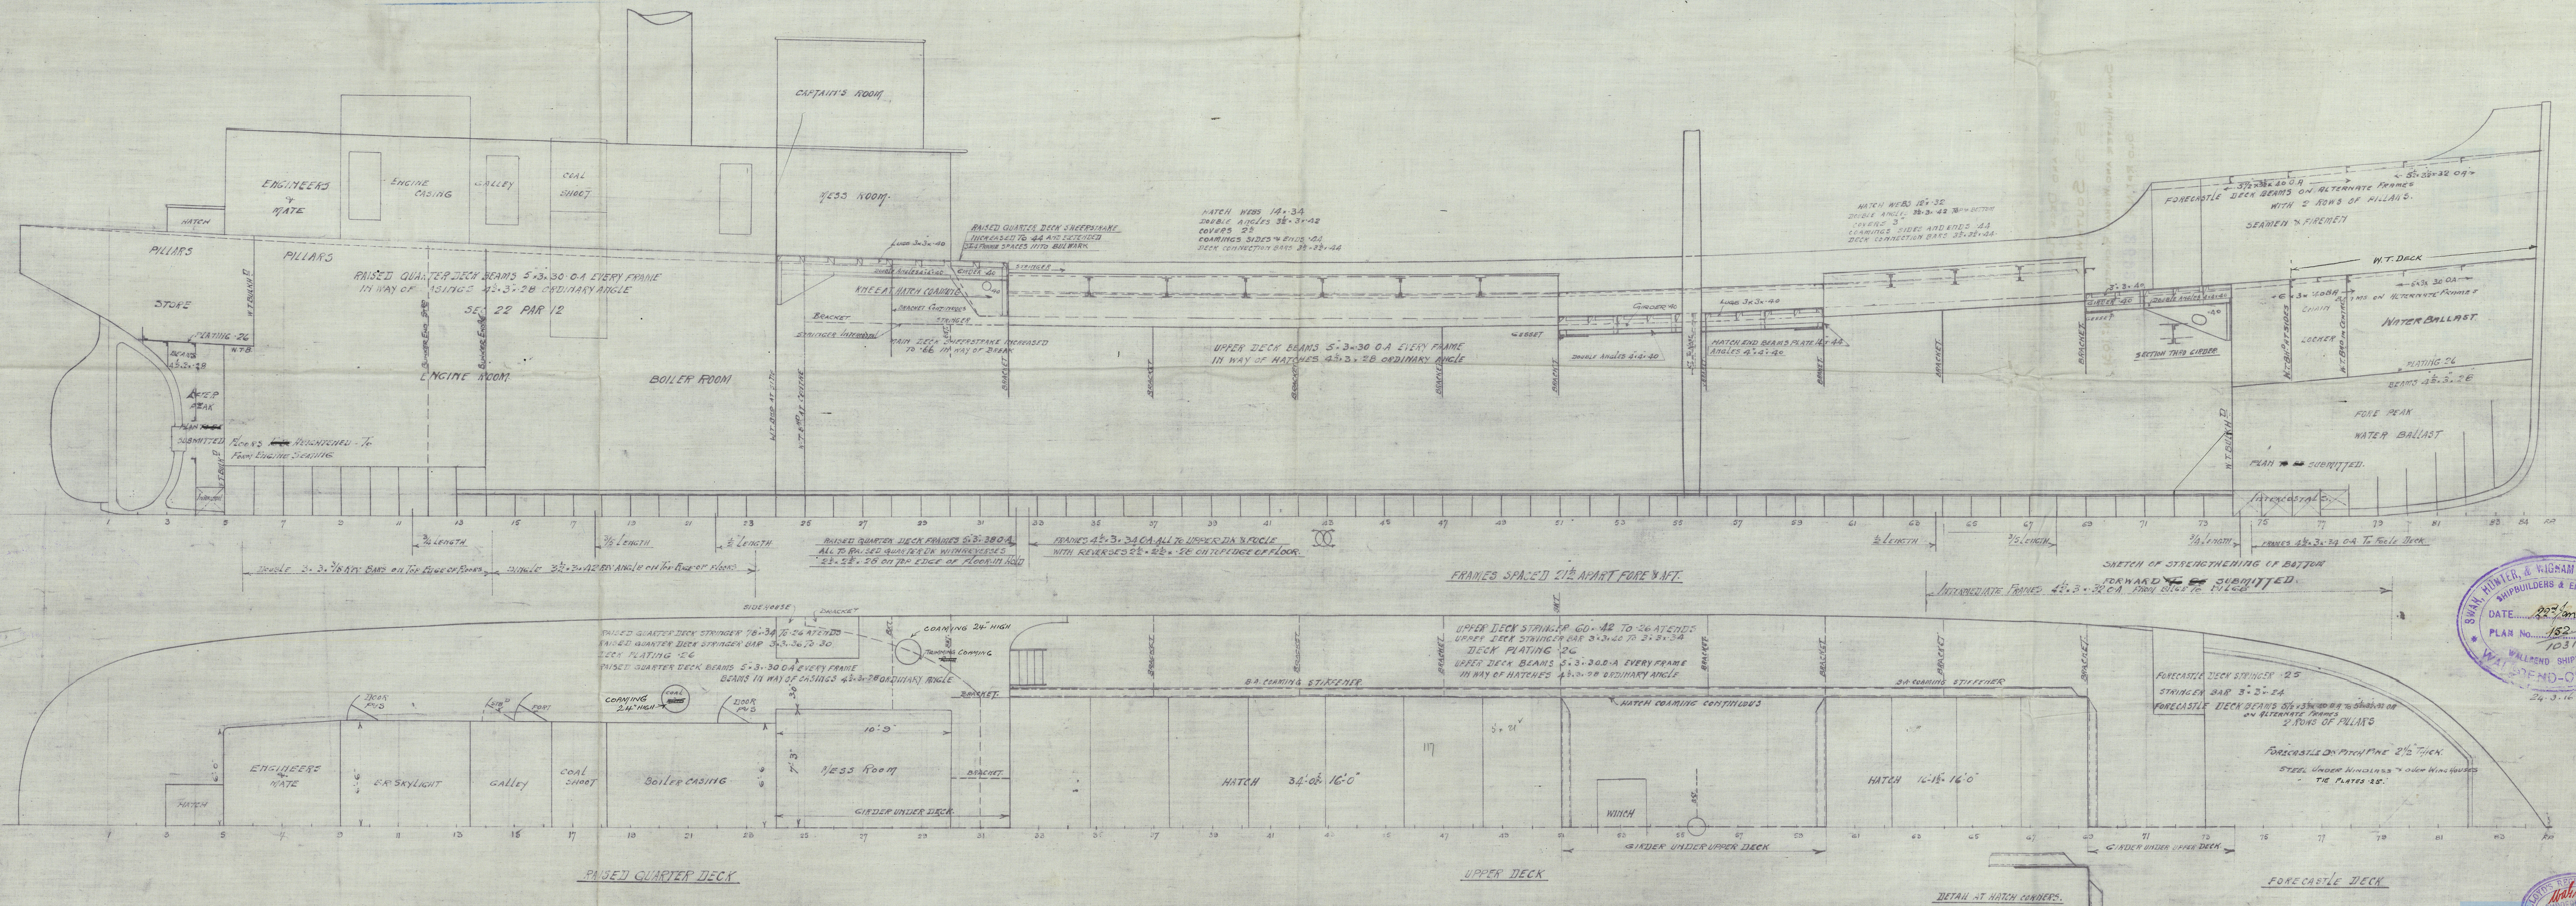


PROFILE AND DECK PLAN (AS FITTED)

*Ro 10<sup>esc</sup>*  
S. S. SOUTHWICK

SWAN HUNTER AND WIGHAM RICHARDSON'S N° 1031

SLD RPI N° **26927**

RETAIN

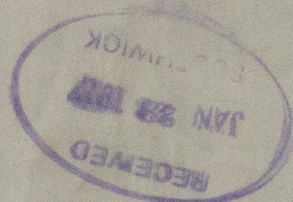

W412-0082 © 2019



Lloyd's Register  
Foundation