
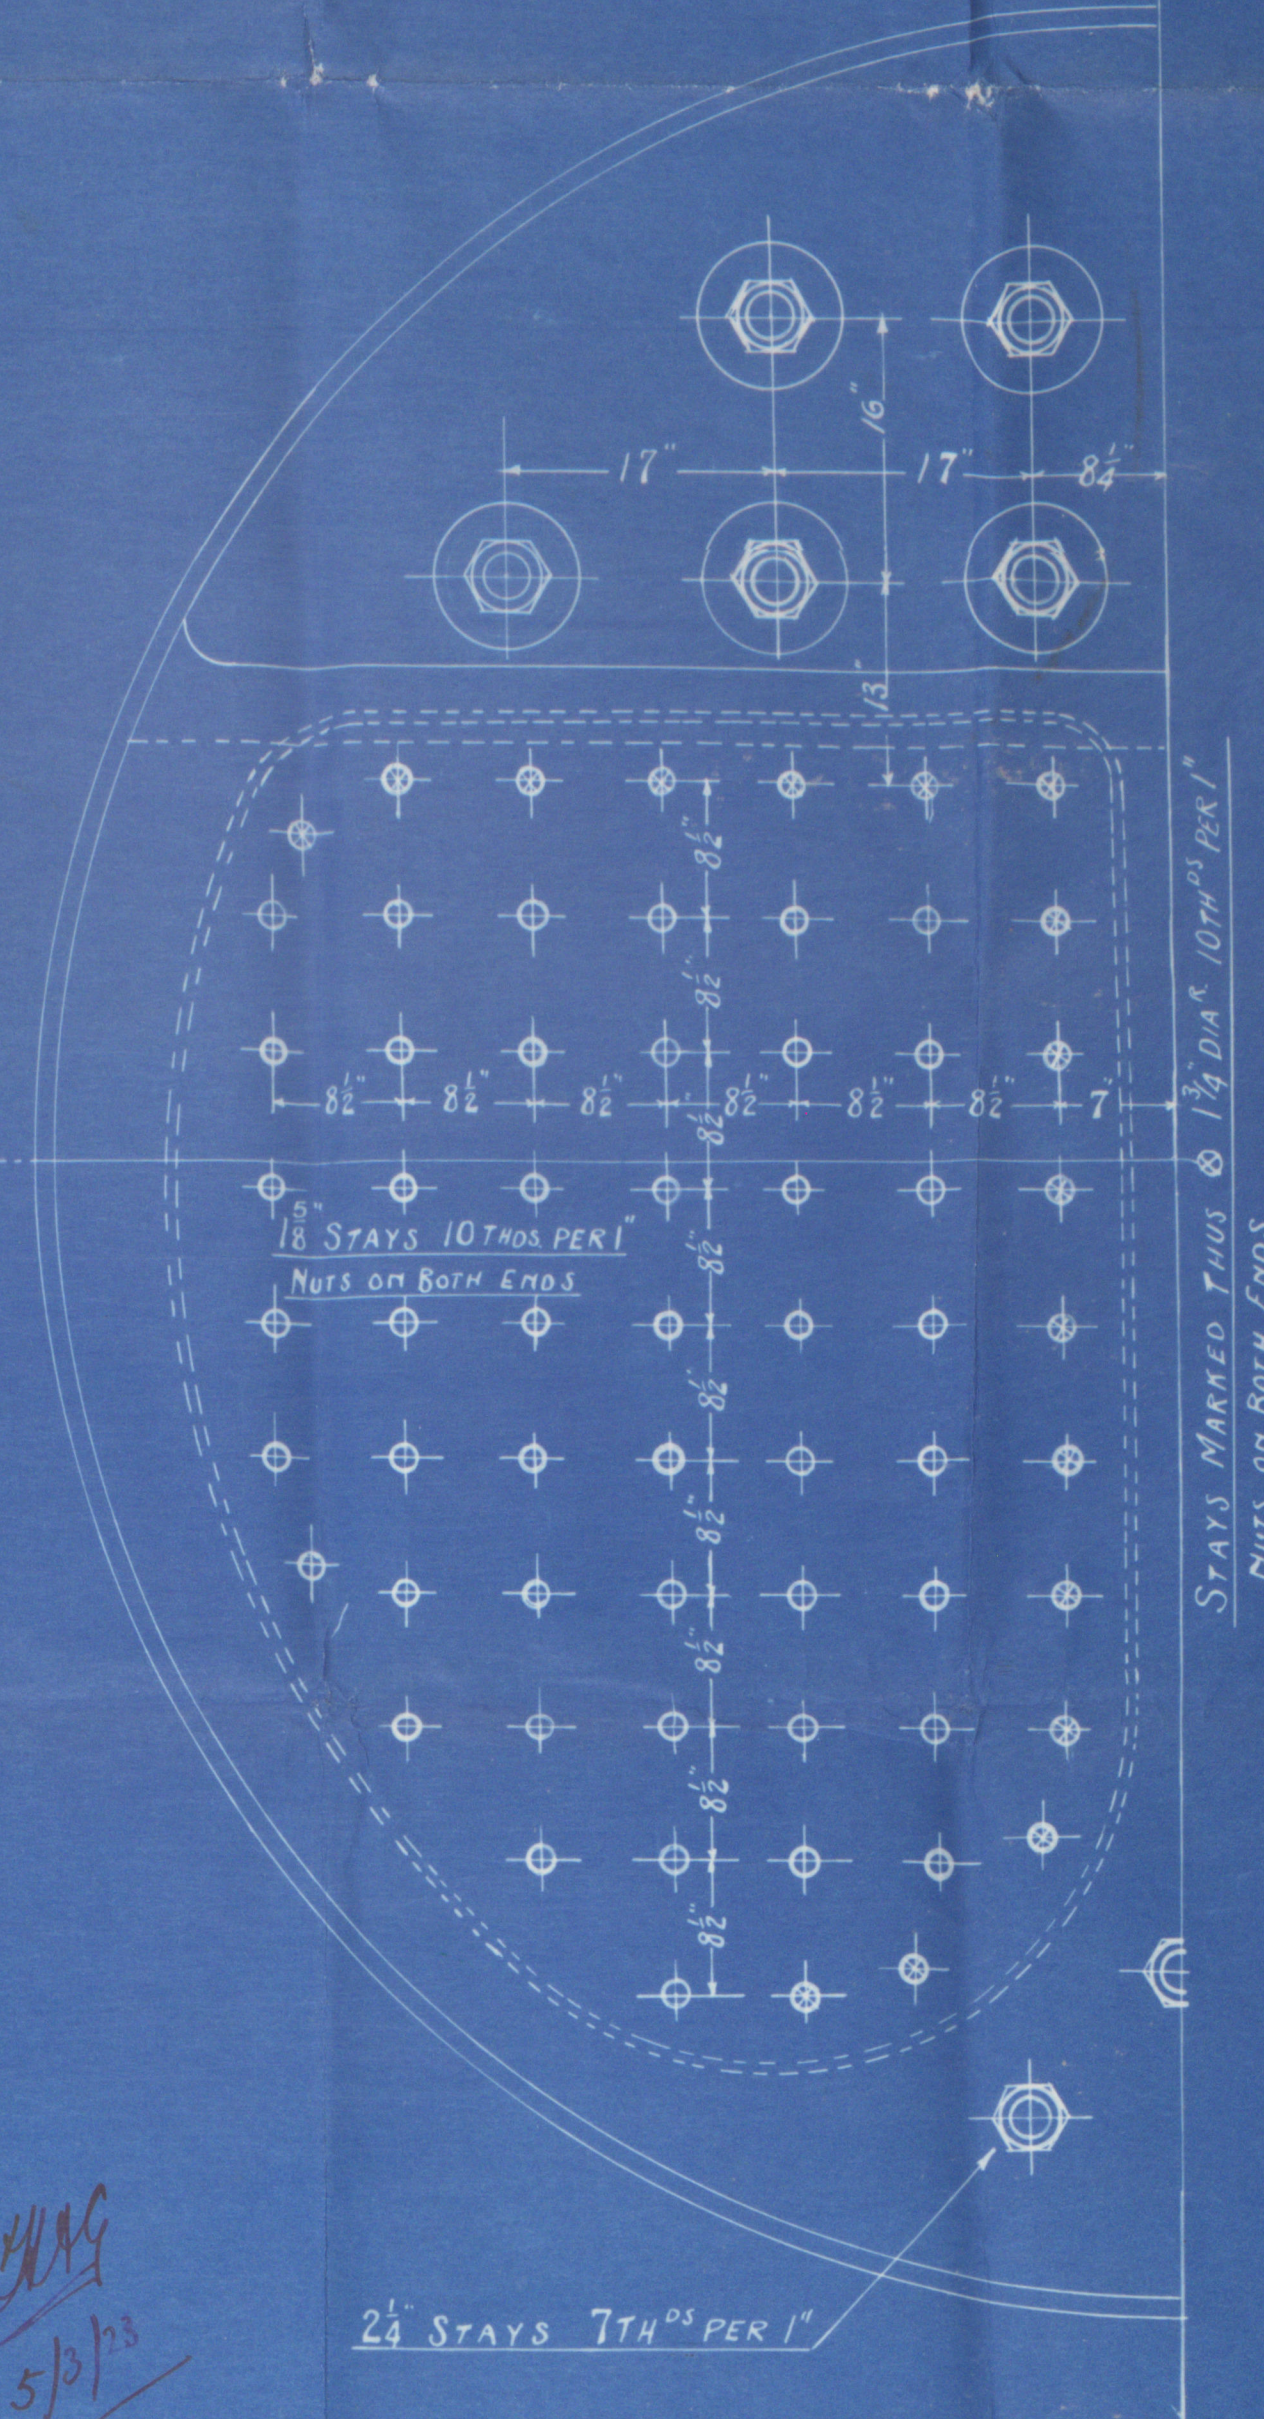


CIRCUMFERENCE DOUBLE RIVETED  
18 HOLES 3 3/8" PITCH

PLATE - 85.7%  
RIVET - 86.4%

LONG SEAMS DOUBLE BUTT STRAPS  
1 HOLES 7" PITCH  
BUTT STRAPS 3/8" THICK

STEEL PLATES, BARS AND RIVETS  
IRON TUBES  
TENSILE STRENGTH OF SHELL - BUTT STRAPS - GIRDERS  
AND MANHOLE RING 28 TO 32 TONS PER SQ INCH  
ALL HOLES DRILLED IN PLACE

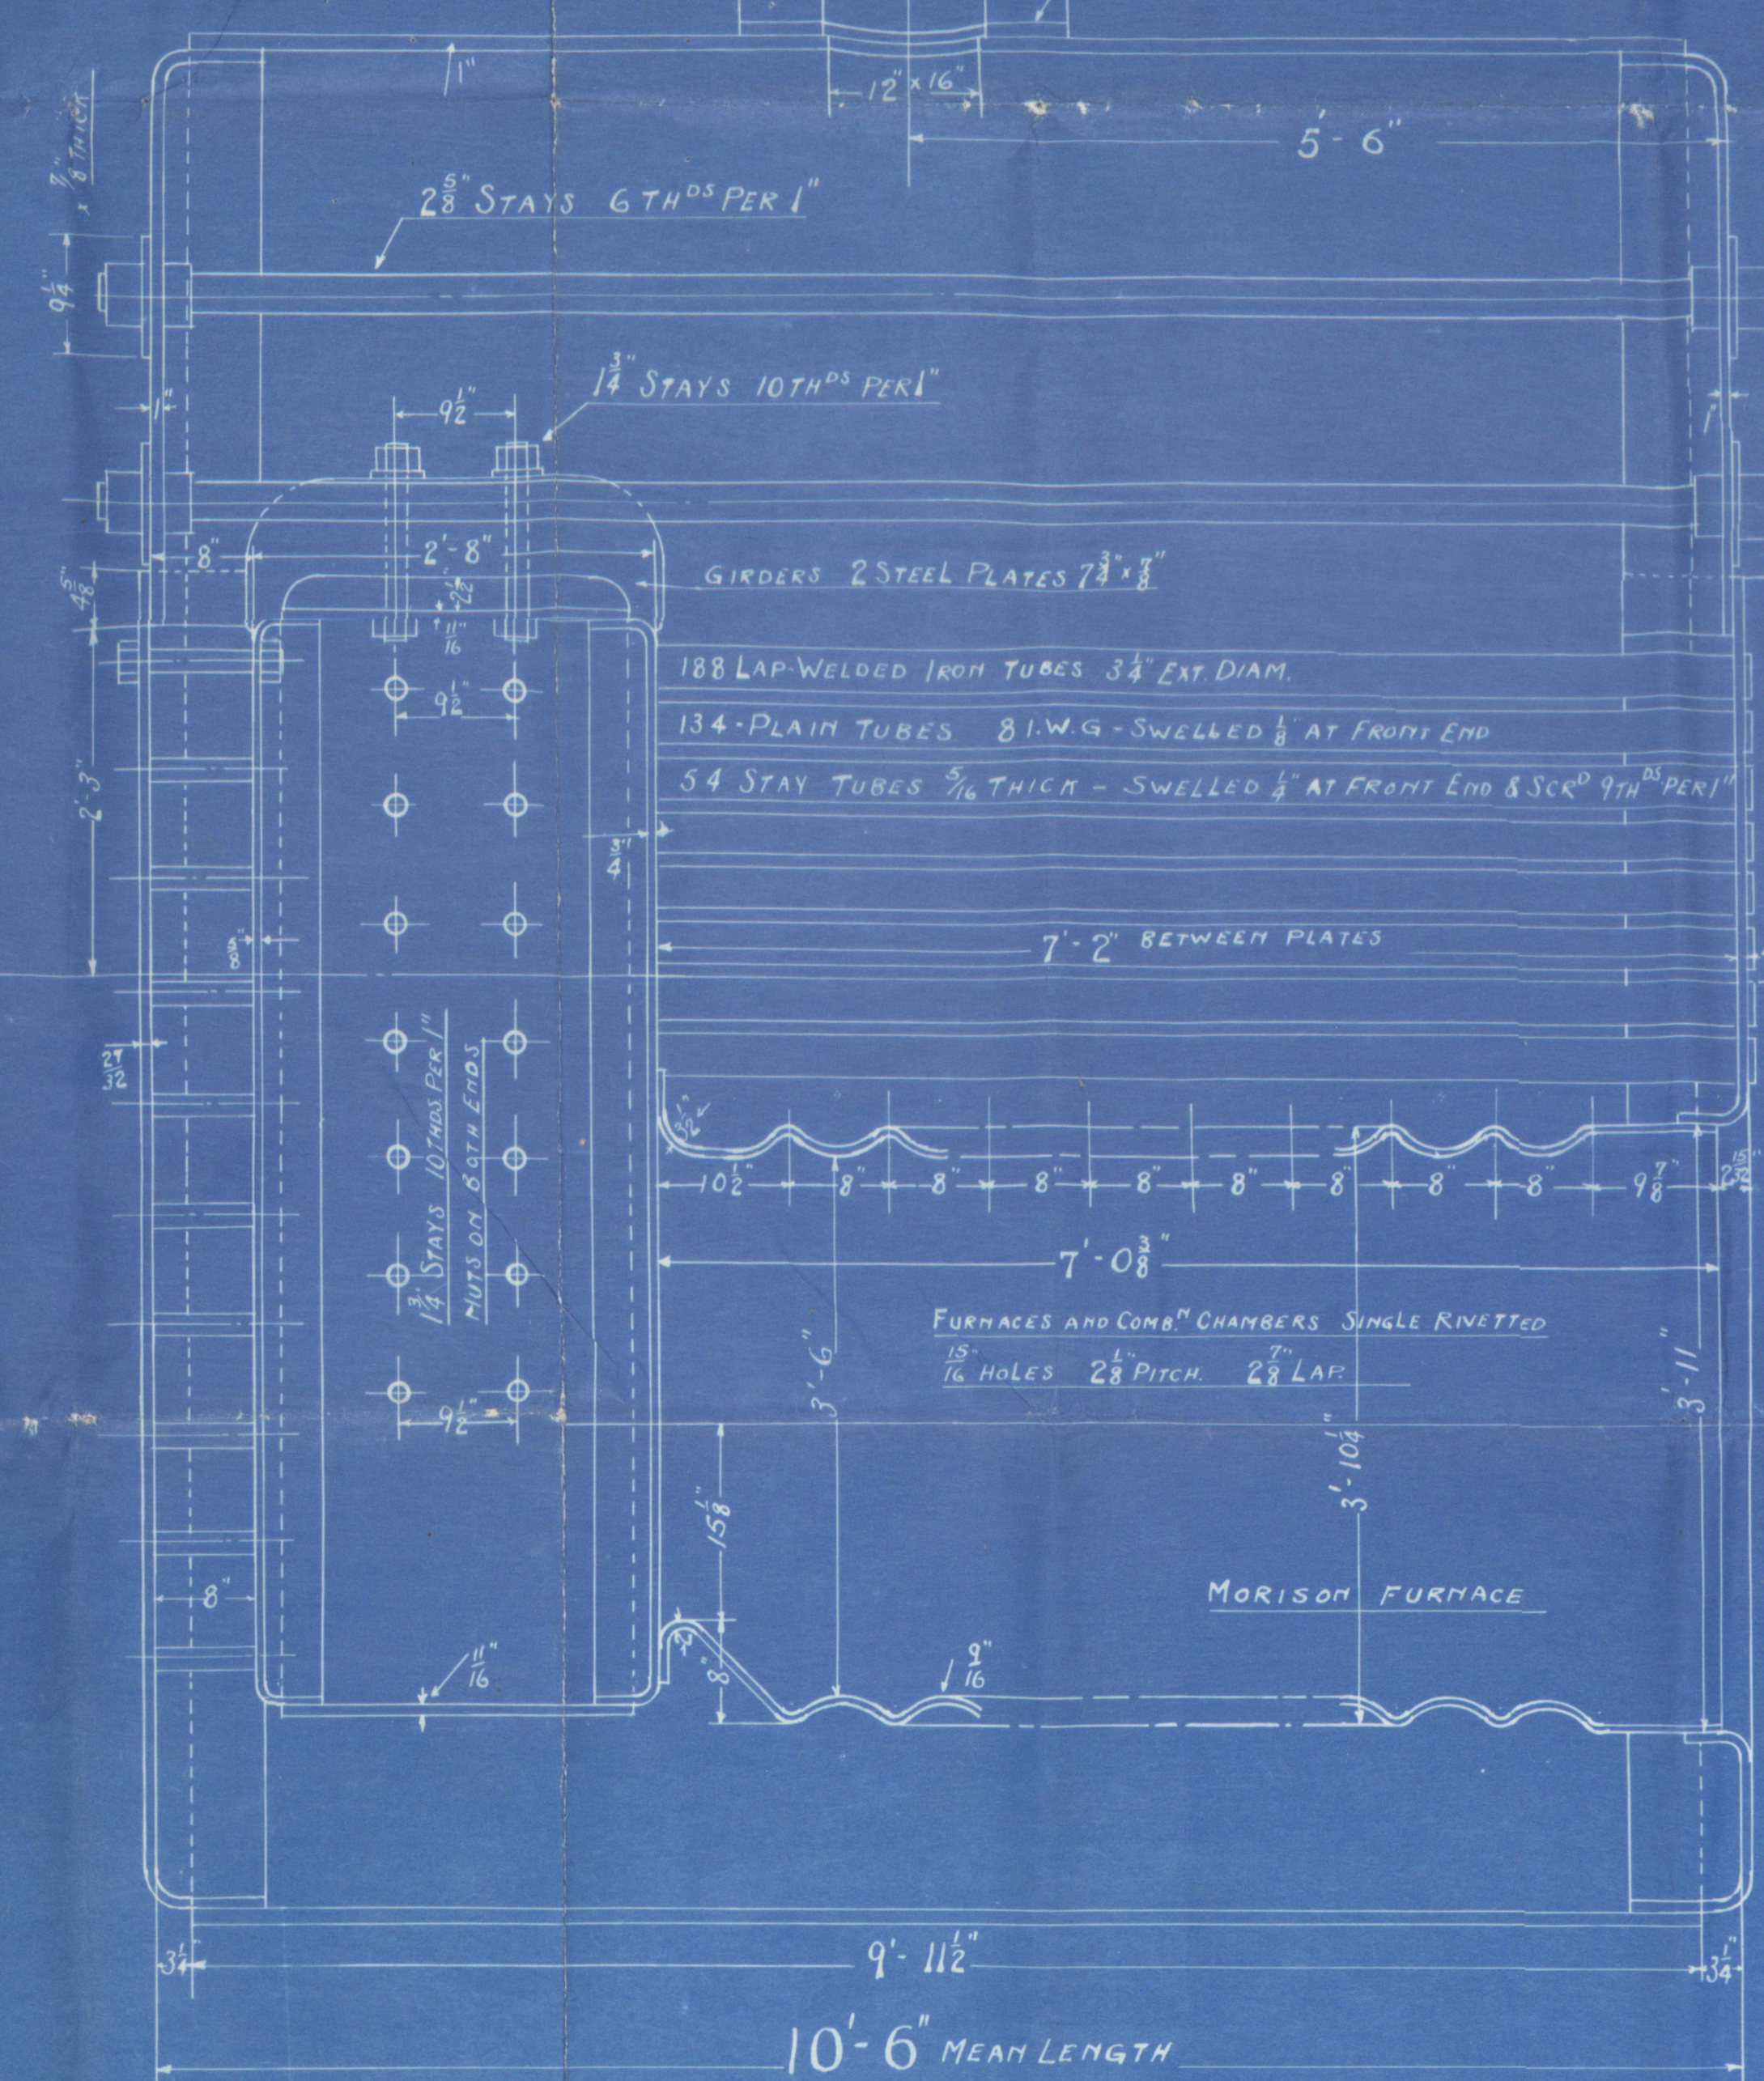


TO HAVE LLOYD'S CERTIFICATE

BOILER N° 1685-1686

WORKING PRESSURE 180 LBS. PER SQ INCH  
SCALE 1/4" = 1 FOOT

GRATE SURFACE (5'-6" BAR)	39.55
TUBE HEATING SURFACE	1147.50
OTHER " "	255.55
TOTAL " "	1403.60
RATIO H.S. TO G.S. = 35.6:1	

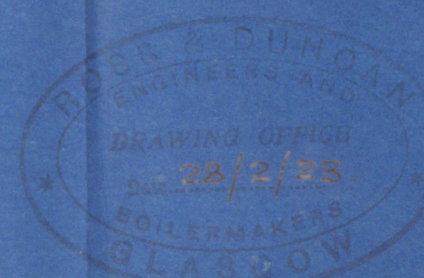



Boo & Duncan

Nº 1685-6.

W. P. 180 lbs.

1685

Nº 16273

Lloyd's test

320 lbs

W. P. 180 "

J. S. C. 7-6-23

Nº 16274

Lloyd's test

320 lbs

W. P. 180 "

J. S. C. 7-6-23

Engine

Nº 1113

GLASGOW REPORT Nº



© 2019 42795

Lloyd's Register  
Foundation

W415-0076