

54198.07

N FREEBOARD AND SUPPL

Particulars of fiddle, funnel and ventilator coverings:—
Fiddle gratings are fitted with hinged steel covers.
E.R. skylight is steel.
Fiddle & funnel vents good.

None.

Particulars of Companionways:—

Bridge:—	entrance to accom ^{ts}	in steel house with hinged wood door.	operating both sides.	Bill 17"
Poof:—	"	"	"	" 18"

Particulars of Ventilators in exposed positions on freeboard and superstructure decks :-

Location	Quantity	Size	Material	Remarks
Wells	4 @	15" dia	led to holds	Coamings 36" x 40" (above trunk).
	1 @	6" " " "	tunnel	36" x 28"
Bridge	1 @	5" " " "	bulkhead	36" x 28"

Closing - wood plugs & canvas covers
The ventilators are in accordance with Rule requirements.


Particulars of Air Pipes in exposed positions on freeboard, raised quarter, or superstructure decks:—

Yoke decks:—	3 @ 3' to 5" dia led to fore peak	D.B. tanks	x 7½" to 12½" to mouth.
Wells:—	4 @ 3" " " "	D.B. tanks	x 20" to mouth.
Bridge:—	2 @ 3½" " " "	" " "	x 13" " "

Effect means of closing provided by wind plugs.

None. ✓

Superstructure bulkheads, trunks, deckhouses, casings, cargo and coaling hatchways, extent and thickness of sheathing on the freeboard deck, gangway, cargo and coaling ports, and any other openings, etc., which would affect the seaworthiness of the ship are to be shown on the following sketches:—

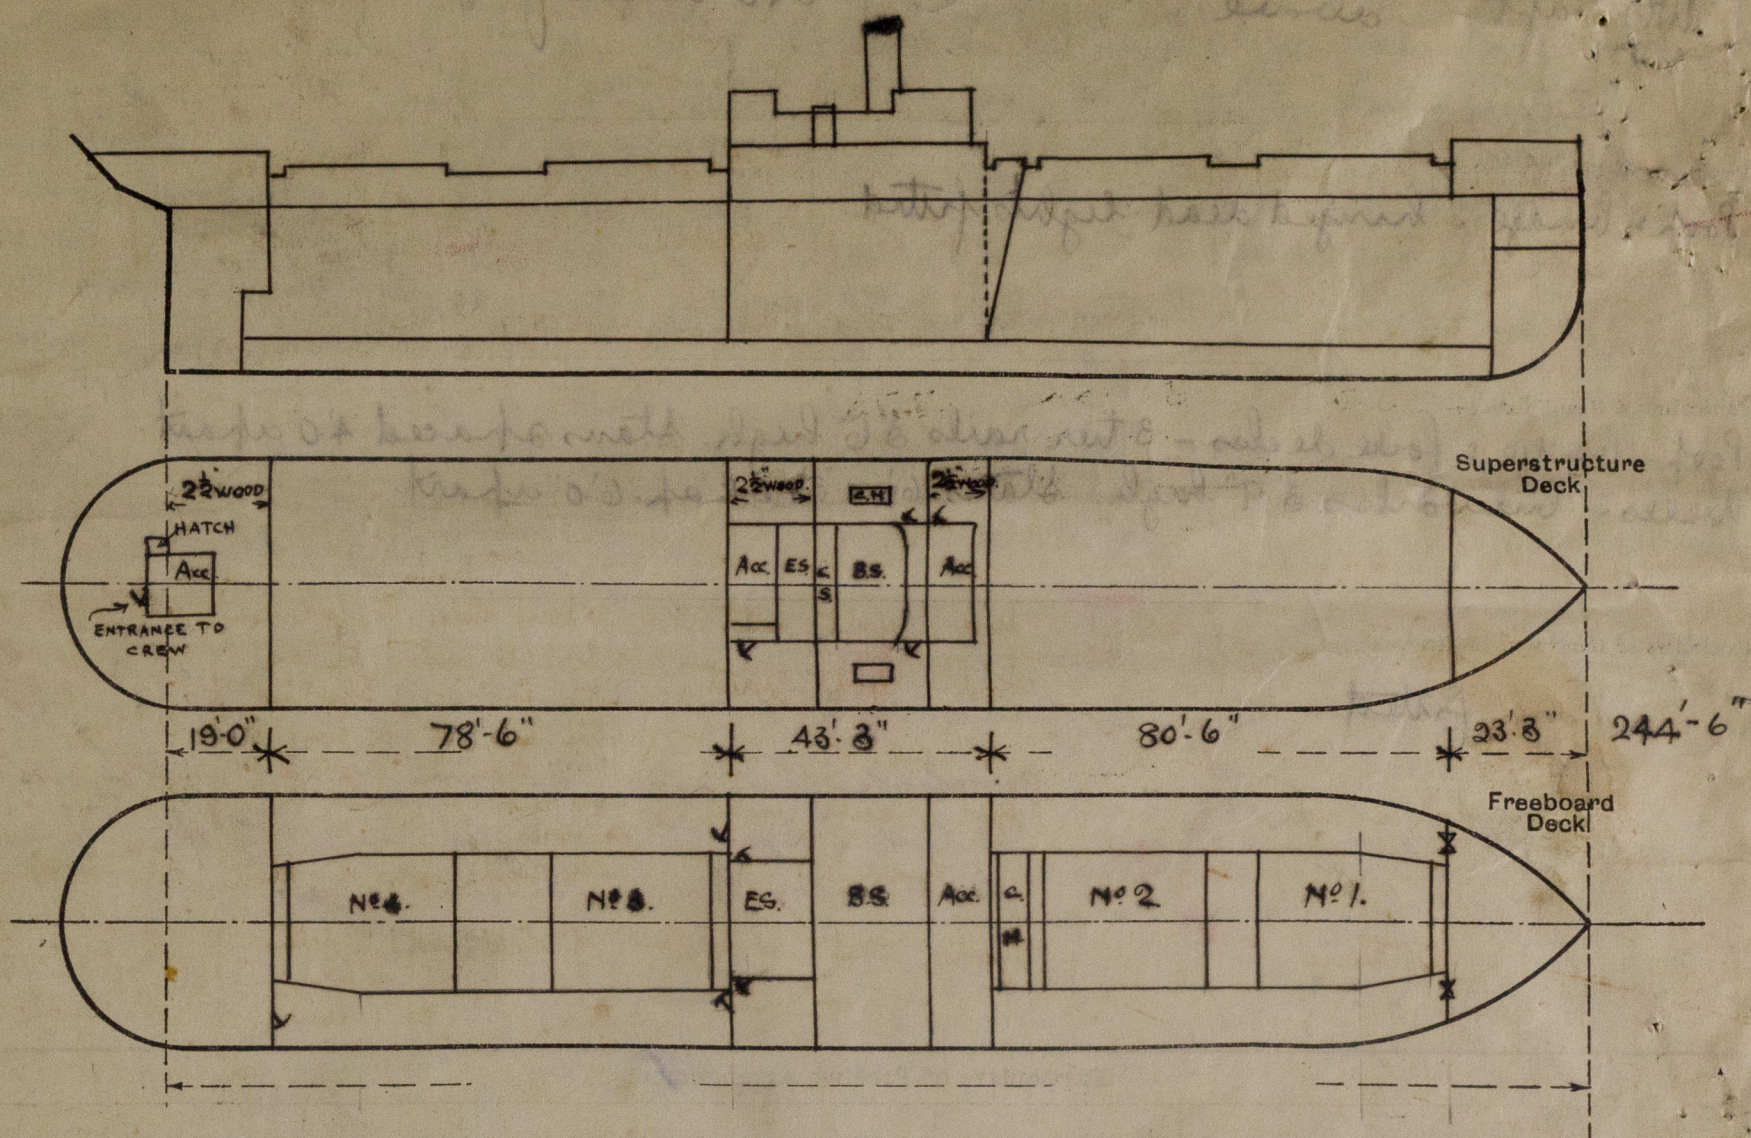

State any special features in the construction of the ship:—

No Limber Assignment required.

Vessel examined in dry-docks. Survey will be completed before sailing.


Builder's name and yard number

Jurness S. B. Co. Ltd.

Names of sister ships

Owners

E. J. Lindley

Fee £

9 : 7 : 0

Received by me