

N^os 307 & 308

MIDSHIP SECTION OF T.S.S.

DIMENSIONS 410' x 52'3" x 27'3" TO UPPER Dth

TO CLASS 100 A.I. LLOYDS. SHADE DECK

SCALE 1/2" = 1 FOOT

7.7.10.


21.7.10

21.9.10

4.10.10

21.10.10

28.10.10

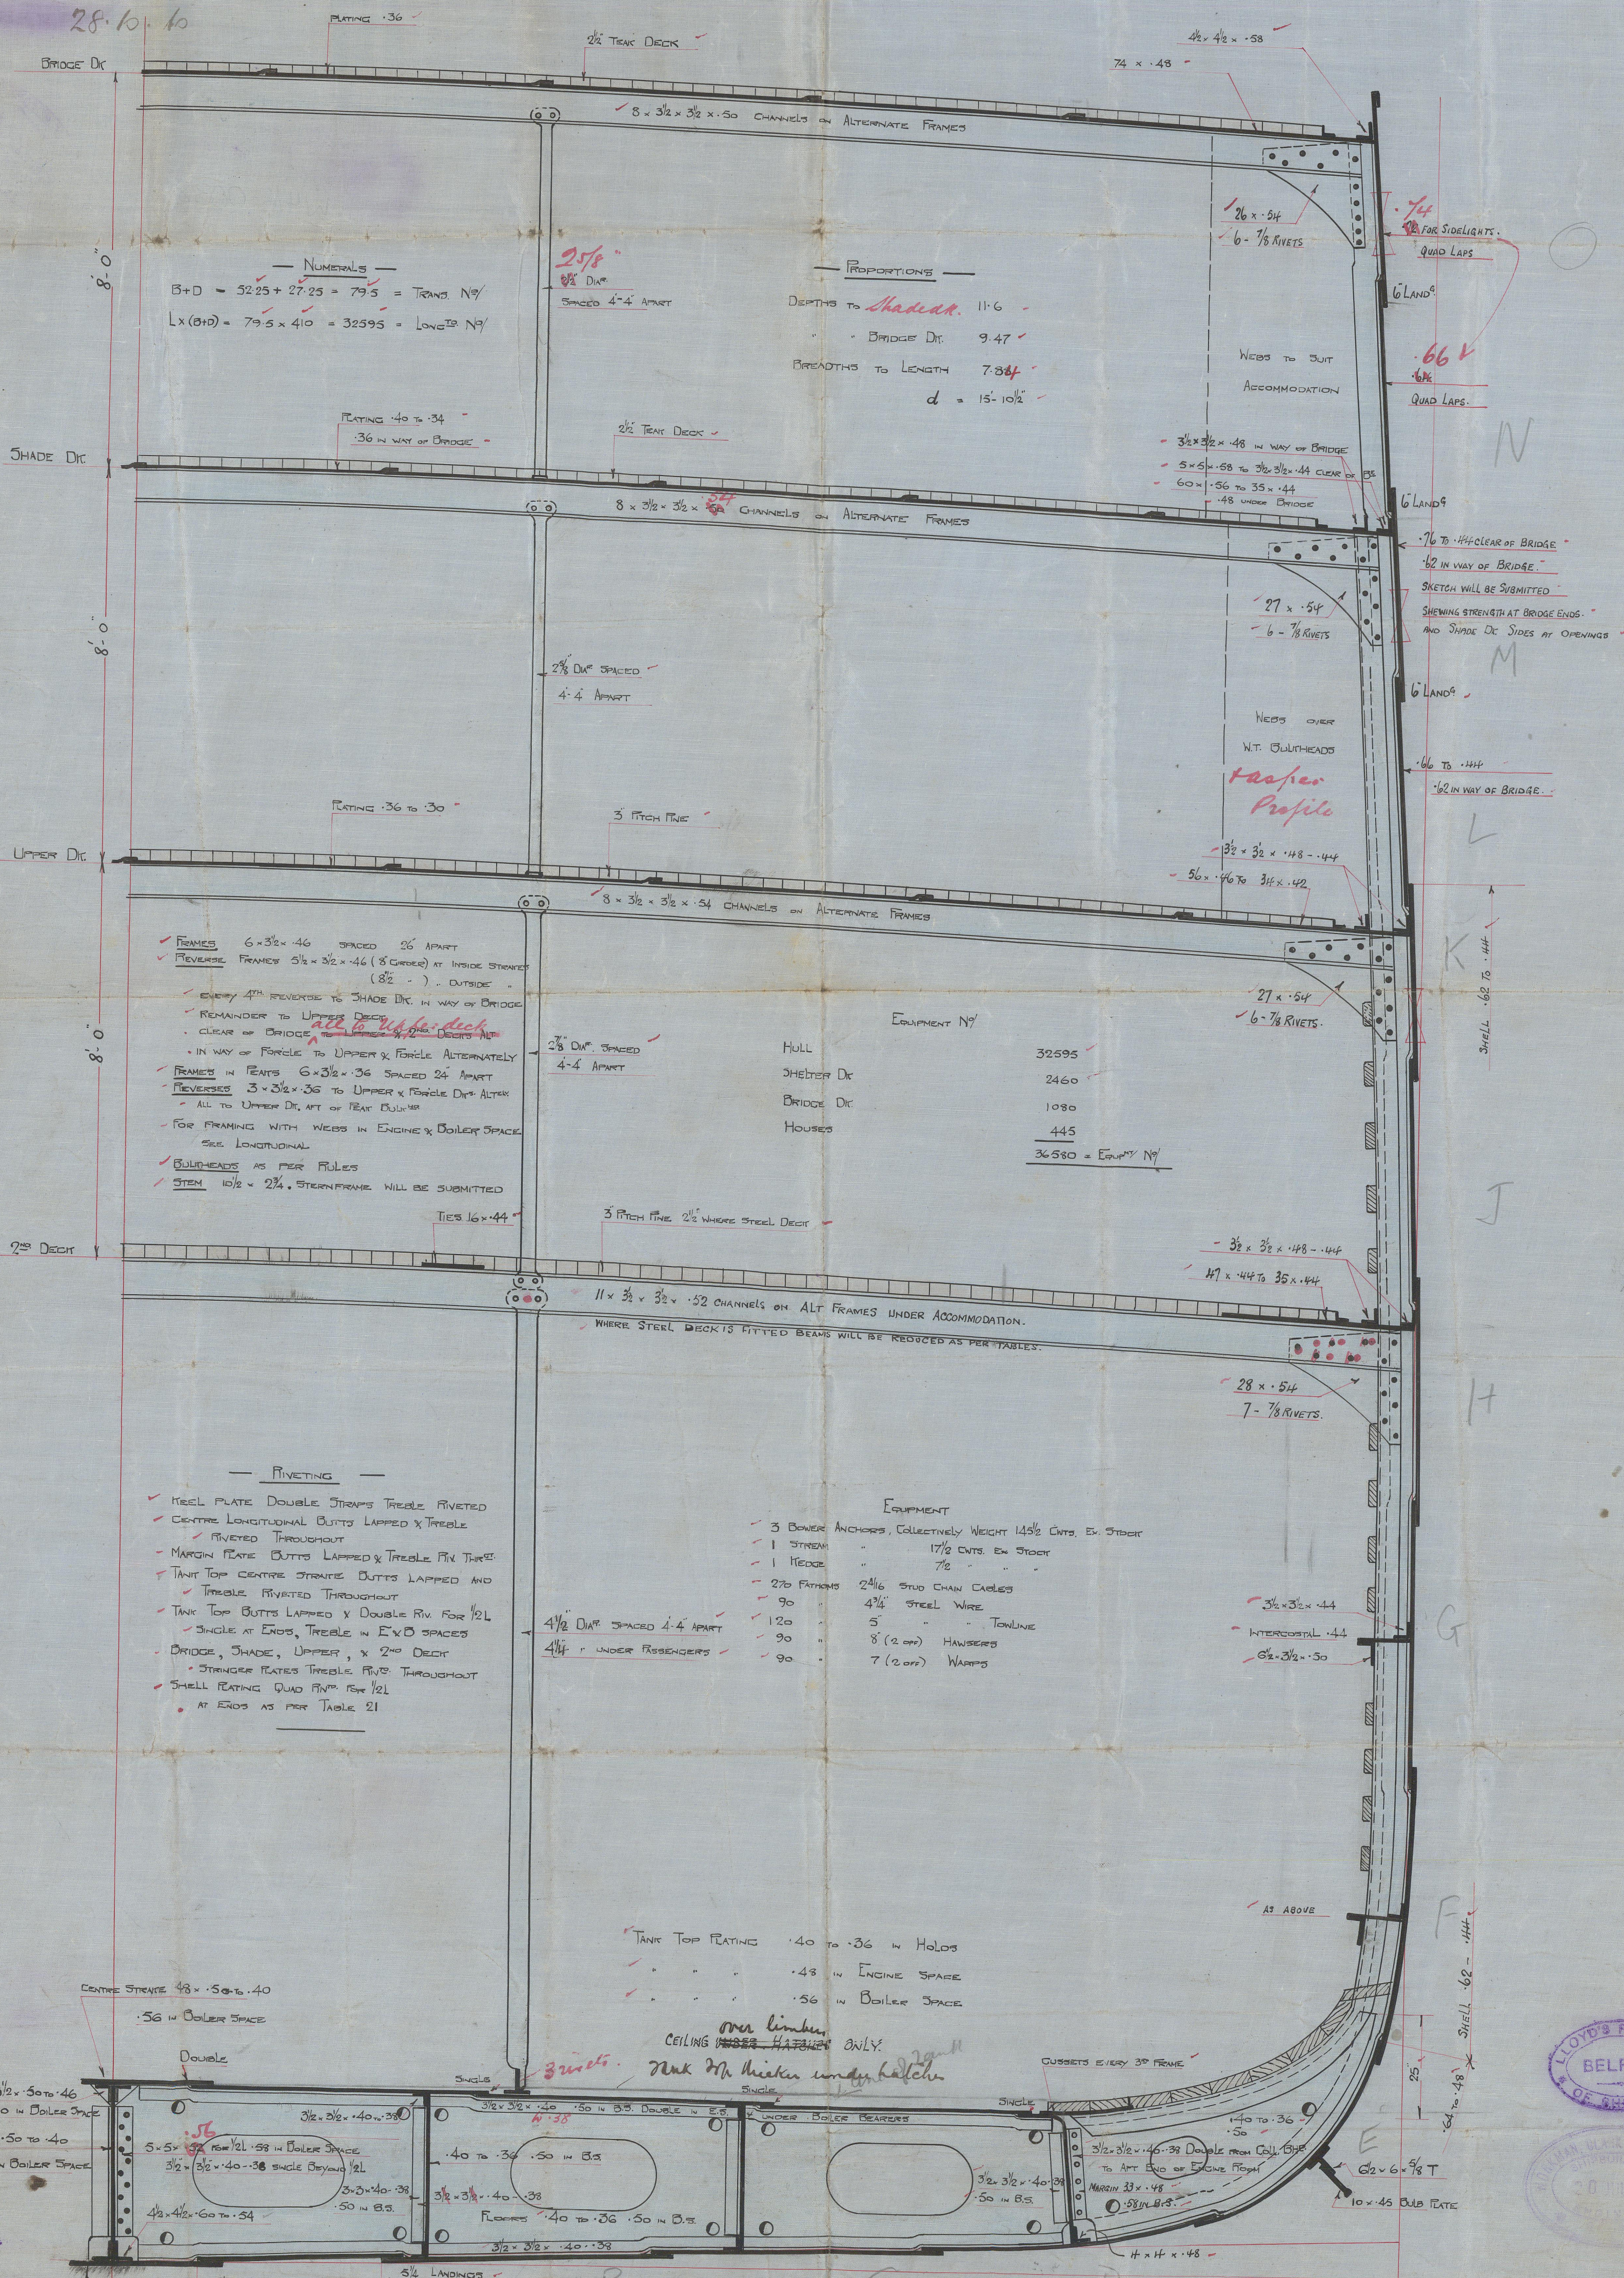

© 2021

Lloyd's Register Foundation

Workman Clark

Nos 307 & 308

Midship Section



S. Egra *

Rel 6974

S. Ekma

Rel 7034



© 2021

Lloyd's Register
Foundation

W416-0038