





Shore deck pillars to have flat bottoms at heads & heels with 2 rivets in each

Note: Maps supported to surveyor satisfaction



S.S. No 459

SCALE 1/4" = 1 FOOT

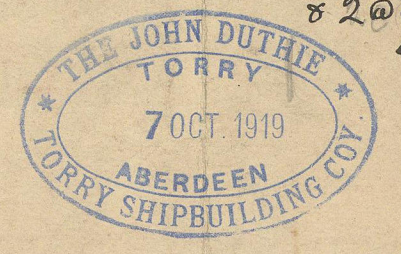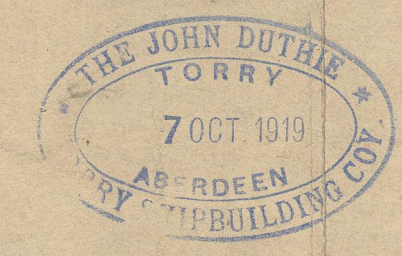


(SEE PAINTING ARRANGT.)

APPROVED
FLOYD'S REGISTER OF SHIPPING

Reverse angle 4x4x1/2" I from tank top to MDK

11-10-19
30-10-19

W416-0137

 

JOHN DUTHIE TORRY S.B COY
PROFILE.

N^{os} 459 + 460.

459. S.S. TRURO.



ABN. REPORT N^o 12908.

N^o 460. SELBY.

ABN. REPORT N^o 13183.

*Wreck 158
Section 2*

RETAIN



© 2021

W416093 Register
Foundation