


Nº 484
MIDSHIP SECTION

DIMENSIONS 395.35' x 53' x 27' MLD TO 2ND DK + 9'-0" TWEEN DKS

TO CLASS 100 A1 "WITH FREE BOARD". LOAD DRAFT 23'-11"

SCALE $\frac{1}{2}'' = 1 \text{ FOOT}$.

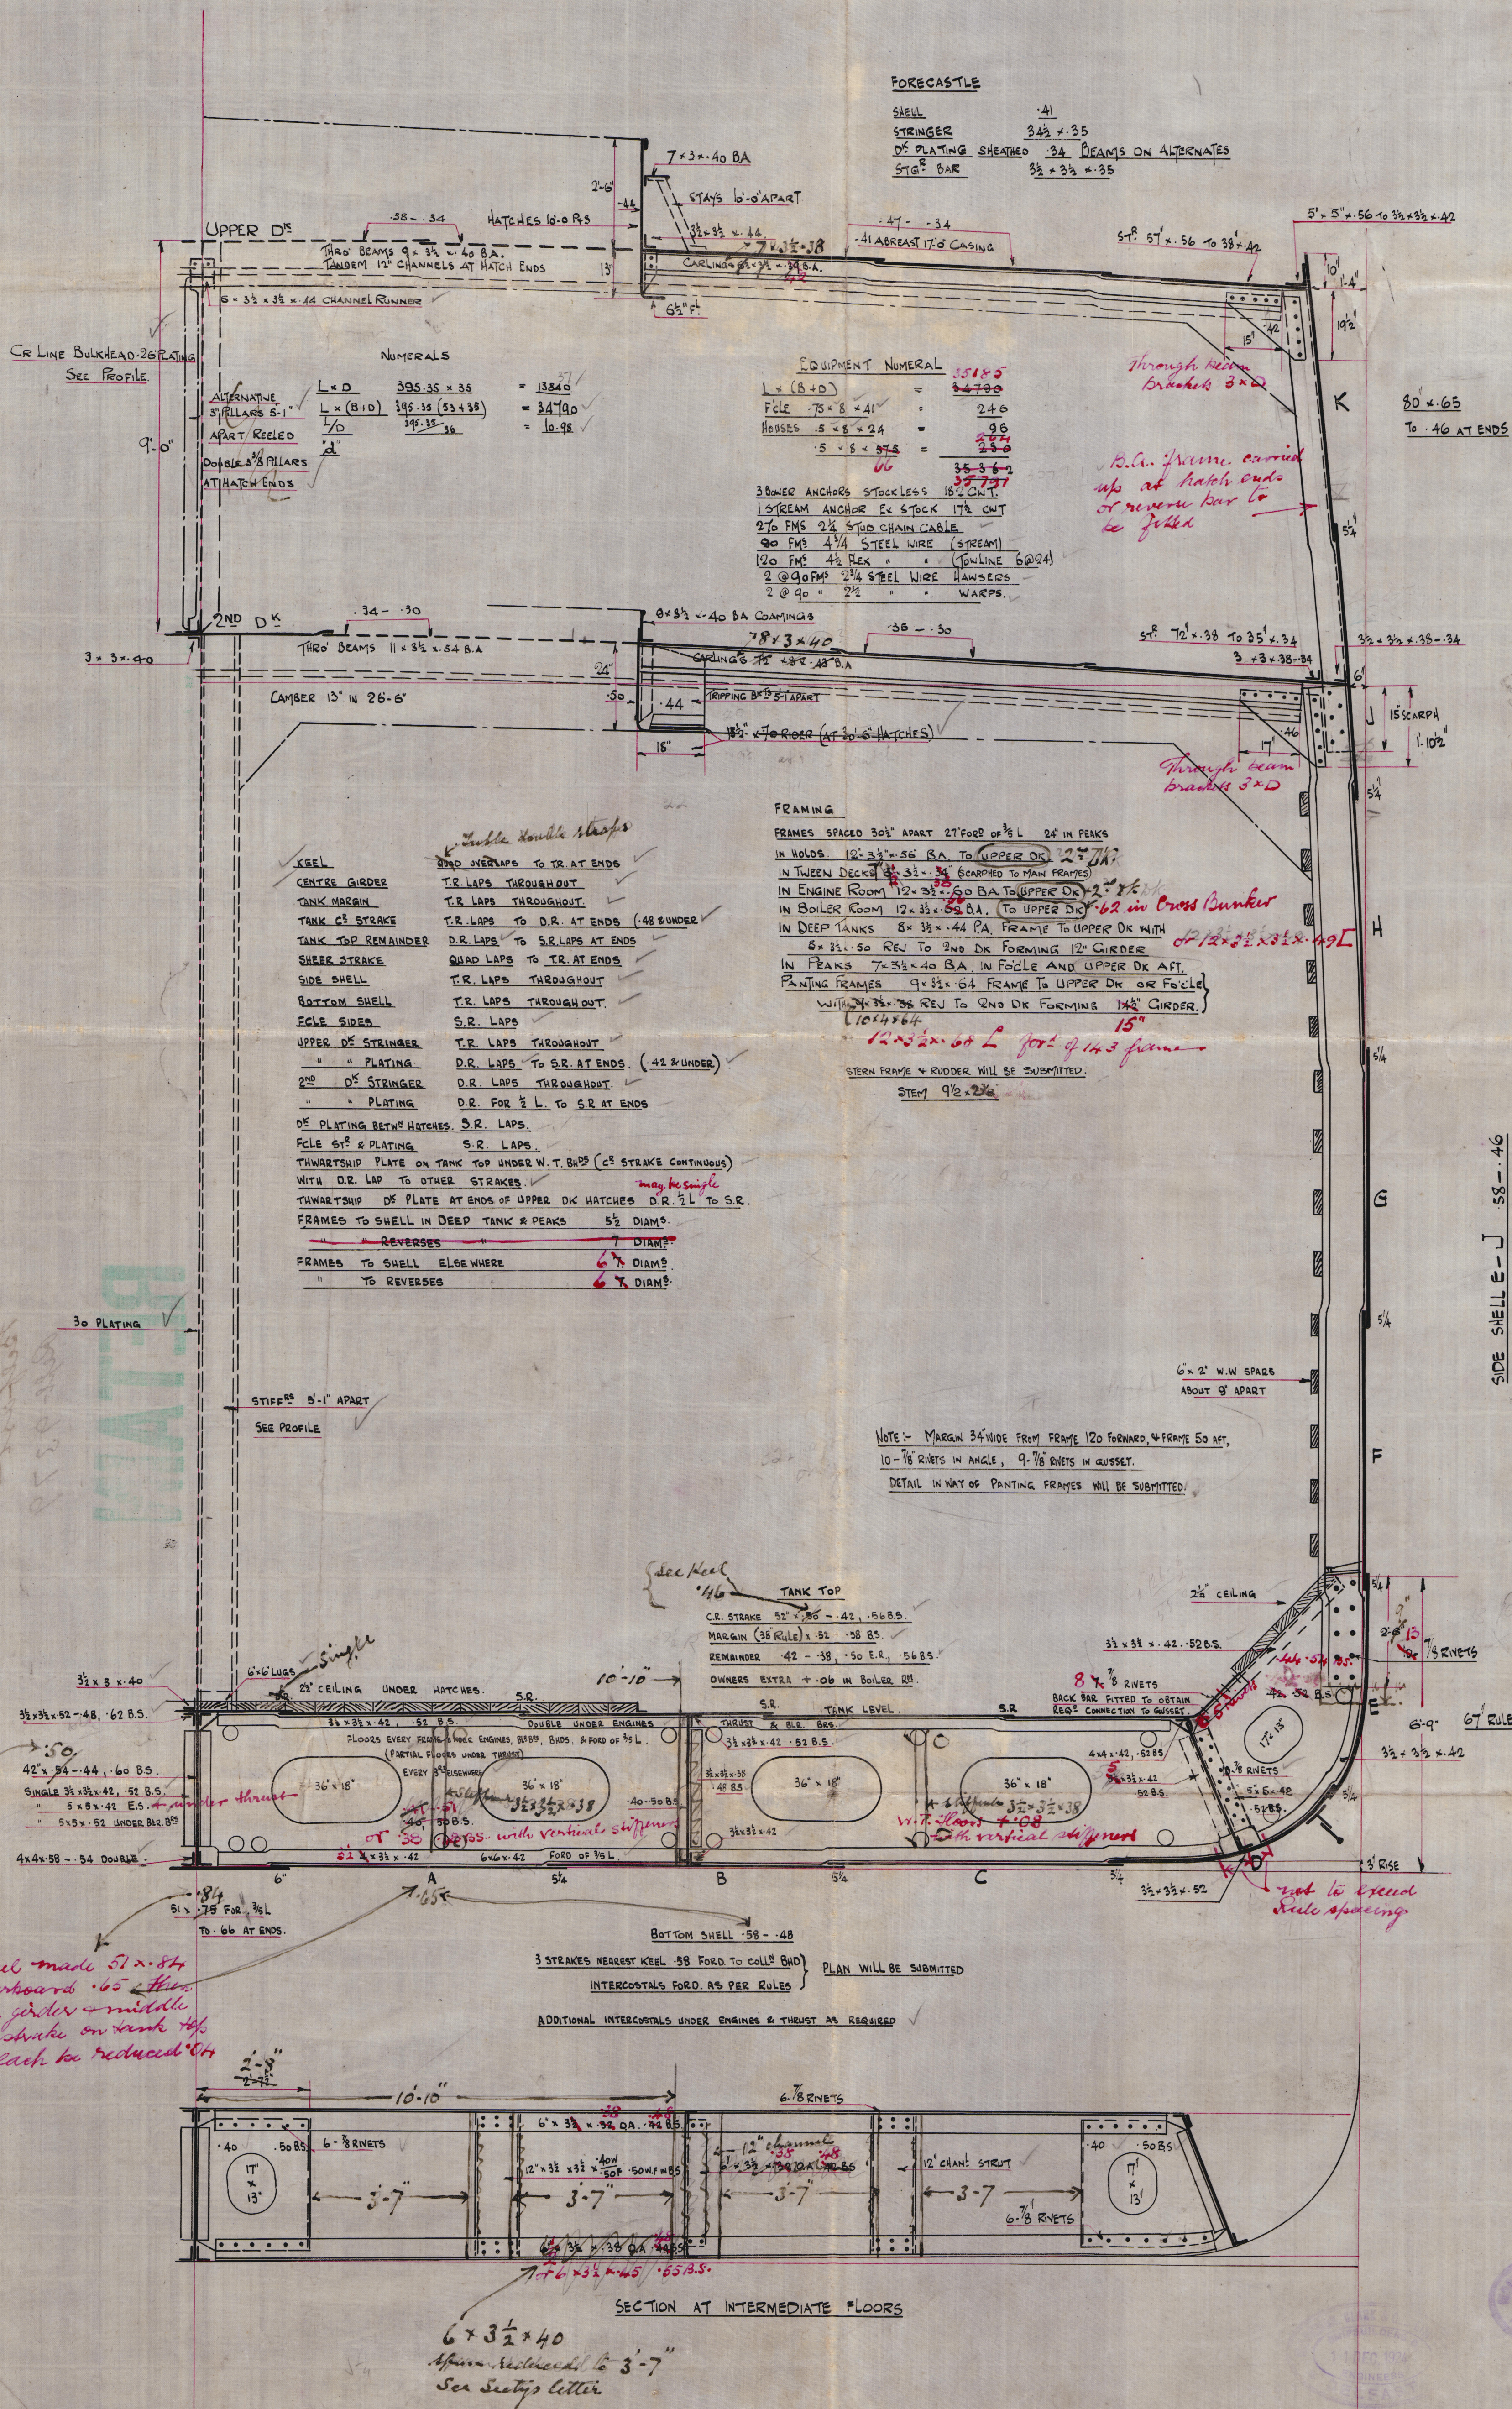

SIDE SHELL E-J .58-.46



N^o 484

JEVINGTON COURT

Repl-9379