




17/11/24

N° 48455. Longitudinal Section & Deck Plans.

Rule Dimensions:- 395'4" x 53' x 36" mid to Upper D"

Scale 1/8" = 1' 0"

*Supporting under windlass, windlass
starting gear & masts to Surveyors Satisfaction*

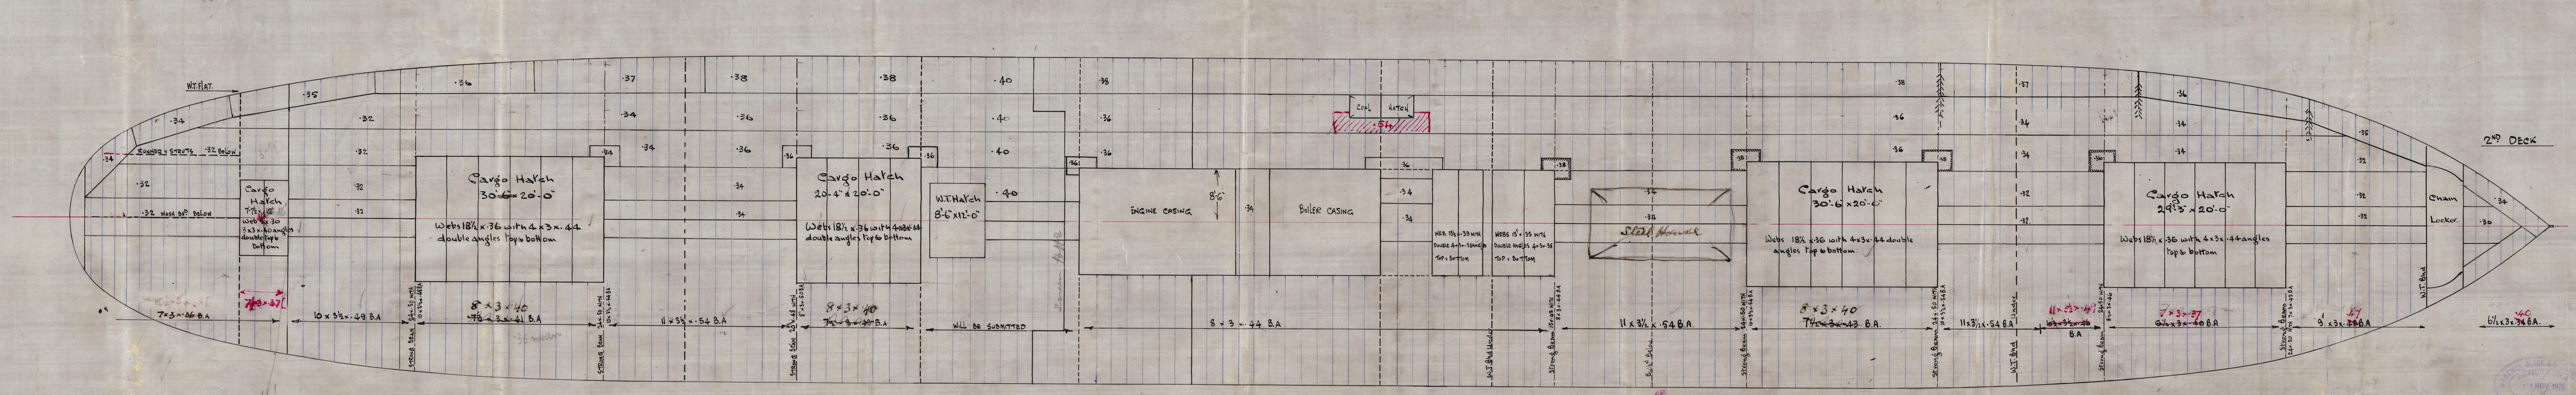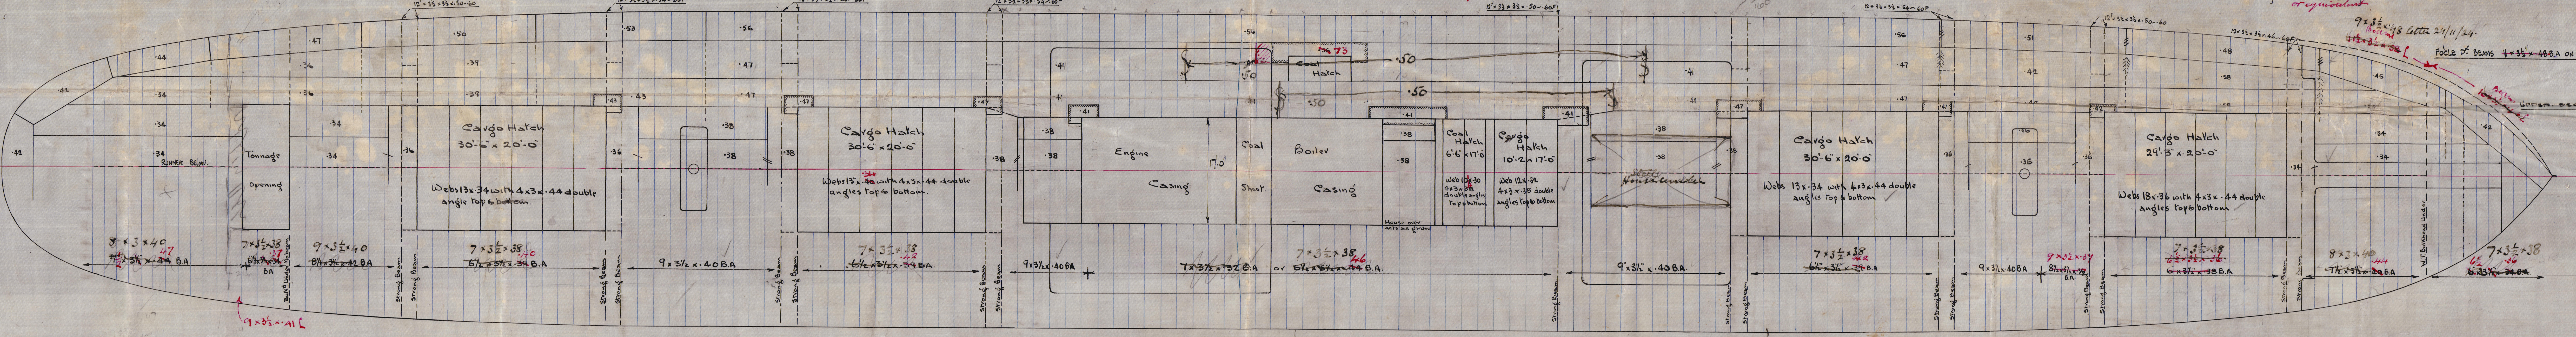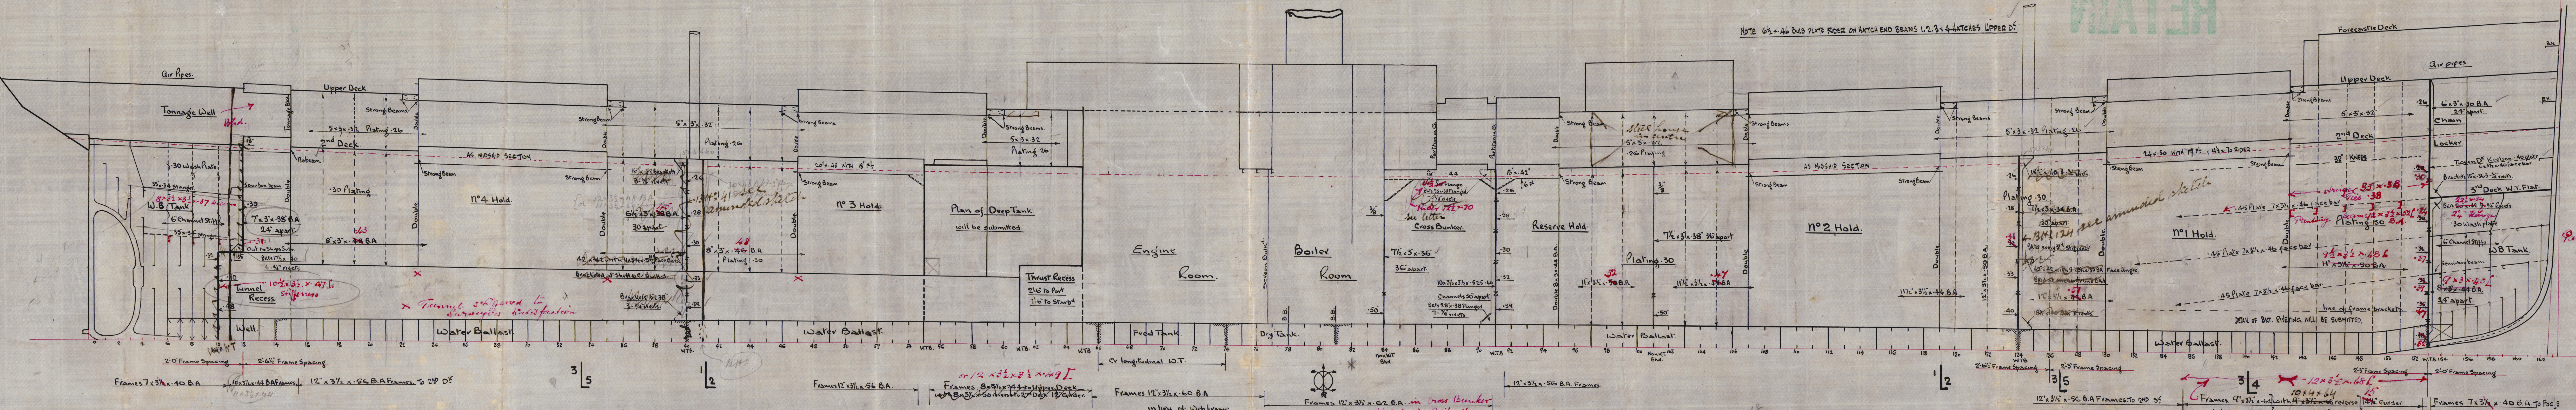

17. 11. 24.

Profile
N^o 484

Workman Clark & C.

"JEVINGTON COURT"

Beefart-

Rept- 9379

RETAIN



© 2019

Lloyd's Register
Foundation