

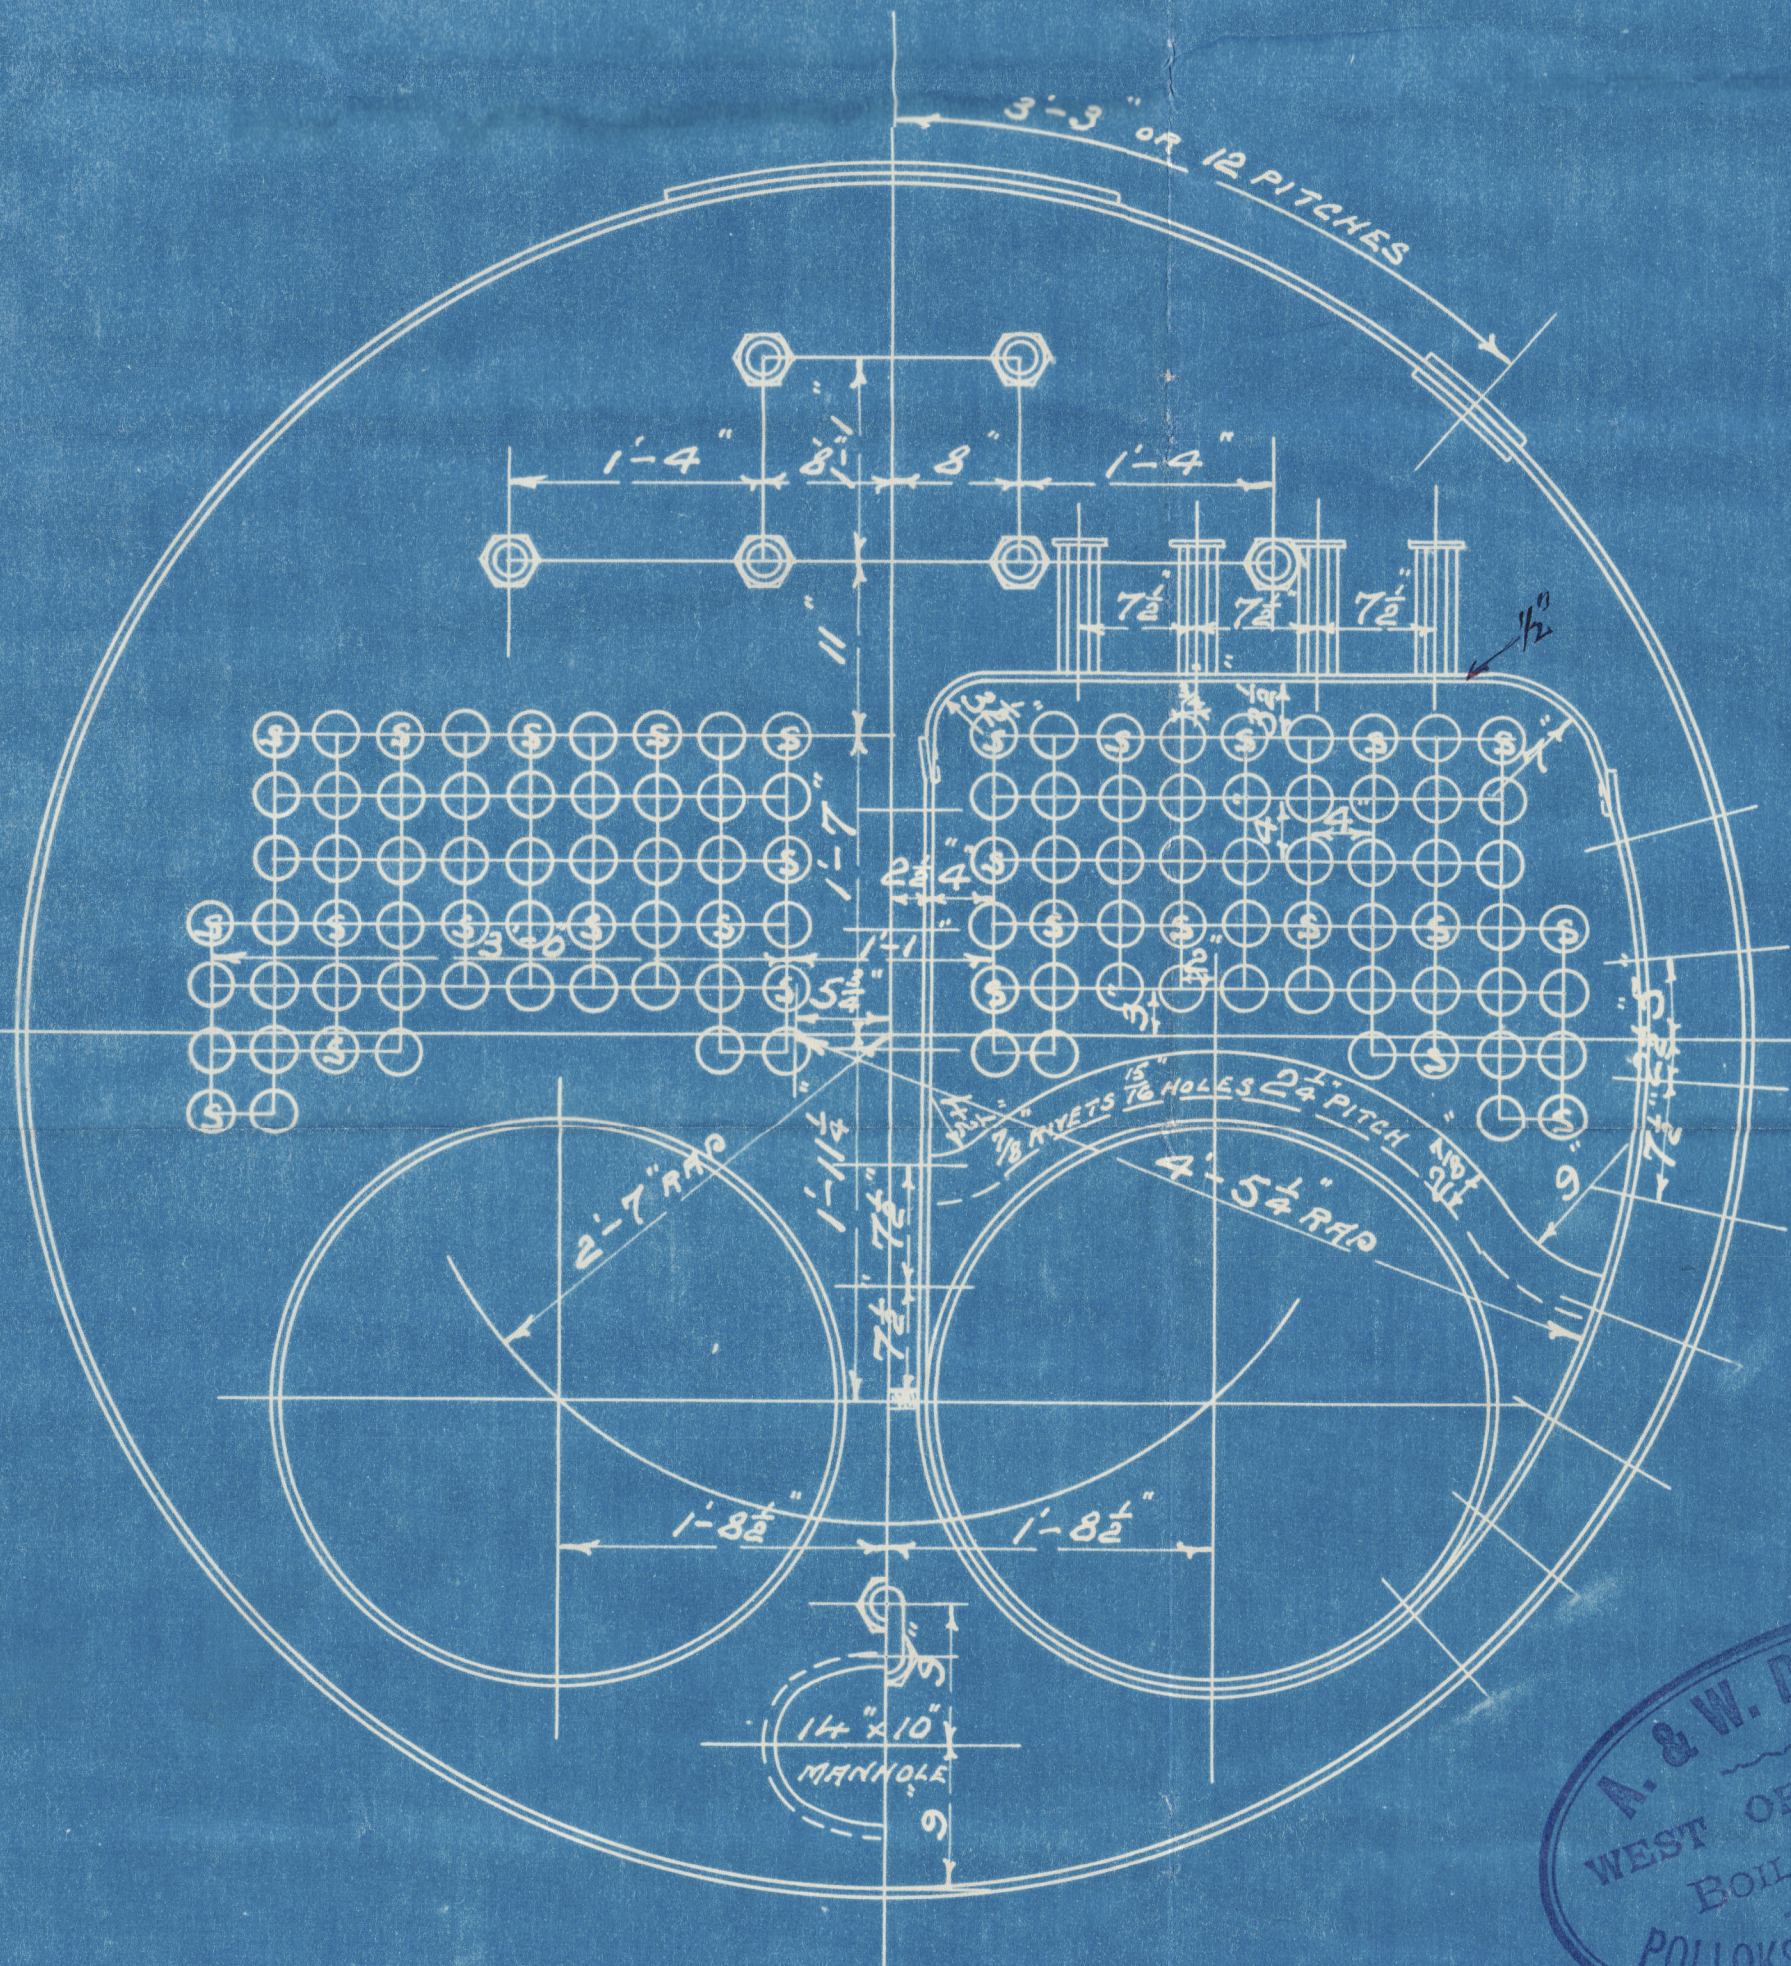


27: 5: 05.


J. L. 24/5/05

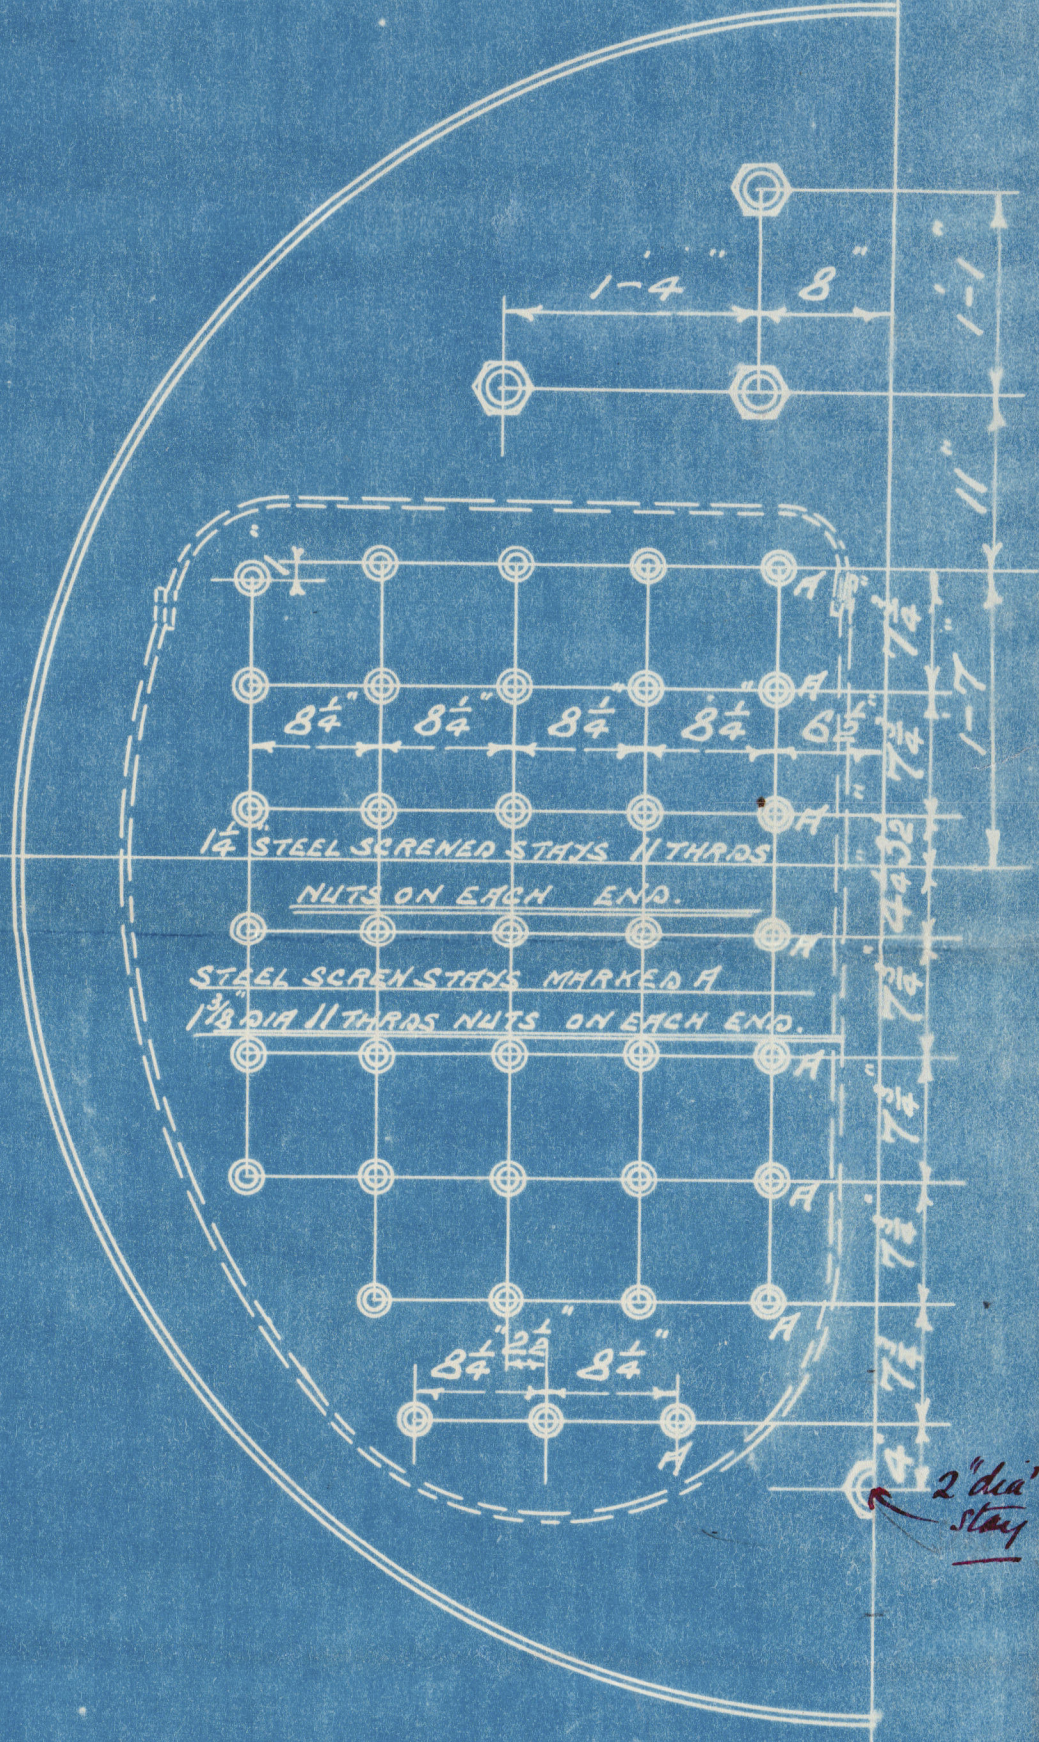

A. & W. DALGLISH  
WEST OF SCOTLAND  
BOILER WORKS  
POLLOKSHAW, GLASGOW.

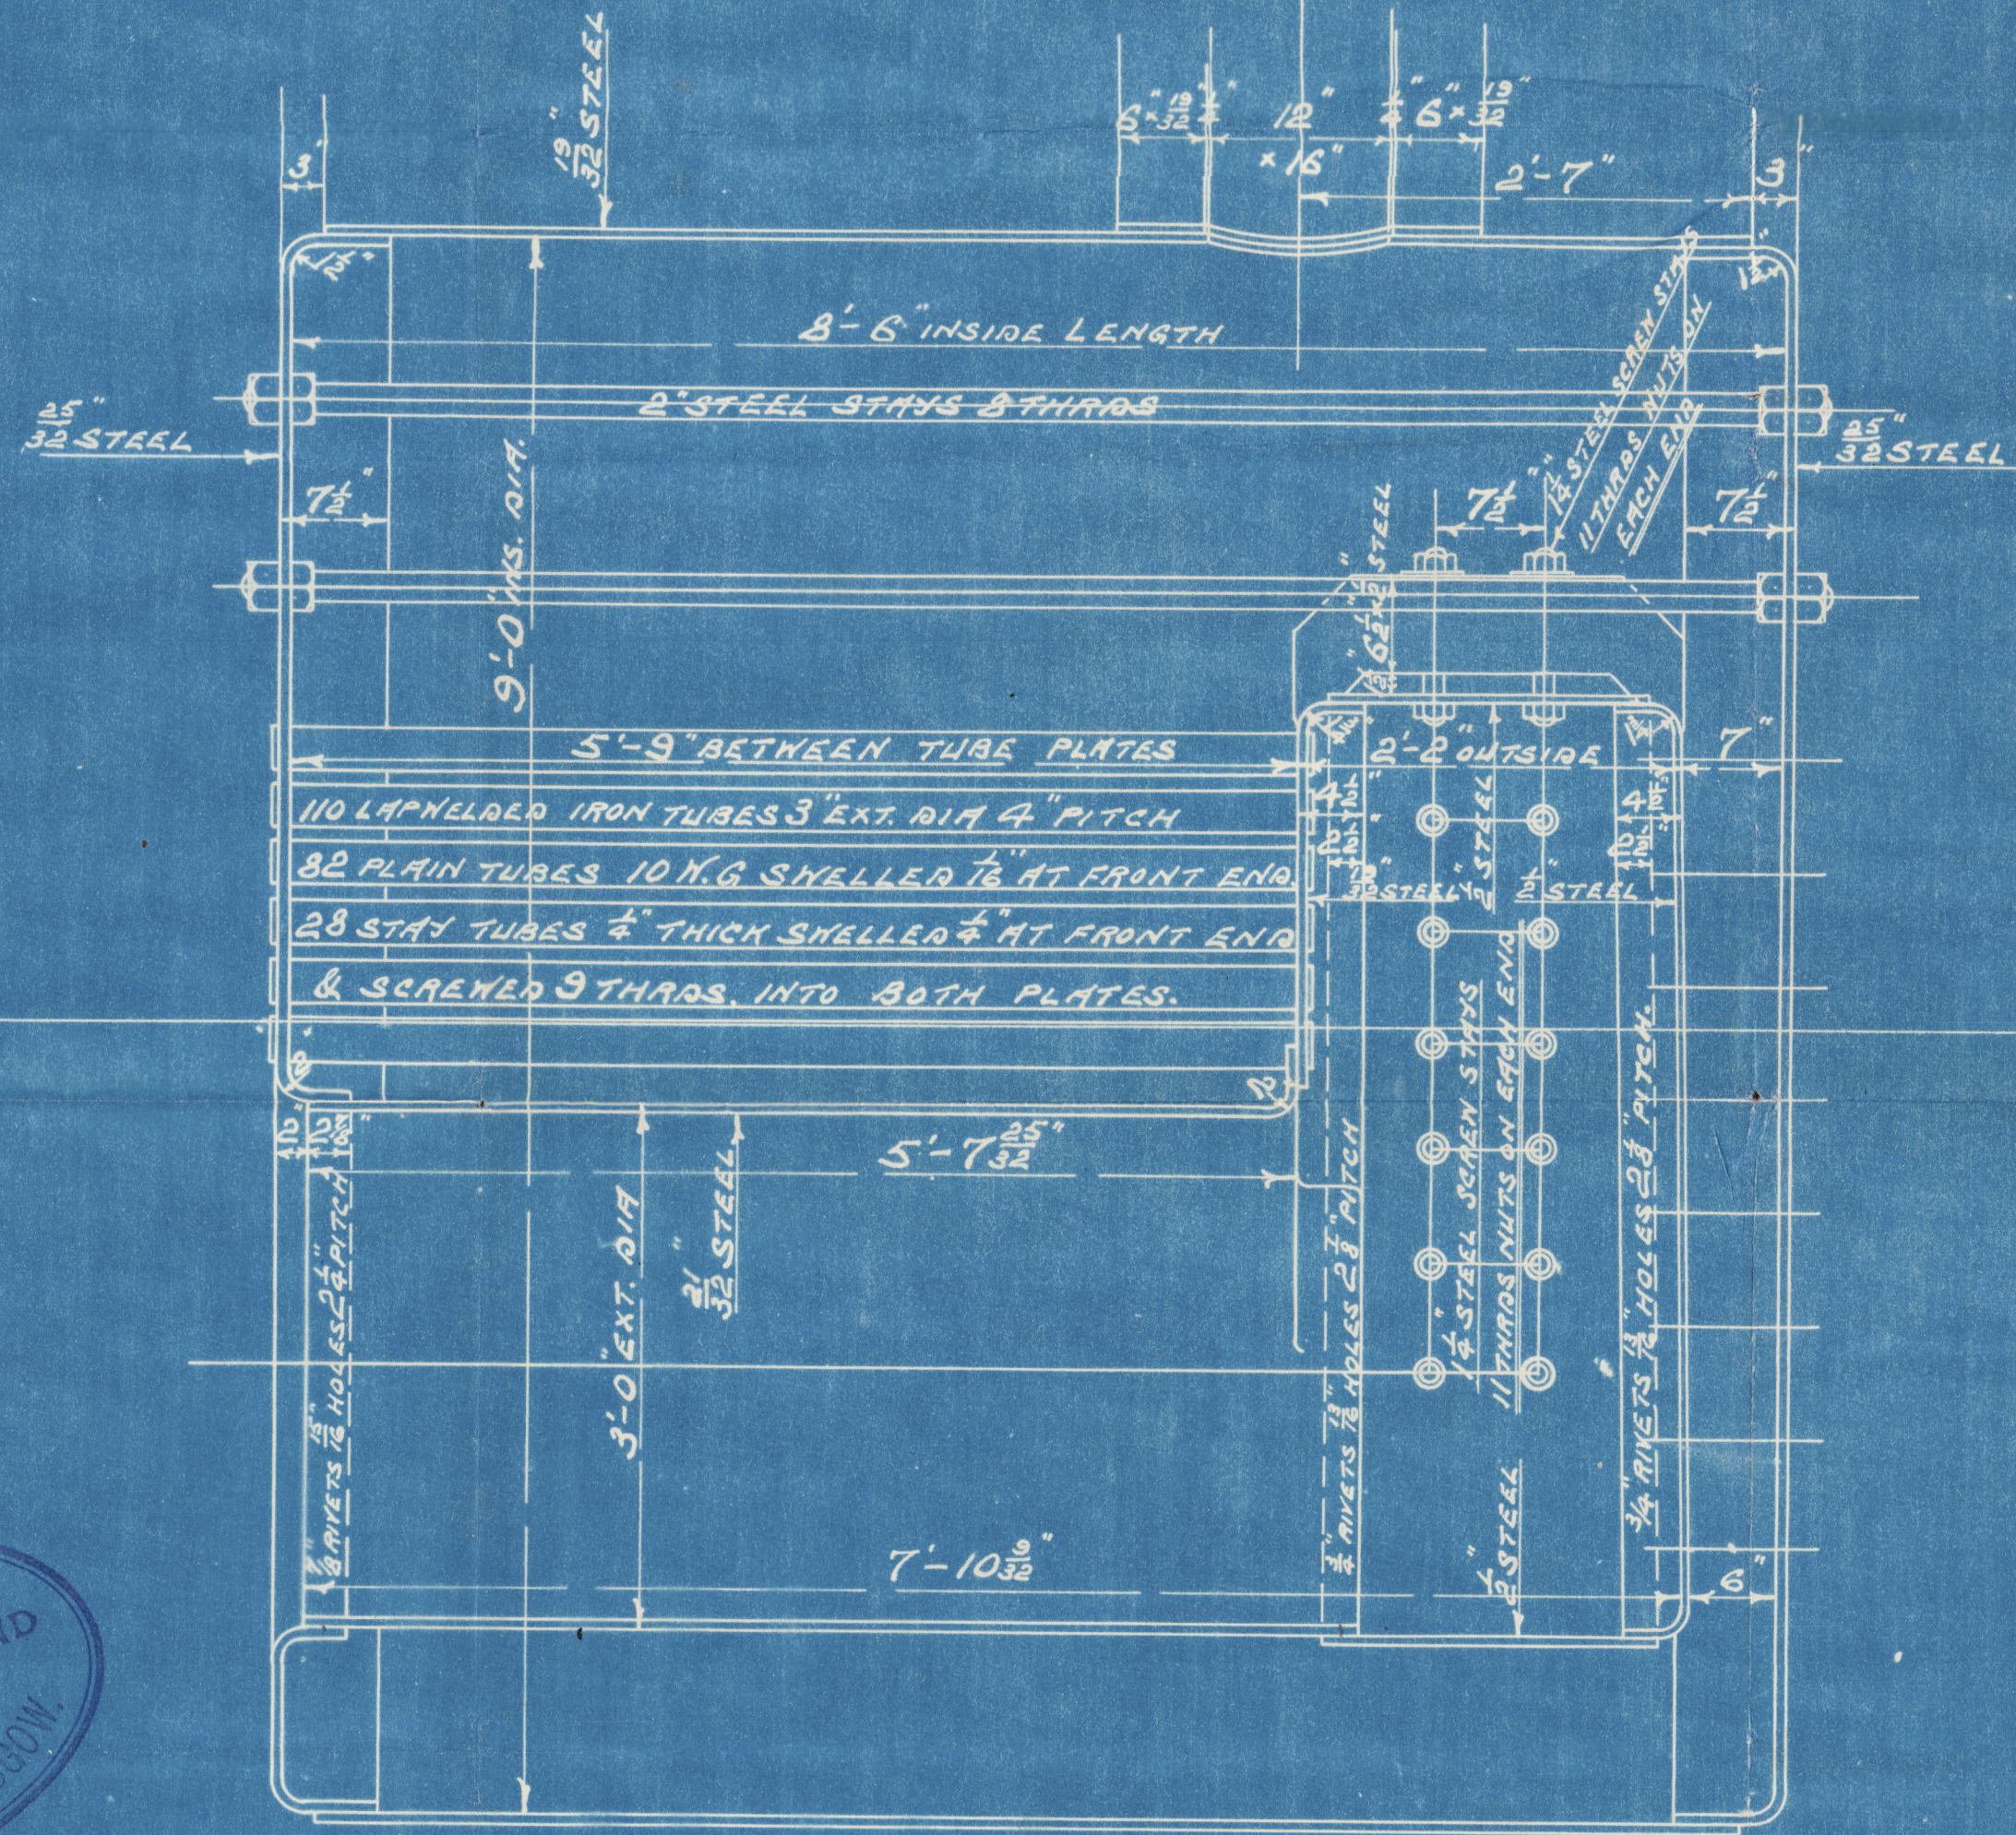

— MARINE BOILER —  
— 9'-0" INS. DIA. x 8'-6" LONG FOR 120 LBS W.P. —  
— UNDER LLOYD'S SURVEY. —  
— SCALE 1" = 1 FOOT. —


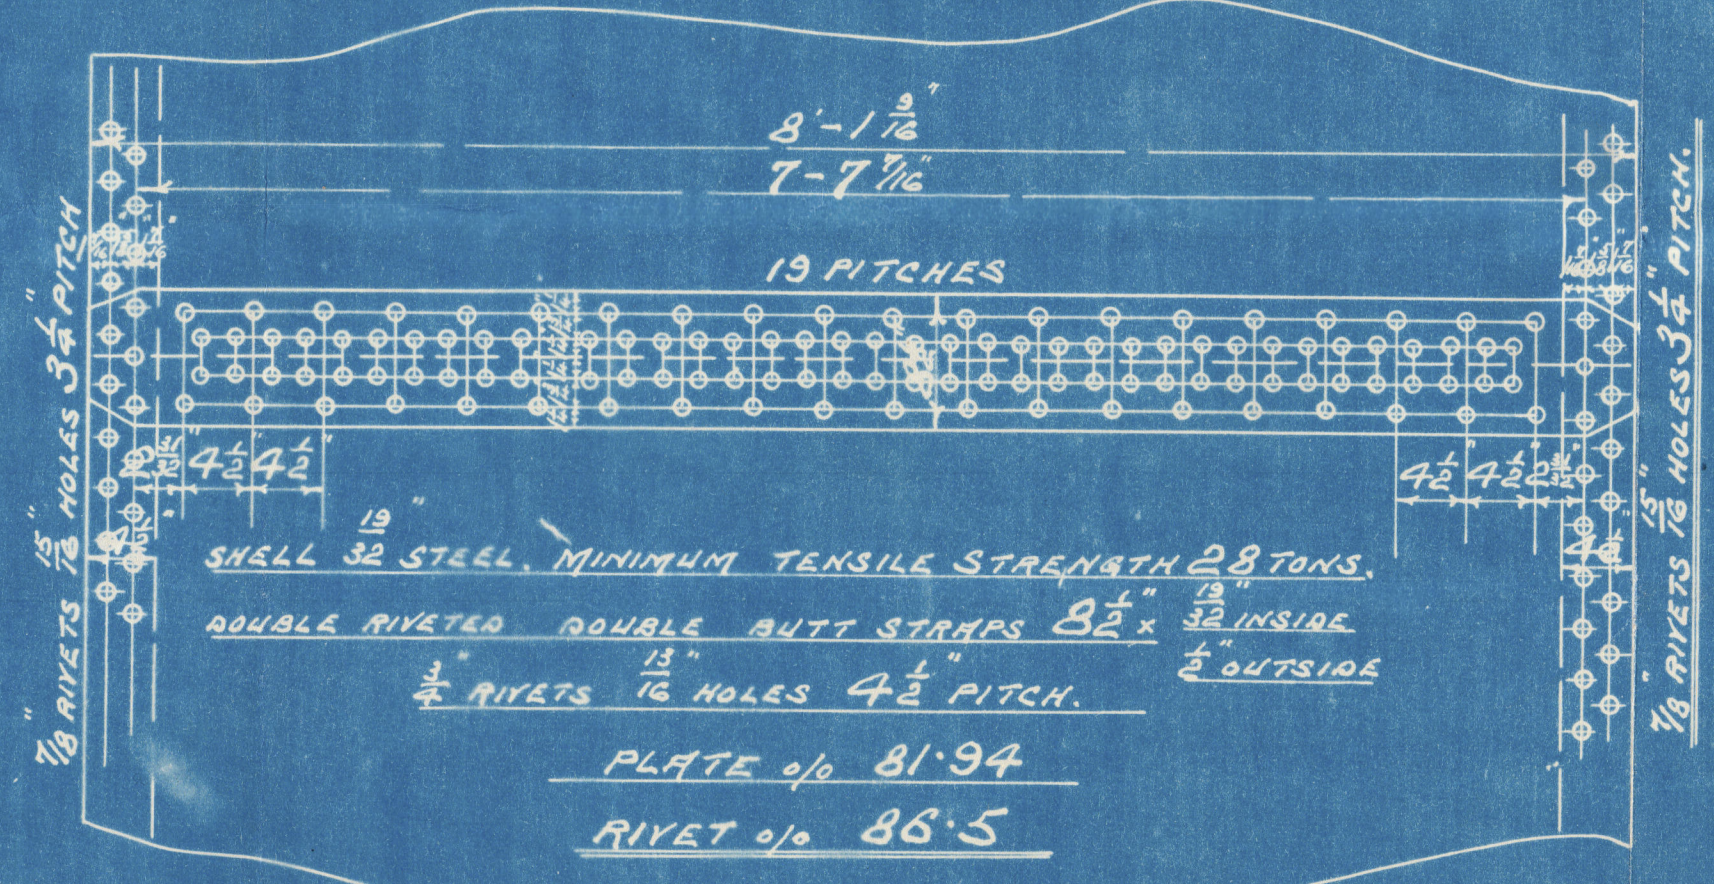


HEATING SURFACE ON TUBES	4967 #
" " " FURNACES	541 #
" " " CHAMBERS	954 #
TOTAL	6462 #
GRATE AREA 4'-9" BARS	27.5 #
RATIO G.A. TO H.S.	1:23.4
AREA THRO' TUBES	"

25/6/05  
26.5.05  
26.5.05  
BOILER N<sup>o</sup> 240.  
W419-0188  
Lloyd's Register  
Foundation



(Book)  
Marine Boiler No 240  
9'-0" dia x 8'-6" long  
for 120 lbs W.P.  
Under Lloyd's Survey.  
S. J. Hamilton  
Genl. Mgr. No 240

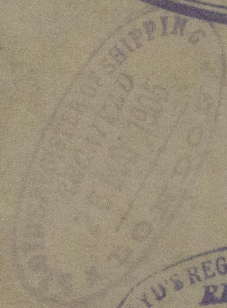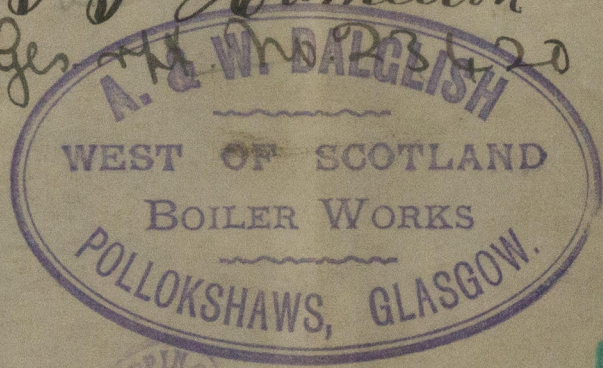

RETAIN



© 2019

Lloyd's Register  
Foundation

W419-0188