



ITEM.	Nº 14 W.T.	Nº 40 W.T.	Nº 65 W.T.	Nº 86 W.T.	Nº 93 W.T.	Nº 116 W.T.	Nº 152 W.T.

# — PROFILE & DECK PLANS. —

— S. S. N° 248. —

DIMENSIONS — 338' 0" B.P. x 48' 0" BREADTH EXT. 25' 6" DEPTH M.D.

SCALE 1/8" = 1 FOOT.

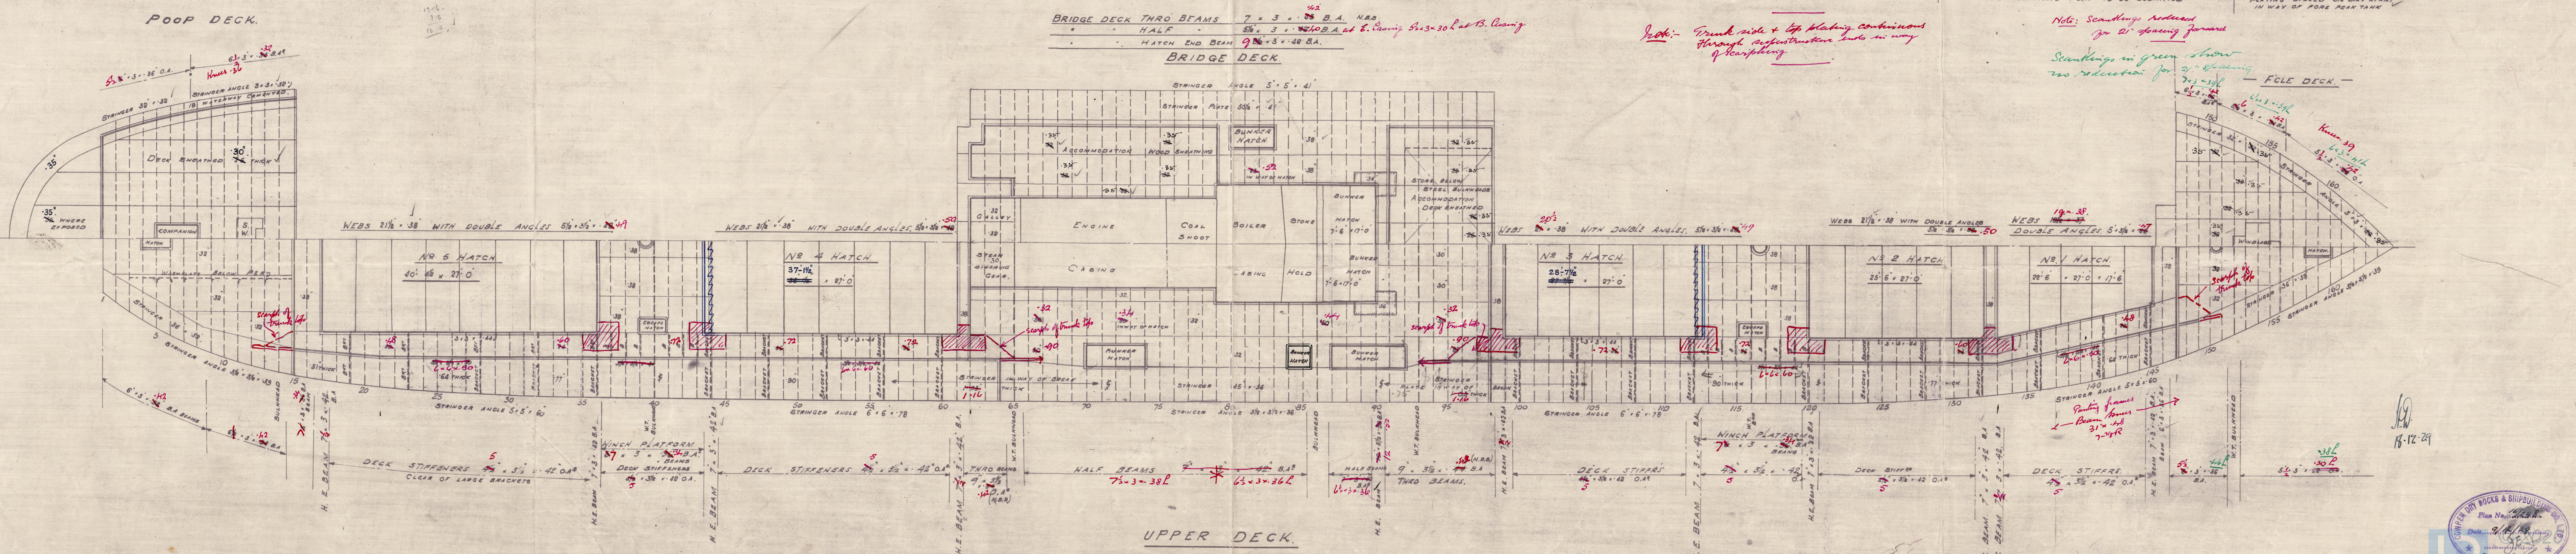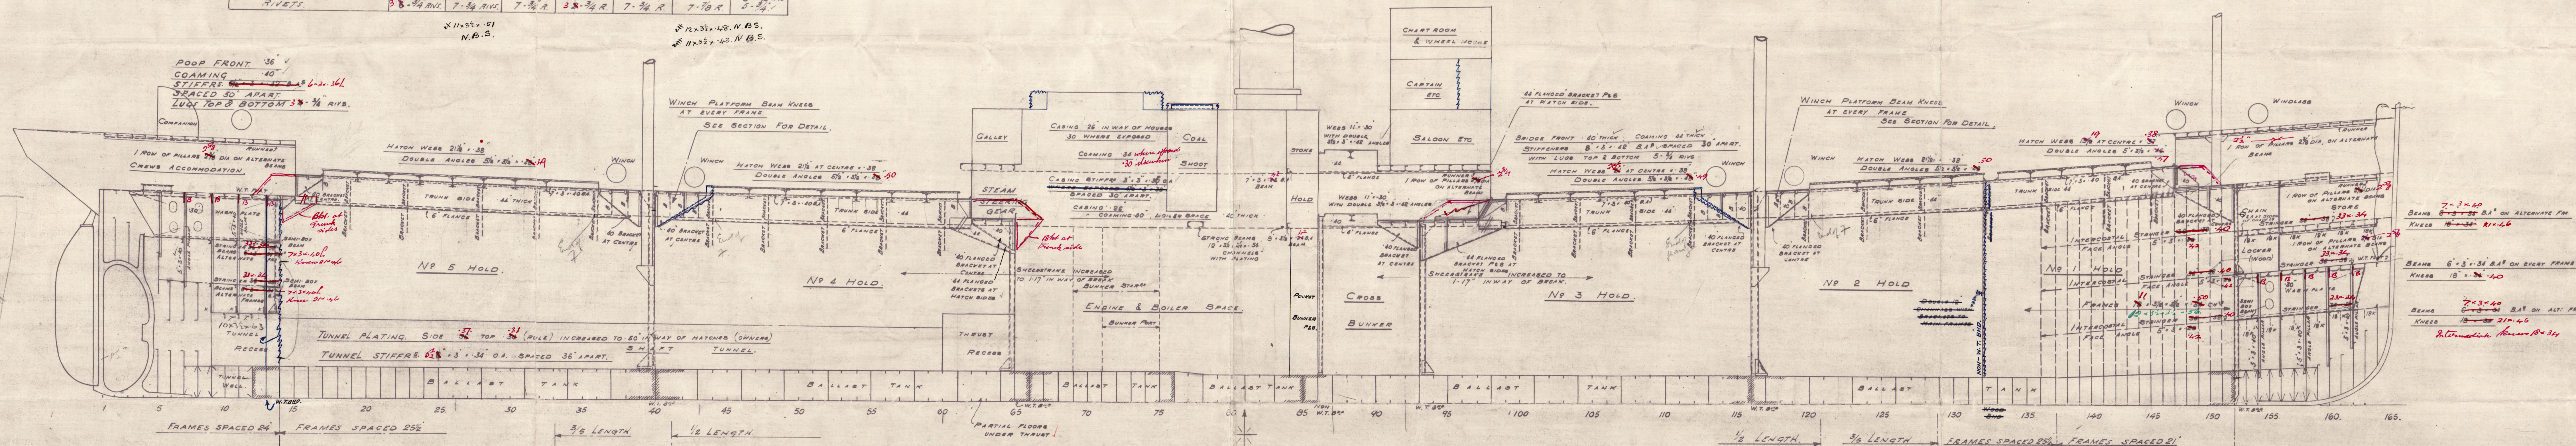



(2)

Cowper. S. B. Co. L<sup>d</sup>

No. 248.

Profile & decks.

---

S.S. "HOLMSIDE".  
NEWCASTLE ON TYNE.

Report No. 86043

---

W42-0065



© 2020

Lloyd's Register  
Foundation