

STEEL TANK STEAMER
TO CARRY
50000-42 GAL BARRELS OF OIL AT 7 LBS PER GAL
FOR THE
HUASTECA PETROLEUM CO LOS ANGELES, CAL
Scale 1/4" = 1'-0"
JULY 23-1911
MATTESON & DRAKE
17 BATTERY PLACE, NEW YORK
NAVAL ARCHITECTS

Copy
approved
Branch


7.10.11

SHEET 15

42-0102

N^o 125
Profile & Deck Plans (Approved)
New York SBL Co
E. P. Guilford

PHILADELPHIA. 1965

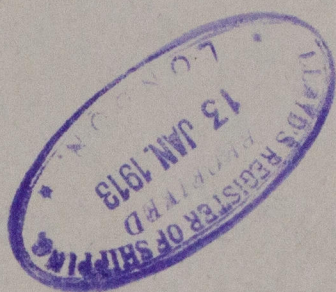

W42-0108



© 2020

Lloyd's Register
Foundation