

NOTE. FOR GIRDERS & REINFORCED HATCH END BEAM
SEE SEPARATE PLAN

STIFFENING UNDER WINDLASS & WINCHES
TO SURVEYOR'S SATISFACTION

Hawthorn Leslie & Co

(2)

S/S No 585

S/S No 585 (Except for tanks C.D.B.)
See Ser. Letters.

Amended Profile & deck Plans

S.S. Harpalion
NEWCASTLE ON TYNE.



Report No. 88674.

SS "HARLES DEN"

NEWCASTLE ON TYNE.

Report No. 88955.

W42-0134



© 2020

Lloyd's Register

Man
pk overlap
Gr Blue stuff under 108

1961


Went to
Lloyd's

W42 -0134



© 2020

Lloyd's Register
Foundation

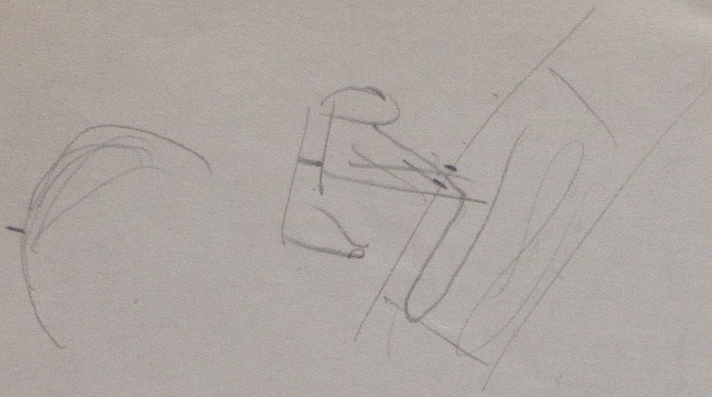

W42-0134



© 2020

Lloyd's Register
Foundation