

PASSENGER AND CARGO MOTORSHIP TO CLASS LLOYD'S REG. 100A1 ✚

COMPLETE SUPERSTRUCTURE VESSEL WITH FREEBOARD. FIXED DRAFT 8.685 m. (28'-6")

DIMENSIONS: 142.40 · 19.51 · 12.2 METRES. (<sup>466'8"</sup>~~465'-0"~~ · 64'-0" · 40'-0")

LENGTH OF CRUISER STERN,  $6.50 + 141.73 = 148.23 \cdot 96\% = 142.40$  METRES

## SCANTLING NUMERALS

$$\begin{array}{l} L \cdot D \quad 14240 \cdot 12.2 = 17376 \\ L \cdot (B \cdot D) \quad 14240 \cdot (19.51 \cdot 12.2) = 45142 \\ L \cdot D \quad 14240 / 12.2 = 1165 \\ d \quad 9.450 \div 1.200 = 8.250 \end{array}$$

## EQUIPMENT NUMERALS.

2<sup>ND</sup> NUMERALS L. (B + D) = ~~4494~~ <sup>4312</sup>

BRIDGE AND FORECASTLE = 210

DECKHOUSES = 183


## EQUIPMENTS:

2 OFF STEELLESS ANCHOR EACH 4570 KG } COL WEIGHT 13080 KG.  
1 " " " 3940 " }  
1 " STEERN ANCHOR 1345 " ELEG STOCK 25% FOR STOCK  
530 M 44.5 M SHD CHAIN CABLES MIN WEIGHT 52580 KG  
230 M 127 M STEEL WIRE FOR STEERN ANCHOR 6 - 24 SPECIAL FLEXIBLE  
220 M 140 " " " TOWLINE 6 - 24 " "  
4 OFF 135 A 209 M MANILLA HAWKERS AND WINKS  
OR 70 M STEEL WIRE 6-18 FLEXIBLE

APPROVED ELECTRODES TO BE USED WHERE  
ELECTRIC WELDING EMPLOYED OWNERS  
CONSENT OBTAINED.



RETAIN

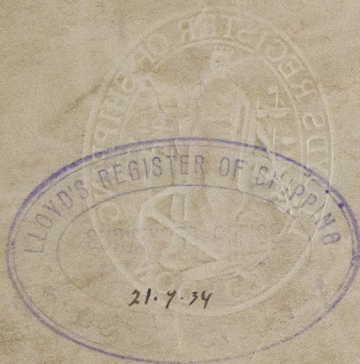

Naksoy Yard. No 62.

Midship. Section. ✓

M/ "Canada."

Gen. Rpt. No 9683

RETAIN



© 2019

Lloyd's Register  
Foundation